


Steil Surveying Services, LLC

1102 West 19th Street P.O. BOX 2073

Cheyenne, Wyoming 82001

PRODUCTION FACILITY ACCESS ROAD MAP
FOR THE PROPOSED GUTTERSEN D25-17 WELL

SECTION 25
TOWNSHIP 3 NORTH
RANGE 64 WEST

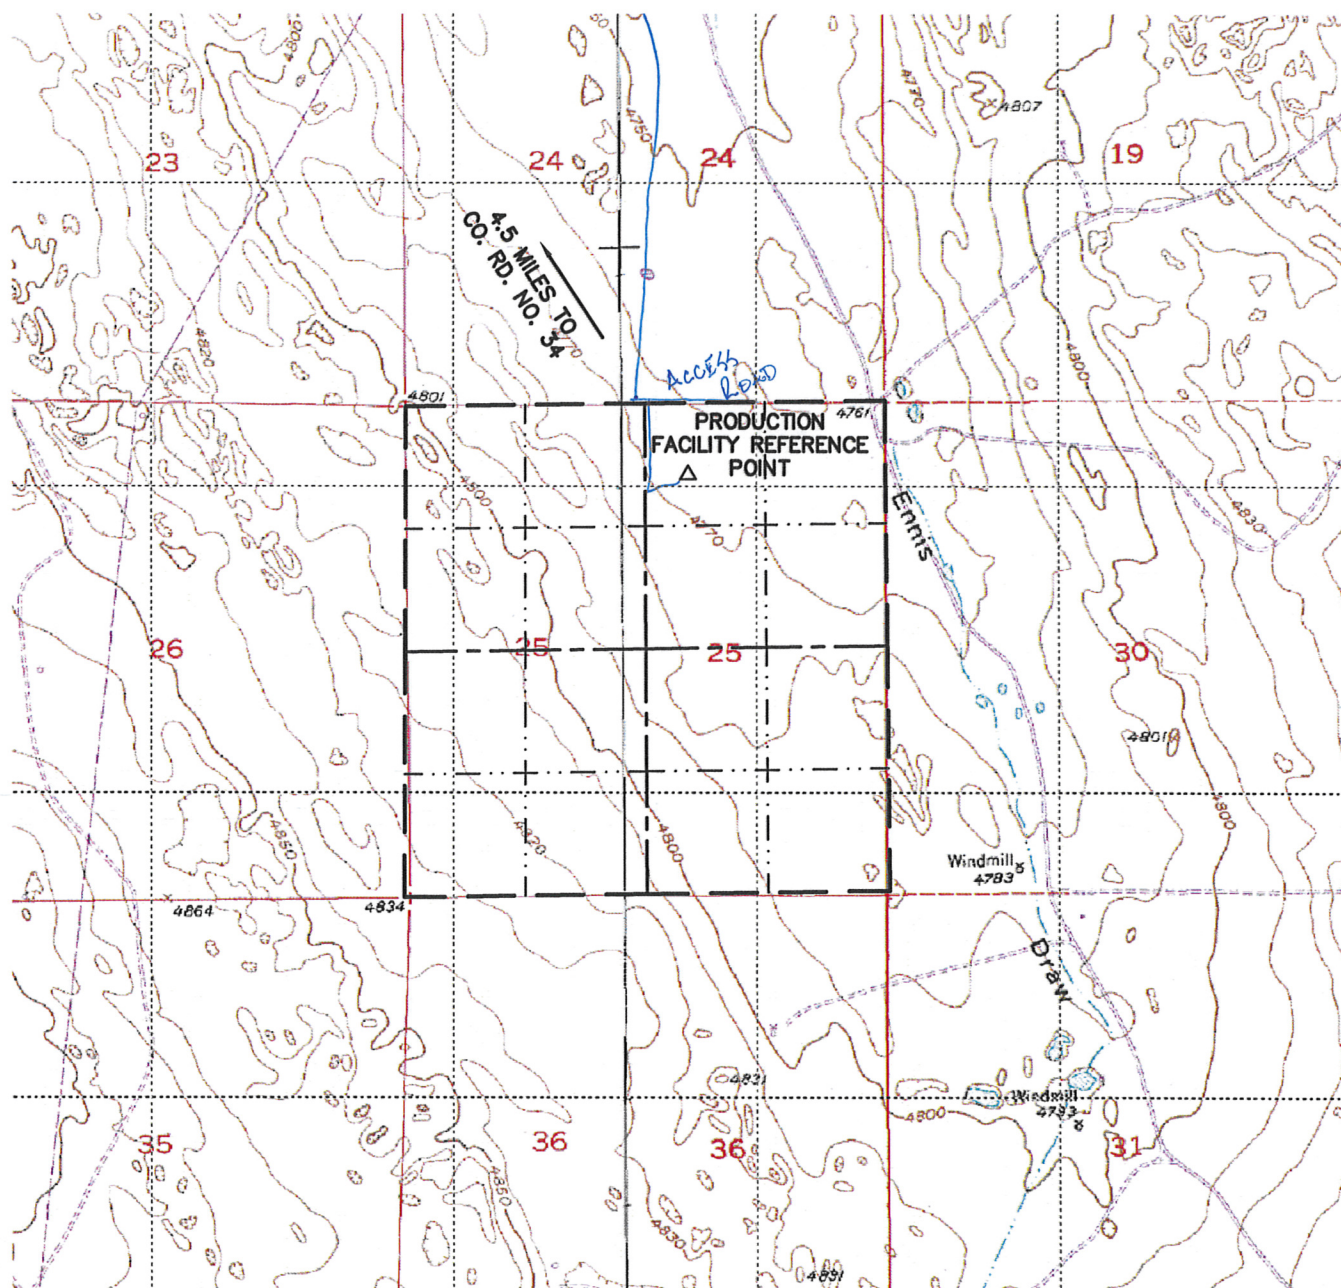

0 2000

Scale: 1" = 2000'