


PRODUCTION FACILITY LOCATION DRAWING

DINNER PC E14-65HN

SECTION: 14
TOWNSHIP: 6N
RANGE: 65W

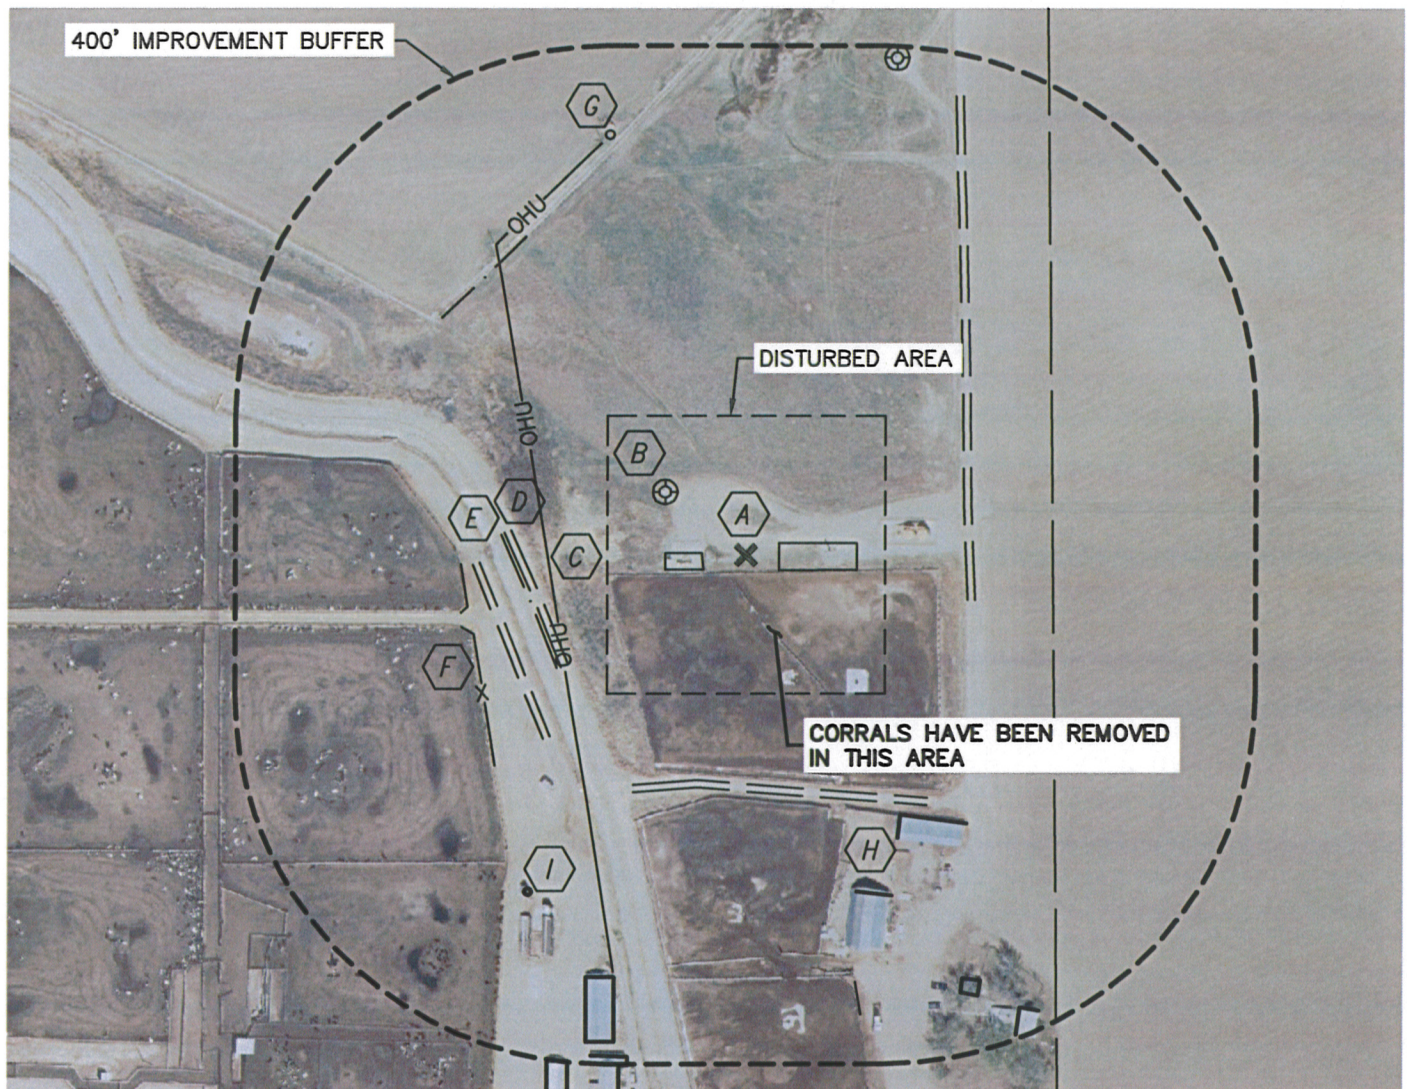

REFERENCE POINT LOCATION:

LATITUDE: 40.48051°N
LONGITUDE: 104.63646°W
ELEV: 4717'
PDOP: 1.3
DATE: 3/17/11
OPERATOR: ADAM KELLY
1/41/4: SW1/4SW1/4
FSL: 628'
FWL: 1004'
DISTANCE TO WELL: 1887'
ASSOCIATED NEW WELLS:
DINNER PC E14-65HN
ASSOCIATED EXISTING WELLS:
DINNER 14-1, 14-31, 14-32,
14-34, 14-35


IMPROVEMENTS:

- A** EX. PRODUCTION FACILITY 47' W, 35' E
- B** EX. DINNER 1 111' NW, DINNER 14-35 561' NE
- C** OVERHEAD UTILITY 211' W
- D** FIELD ROAD 222', 269' SW, 237' E, 246' S
- E** DITCH 234' SW, 412' NW
- F** FENCE 305' SW
- G** IRRIGATION PUMP HOUSE 478' NW
- H** BUILDING 327', 383', 514', 573' SE, 478', 557', 580' SW
- I** WATER TANK 432' SW

LEGEND

X - REFERENCE POINT
ALL DISTANCES ARE APPROXIMATE.

NEAREST: BUILDING 327' SE,
PUBLIC ROAD 624' S (HWY 392), ABOVE GROUND UTILITY 211' W,
RAILROAD 5280'+ SE, PROPERTY LINE 628' S

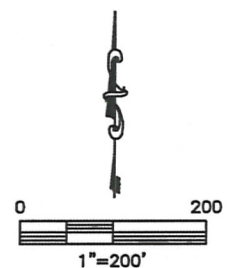

PROJECT#: 2011067