


LOCATION DRAWING

VARRA P31-74HN, VARRA P31-76HN

SECTION: 31
TOWNSHIP: 3N
RANGE: 67W

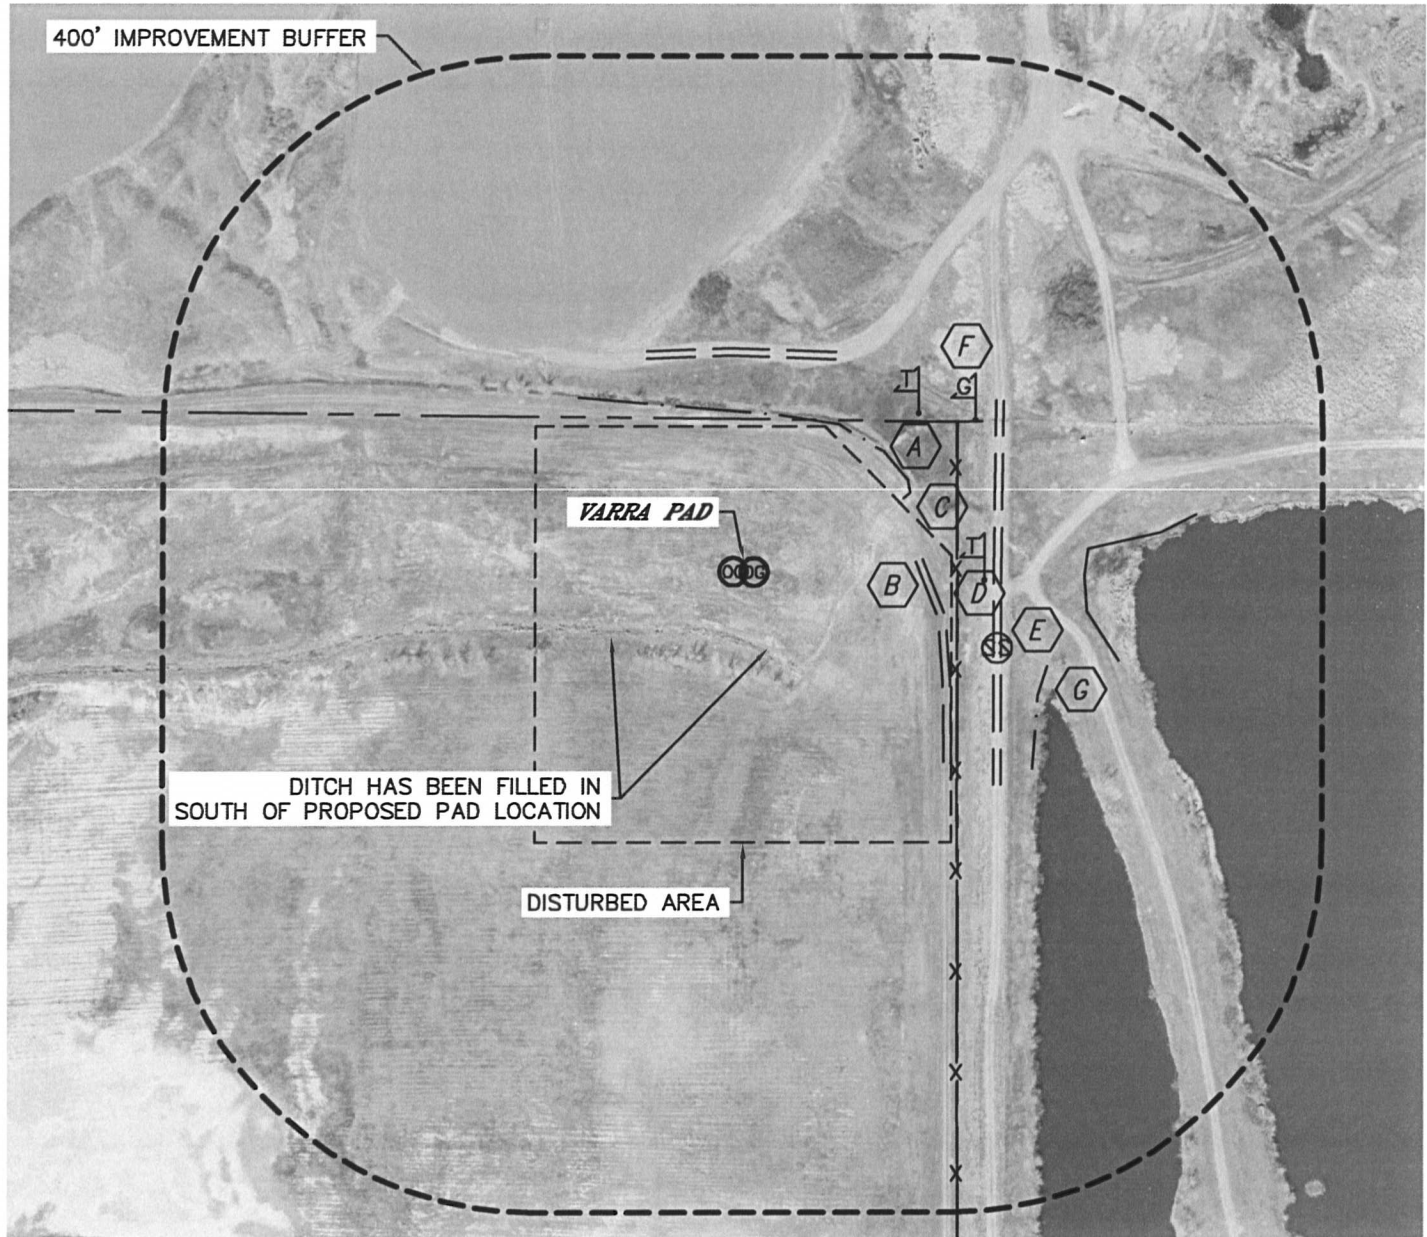

IMPROVEMENTS:

(MEASURED FROM THE VARRA P31-74HN LOCATION)

- | | | | |
|----------|---------------------------------------|----------|-------------------------|
| A | DITCH 184' NE | F | GAS LINE MARKER 290' NE |
| B | FIELD ROAD 175' E, 259' E, 233' N | G | POND 333' SE, 357' E |
| C | FENCE 219' E | | |
| D | TELEPHONE LINE MARKER 249' E, 247' NE | | |
| E | SANITARY SEWER MANHOLE 276' SE | | |

NEAREST: BUILDING 1845' NW, PUBLIC ROAD 2300' W (CR 13),
ABOVE GROUND UTILITY 2236' W, RAILROAD 5150' SE, PROPERTY LINE 165' N

