

**GREAT WESTERN OIL & GAS COMPANY**  
**Well Name: Great Western 25-22**  
**NWSW Sec 25 T6N R67W 6th**  
**Weld County, CO**  
**WELLSBORE SCHEMATIC - as of March 6, 2011**

API: 05-123-31722-00

GL Elev: 4751'


KB Elev: 4767'

Spud Date: 2/22/2011

**Surface Casing :**

2/22/2011: 8-5/8" 24# 13 jnts set @ 493'

Cmt w/ 410 sx

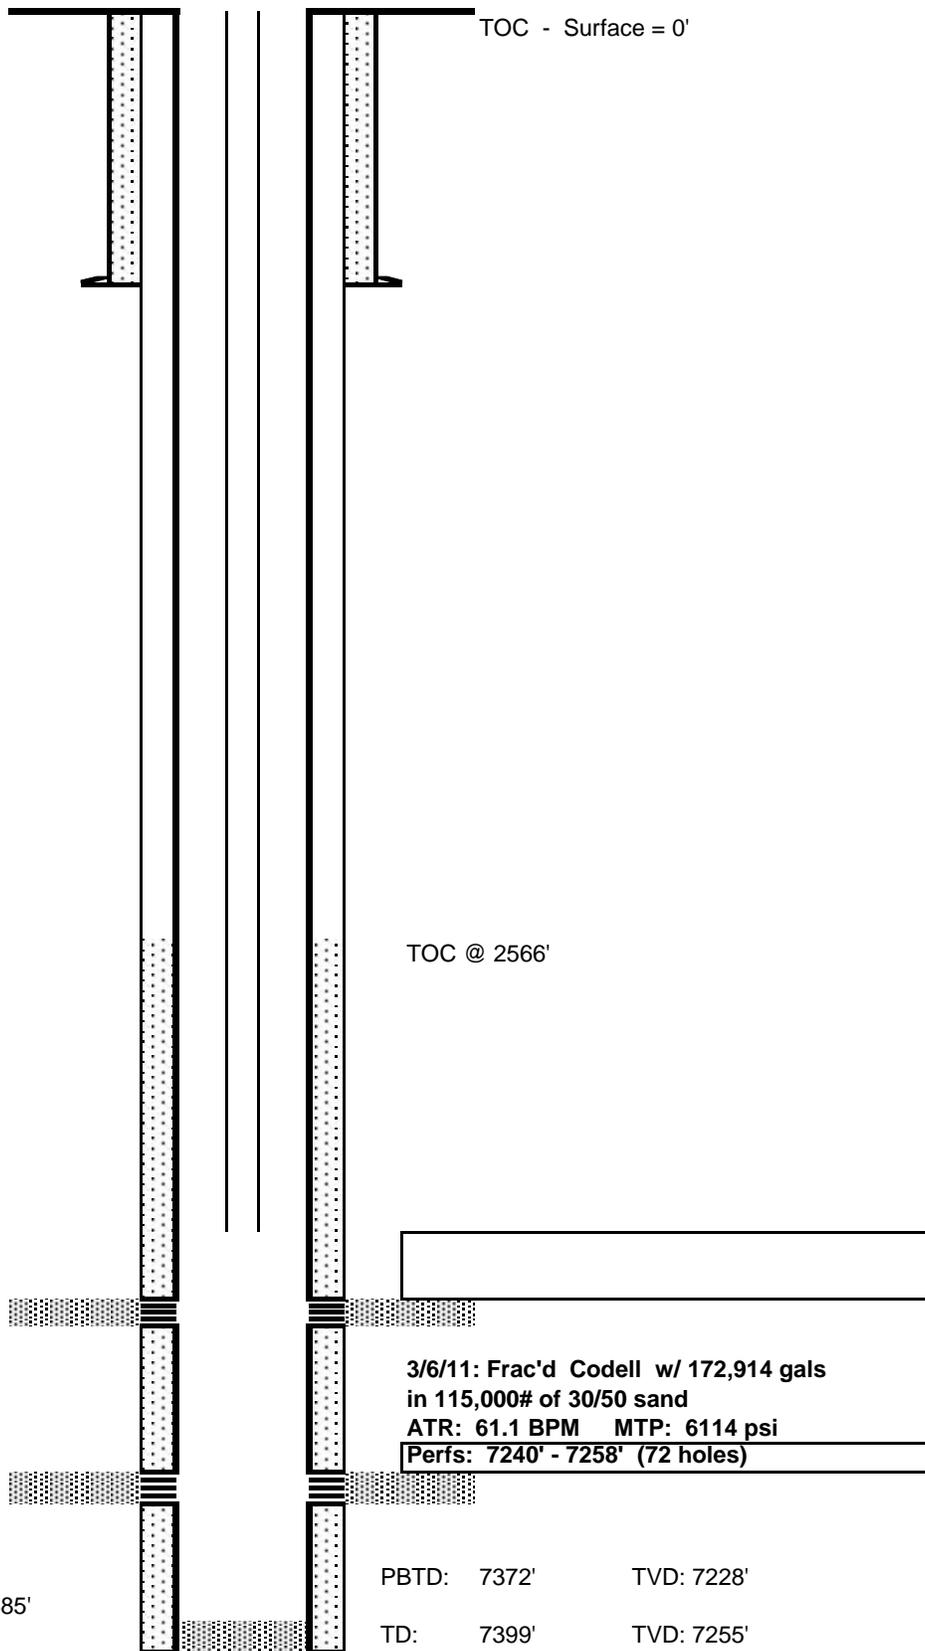

**Tubing Detail:**

**Production Casing :**

2/27/2011: 4-1/2", 11.6# 164 jnts set @ 7385'

Cmt'd w/ 515 sx

PBTD: 7372'

TVD: 7228'

TD: 7399'

TVD: 7255'