

GREAT WESTERN OIL & GAS COMPANY
Well Name: Great Western 25-52
NWSW Sec 25 T6N R67W 6th
Weld County, CO
WELLBORE SCHEMATIC - as of March 6, 2011

API: 05-123-31721-00

GL Elev: 4751'


KB Elev: 4767'

Spud Date: 2/16/2011

Surface Casing :

2/17/2011: 8-5/8" 24# 11 jnts set @ 494'

Cmt w/ 410 sx

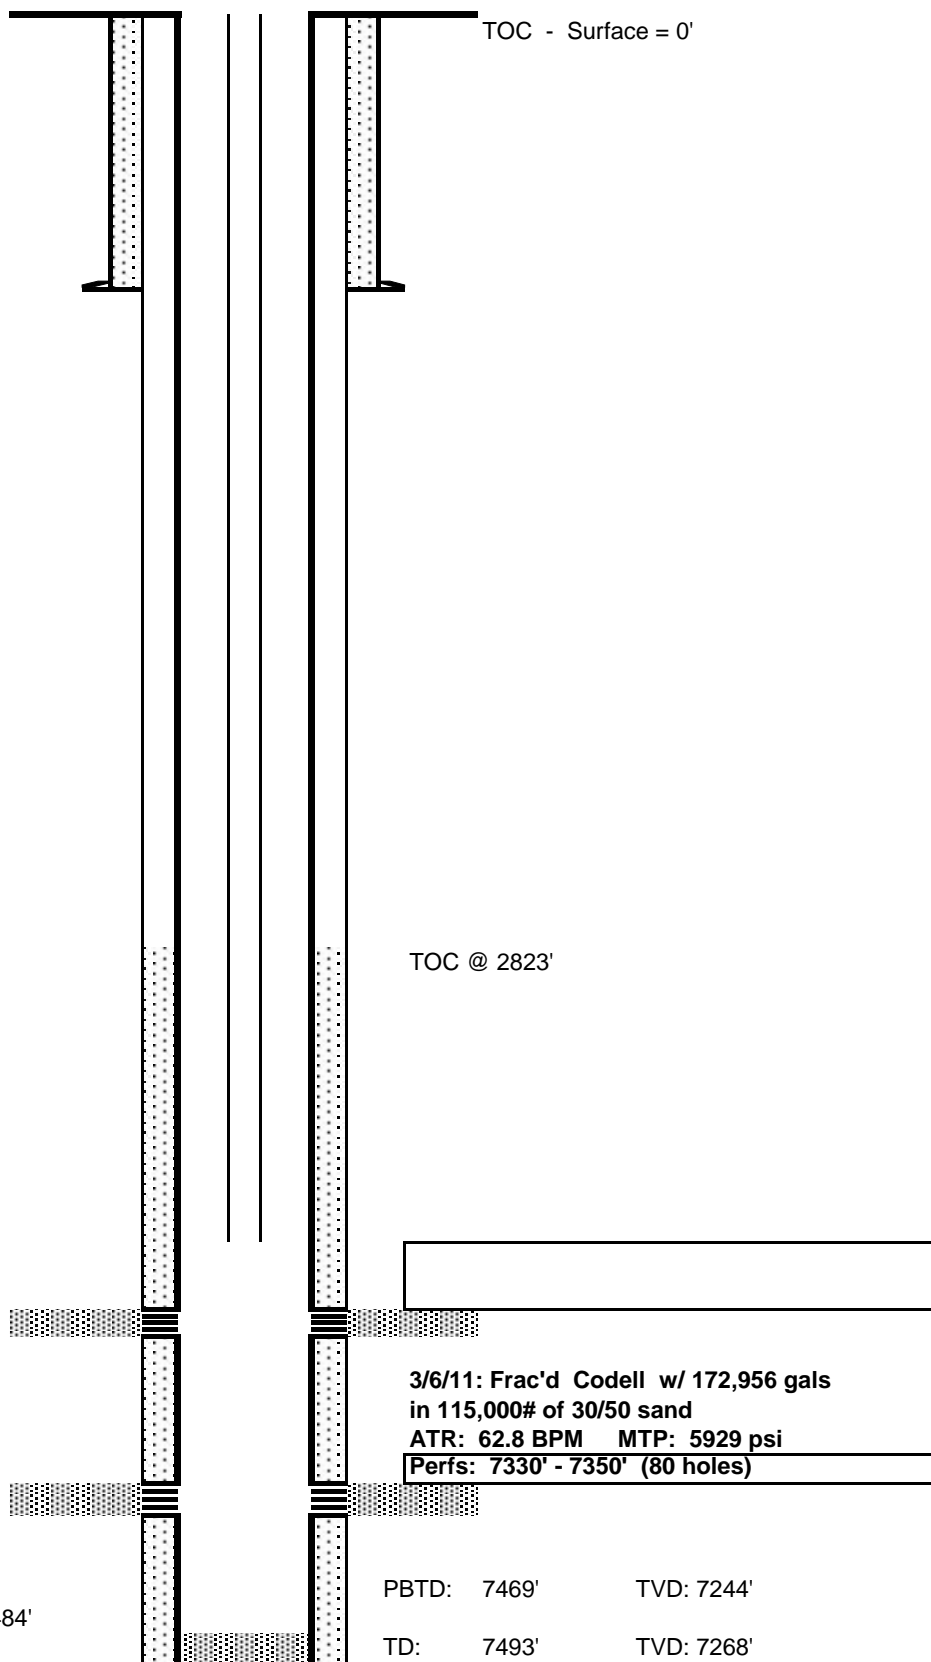

Tubing Detail:

Production Casing :

2/20/2011: 4-1/2", 11.6# 167 jnts set @ 7484'

Cmt'd w/ 520 sx