

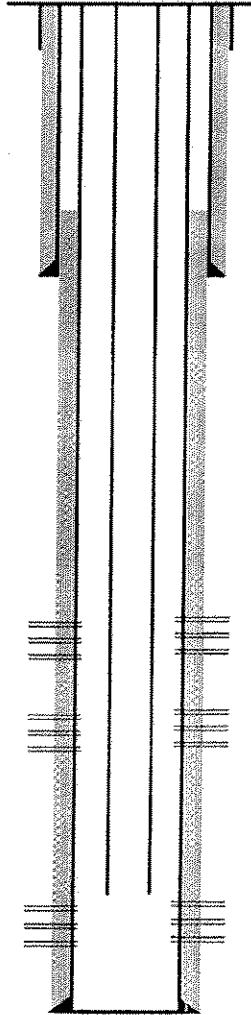
Well : SEGAL 4-0-24
 Field : HAMBERT
 County : WELD COUNTY State : Colorado
 Surface : 1326' FNL, 2661' FWL, SENW Sec 24-T4N-R66W

Grd Elev : 4723' GR

KB Elev : 4736' KB

Log Tops:

Sussex 4508'
 Niobrara 7076'
 Codell 7372'
 J Sand 7840'

Well History:

Spud 01-08-2011
 TD 01-13-2011

Surface Casing and Cement

8-5/8", Set @ 793'
 Cemented with 350 sxs

Production Casing and Cement

4-1/2" production casing set @ 7996'
 Cemented with 640 sx

CBP

Set @ 6400' 03-09-11
 Drilled out on 03-10-11

Perf'd the Niobrara from 7076' - 7096', 7180' - 7200' @ 4 spf
 Niobrara 7076' - 7096', 7180' - 7200' (160 holes), w/ 132,812
 gals 18 # Vistar Hybrid cross linked gel containing 251,100#
 30/50 sand. 01-27-11

CBP

Set @ 7240' 01-27-11
 Drilled out on 03-10-11

Perf'd the Codell from 7372' - 7388' @ 2 spf
 Perf'd the Niobrara from 7266' - 7276' @ 4 spf
 Frac'd the Codell 7372' - 7388' @ 2 SPF, Niobrara "C"
 7266' - 7276' (72 holes) w/110,292 gal 22 # Vistar
 Hybrid cross linked gel containing 250,060 # 30/50 sand.
 01-27-11

CBP

Set @ 7500' 01-27-11
 Drilled out on 03-10-11

Perf'd the J Sand from 7840' - 7860', 7874' - 7894' @ 2 spf
 Frac'd the J-Sand 7840'-7860', 7874' - 7894', (80 holes)
 w/153,569 gal 18# Vistar Hybrid cross linked gel containing
 251,020 # 20/40 Sand. 01-27-11

Production Tubing
 2-3/8", Set @ 7836'

TD 8010'

Drawn by:

Sheila Reed-High