


Attachment #2 – Current Wellbore Diagram

CURRENT WELLBORE DIAGRAM

Operator: Encana Oil & Gas (USA) Inc.
 Well Name: CATHEDRAL FEDERAL 20-1
 Lease Number: COC1633
 Unit Number: COC047803C
 Location: NWNW Sec 30-T3S-R101W
 Field: Cathedral
 County, State: Rio Blanco, CO
 API Number: 05-103-07813-0000
 Diagram Date: As of May 17, 2011

KB 6885 ft.
 GL 6875 ft.
 Surface csg. CMT to surface
 120 sks Class G

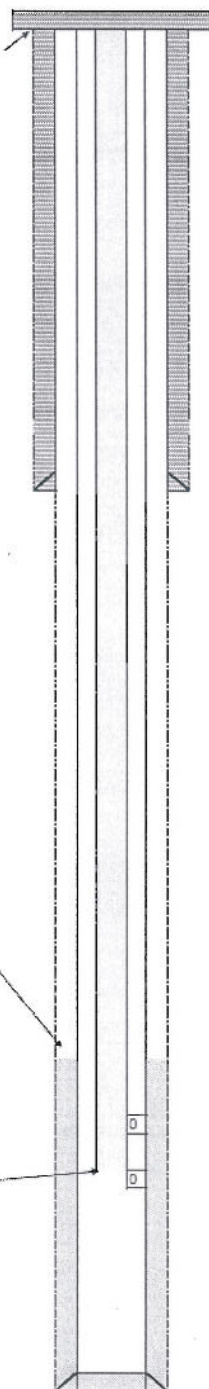

CASING RECORD

SIZE (in)	WT (lb/ft)	GRADE	Hole D(in)	TOP (ft)	BTM (ft)	Date Run
8 5/8	24	assumed J-55	12 1/4	0	158	
4 1/2	10.5	assumed J-55	7 7/8	0	3,128	

TUBING RECORD

SIZE (in)	WT (lb/ft)	GRADE	TOP (ft)	BTM (ft)	Date Run
2 1/16	3.25	assumed J-55	0	2,726	

JEWELRY RECORD

ITEM	MAKER	SIZE (in)	Max ID	TOP (ft)	Date Run

PERFORATION RECORD

ZONE	TOP (ft)	BTM (ft)	SPF	Holes	Date Shot
Emery	2889	2930		30	05/10/1976

COMMENTS/HISTORY:

05/04/1976 Re-run Bond Log. 1st Bond Log shows poor bonding characteristics
 05/05/1976 Perforated 4 holes at 2944'. Attempted to squeeze, FAILED.
 05/06/1976 Perforated 4 holes at 2904'. Squeezed 20 sks Class G CMT.
 05/07/1976 Tagged cement at 2802'. Drilled out to PBD @ 3084'.
 Ran CBL (unable to locate subsequent CBL)

TOC #/ CBL log @ 2350'
 First stage cement:
 125 sks 50-50 poz mix
 Second stage cement:
 25 sks Class G

EOT @ 2,726

PBD (ft): 3084
 TD (ft): 3128