


Project: Mesa  
 Site: NWNW Sec 24-T6S-R97W  
 Well: Puckett 11B-24D  
 Wellbore: DD  
 Design: DD





WELL DETAILS: Puckett 11B-24D

+N/-S	+E/-W	Northing	Ground Level:	8381.0	Longitude	Slot
0.0	0.0	1622961.18	Easting	2245699.87	Latitude	
				39.513331	-108.173967	

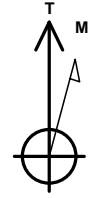

Azimuths to True North  
 Magnetic North: 10.53°  
 Magnetic Field  
 Strength: 52290.7snT  
 Dip Angle: 65.74°  
 Date: 2010/09/20  
 Model: IGRF2010-14

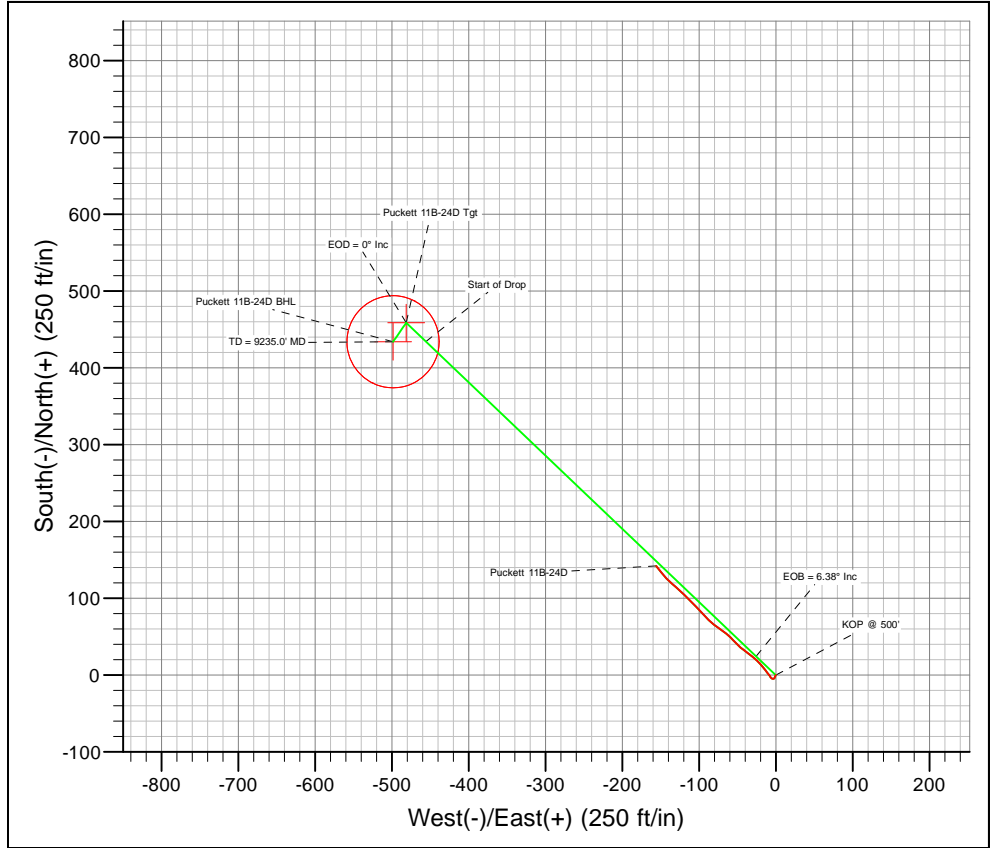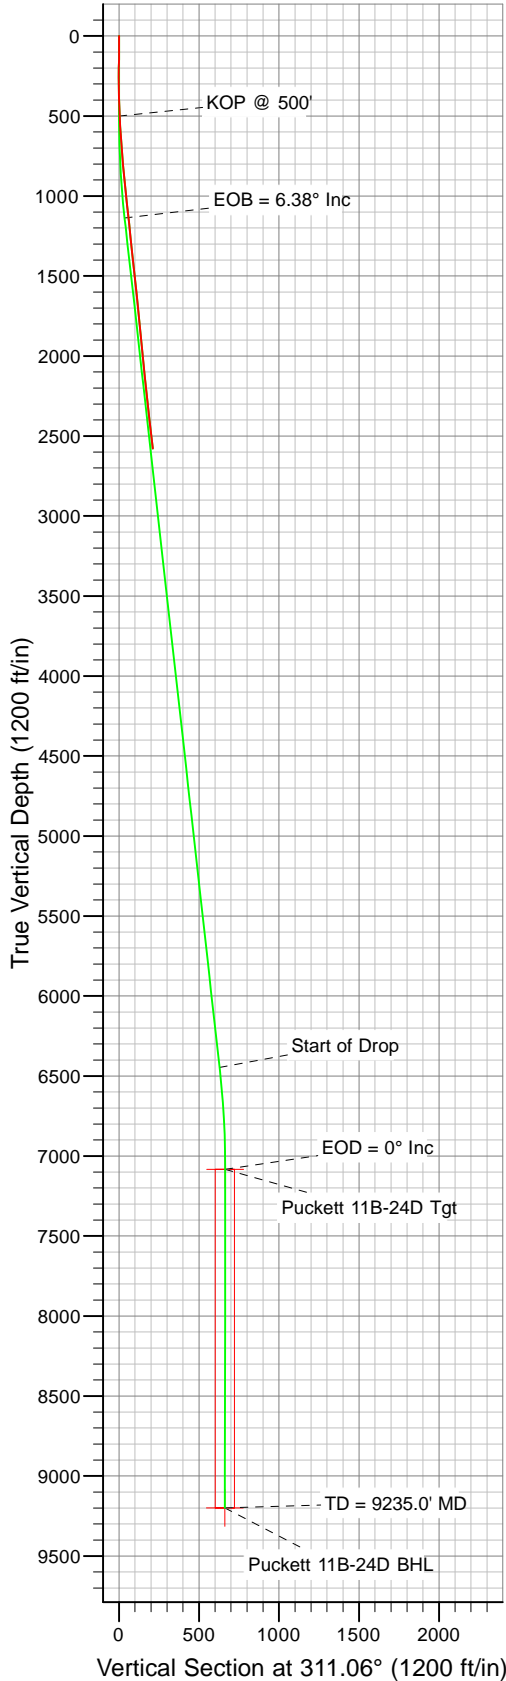

Survey: Surface (Puckett 11B-24D/DD)

Created By: Jon Schweigert	Date: 8:56, September 23 2010
Checked:	Date:
Reviewed:	Date:
Approved:	Date: