


-  = ALIQUOT MONUMENT AS DESCRIBED
 = CALCULATED POSITION

SITE SKETCH

TYE USX A15-03D

SECTION: 15
TOWNSHIP: 6N
RANGE: 64W

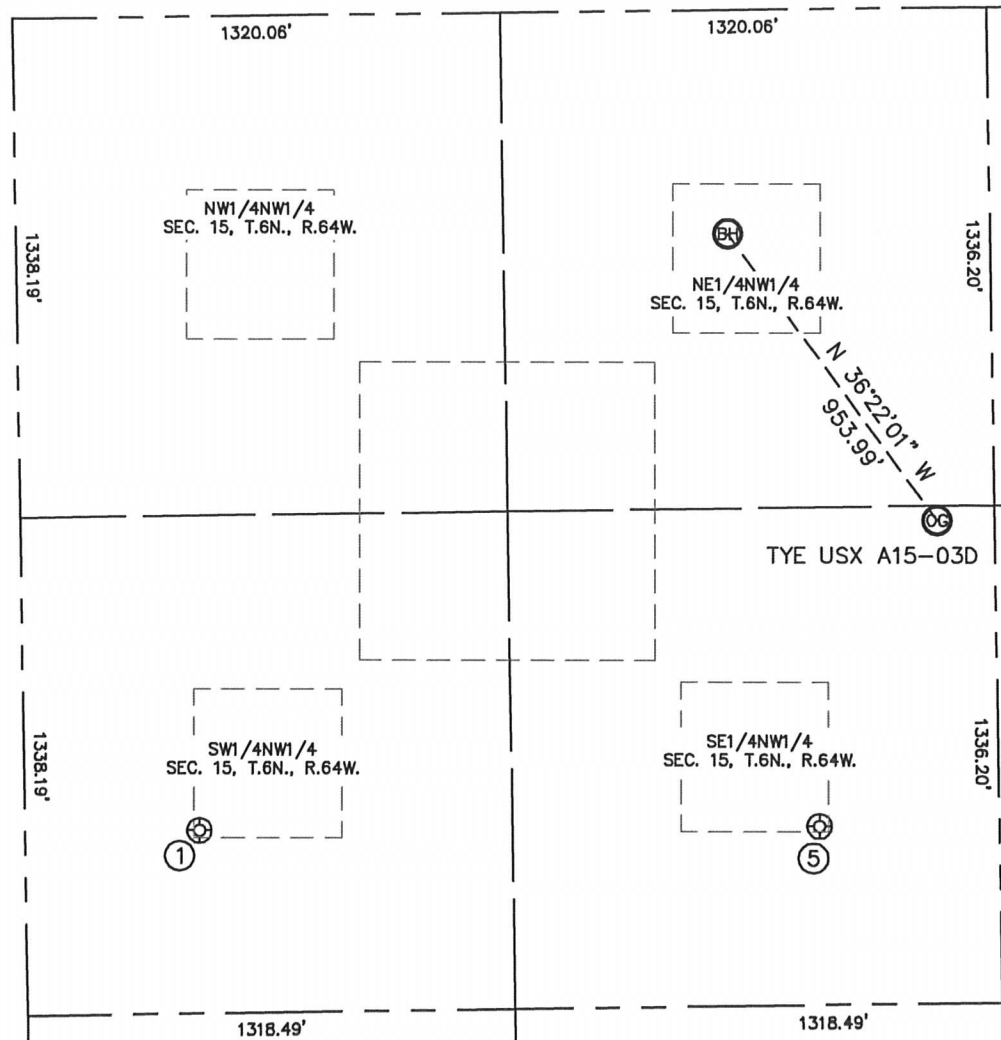

①
KERBS 12-15
SW1/4NW1/4
2184' FNL
472' FWL
LAT-40.48740°N
LONG-104.54404°W
PDOP: 1.7
ELEV: 4812'

⑤
KERBS 22-15
SE1/4NW1/4
2193' FNL
2151' FWL
LAT-40.48739°N
LONG-104.53801°W
PDOP: 2.1
ELEV: 4806'

