



02055146

045-19809

WELL: Puckett 11D-36D  
 FIELD: Grand Valley  
 COUNTY: Garfield  
 STATE: Co.


DATE JOB COMPLETED: 6/17/2011  
 ELEVATION KB: 8393  
 HOLE SIZE: 16

TOOL TYPE:  
 TYPE FLOAT COLLAR: Top-Co  
 TYPE FLOAT SHOE: Top-Co  
 TYPE CEMENT BASKET:  
 OTHER:

JT ABOVE KB#:

TOP JOINT #:

SIZE	WEIGHT	MAKE	API GRADE	THREAD	COUPLINGS	NO JOINTS	LENGTH
9 5/8"	36#	Evraz	J-55	8rd	LTC	59	2600
1.5	2.76#	Lakeside	J-55	10rd	IJ	70	2338
TOTALS:							

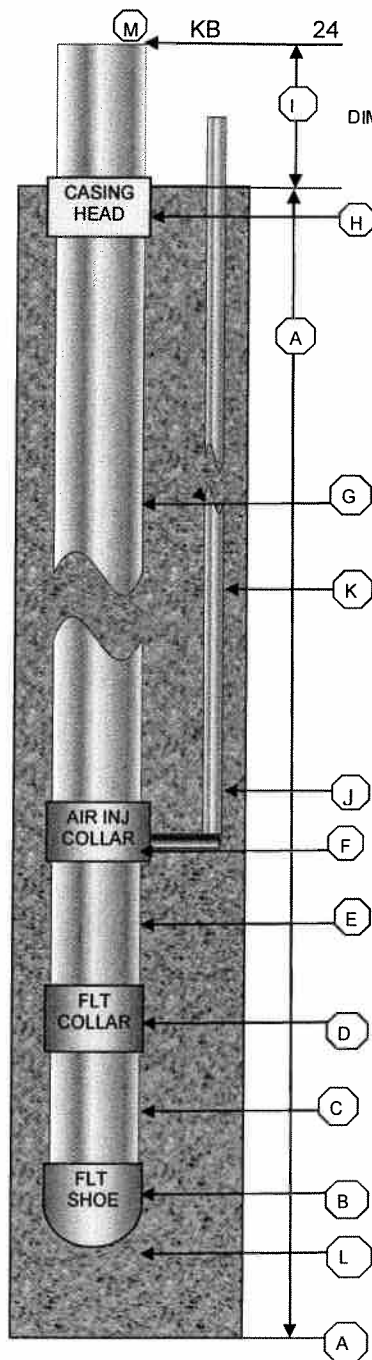

## DIMENSIONS:

A: 2686  
 B: 1.5  
 C: 37  
 D: 1.5  
 E: 215  
 F: 2  
 G: 44  
 H: 8  
 I: 24  
 J: 33.4  
 K: 2305  
 L: 2613  
 M: 24

## TUBULAR DATA

JTS. RACK TALLY (THDS OFF) 2600  
 JTS CSG LEFT ON RACK (THDS OFF) 0 (-)  
 LANDING JOINT 24 (+)  
 CSG USED INCLUDING LDJT (THDS OFF) 2624 (=)  
 FEET OF LDJT REMOVED 24 (-)  
 CASING LEFT IN HOLE 59 JOINTS 2600 (=)  
 AIR INJECTION COLLAR 2 (+)  
 FLOAT COLLAR 1.5 (+)  
 FLOAT /GUIDE SHOE 1.5 (+)  
 OTHER 8 (+)  
 CASING IN HOLE 2613 (=)  
 KB TO TOP OF CASNG OR CASING HEAD 24 (+)  
 TOTAL DEPTH OF CASING POINT 2637 (=)

## CEMENT DATA

## CENTRALIZER LOCATIONS:

## CEMENT BASKETS:

CEMENT COMPANY: Baker Hughes

TYPE CEMENT: FIRST STAGE 1317 sks prem.

TYPE CEMENT: SECOND STAGE 194 sks type III

ADDITIVES: FIRST STAGE:

ADDITIVES: SECOND STAGE:

SLURRY WEIGHT: 12.5/14.2 PPG: YIELD 1.97/1.47 CU. FT/ SK

TOTAL SK CEMENT: 1511 sks.

PLUG DOWN TIME: 10:30PM RETURNS A LUG DOWN: None %  
 MIX WATER 420/201 Bls

MUD WEIGHT: 9.2 125 SECS  
 MIXED CEMENT AT: 7/3 550/280 PSIG  
 DISPLACED CEMENT AT: 7 385 PSIG  
 PLUG DOWN WITH: 3 1010 PSIG  
 CHECKED FLOAT: Yes Held ?

TOP OF CEMENT BEHIND CASNG (CALCULATED): Surface

TOP OF CEMENT CALCULATED USING: Top-Out

PRECEDED CEMENT WITH: Rubber plug

DISPLACED CEMENT WITH: Water

LINES TETED TO: 3600 psi.

CASING PICK UP (PRIOR TO CEMENTING): 109,000#

CASAING SLACK OFF (PRIOR TO CEMENTING): 80,000#

RIG RELEASED DATE AND TIME:

SUPERVISOR: Gene Sandefer

Top-Out 650 sks, type III 14.2# Yield 1.47.