PLS Group, LLC
220 East Mulberry Street
Fort Collins, Colorado 80524

WELL LOCATION CERTIFICATE

THIS MAP DOES NOT REPRESENT A BOUNDARY SURVEY

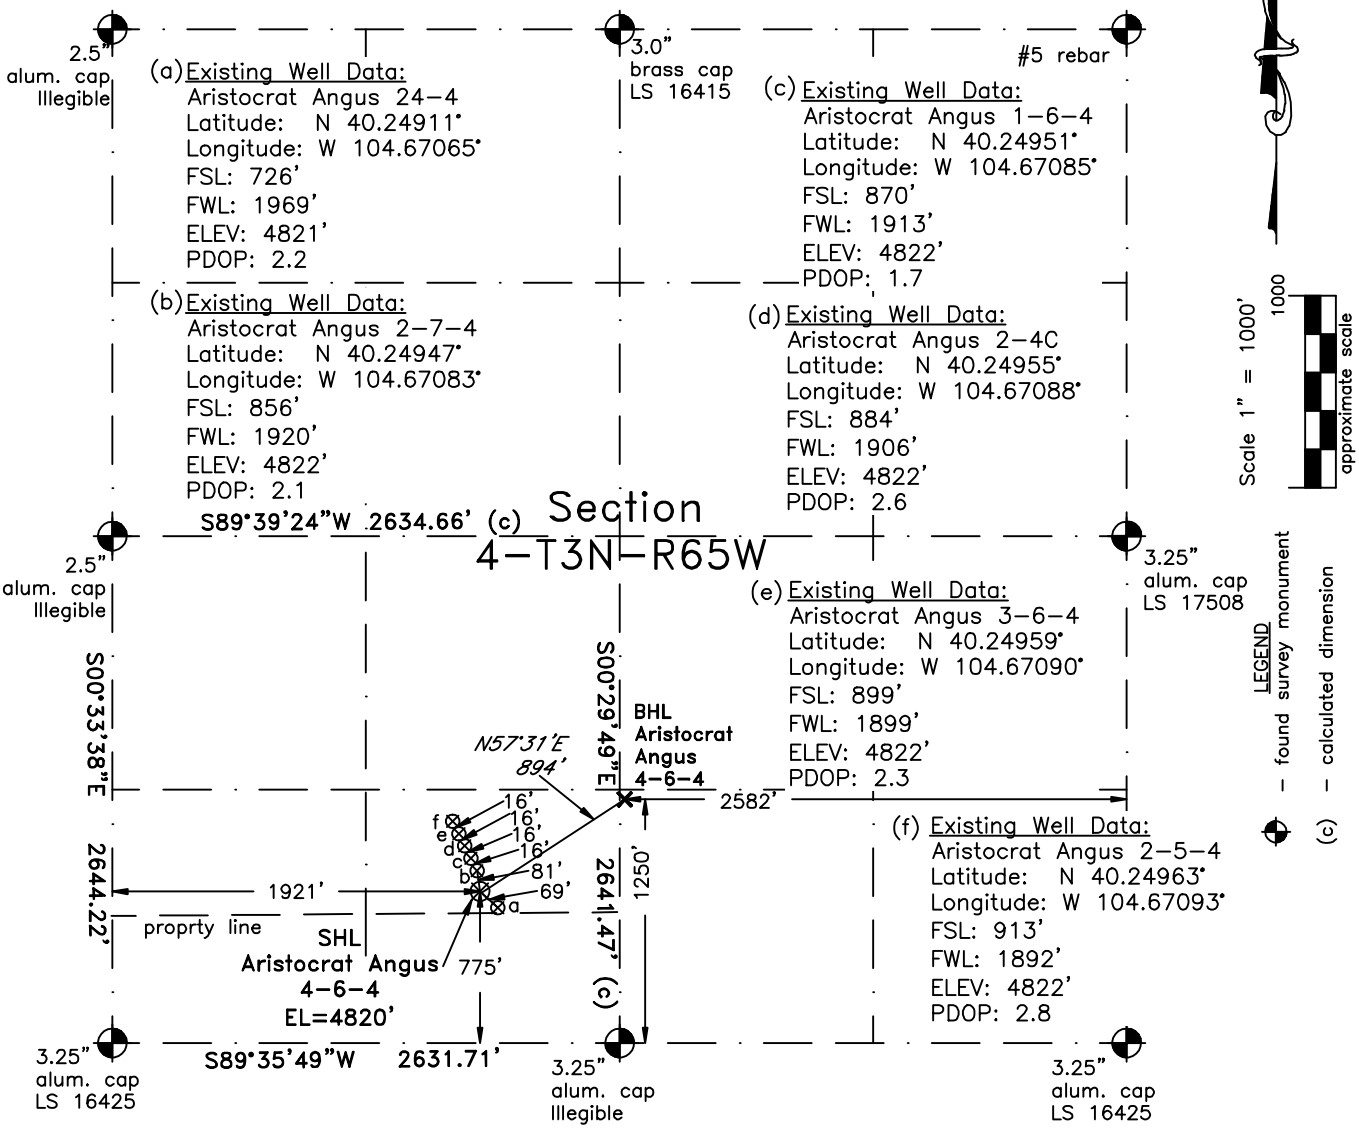

In accordance with a request from Dave Bale of EnCana Oil & Gas (USA) Inc., PLS Group, LLC, has determined the location of the **Aristocrat Angus 4-6-4** well site to be SHL: 775' FSL and 1921' FWL, (BHL 1250' FSL and 2582' FEL) as measured at ninety (90) degrees from the section lines of Section 4, Township 3 North, Range 65 West, 6th Principal Meridian, County of Weld, CO.

Proposed Surface Hole Data:
Latitude: N 40.24925° (BHL 40.25055°)
Longitude: W 104.67082° (BHL 104.66811°)
PDOP: 1.5

Nearest: Building 3540' southwest
Public Road 670' south
Property Line 113' south
Existing Well: Aristocrat Angus 24-4 69' southeast
Above Ground Utility 4060' southwest
Railroad 30,050' northwest
Well Window: SHL is 86' inside

Notes:
1) Bearings and distances based on NAD 83 Colorado North State Plane Coordinates using RTK GPS observations taken 10/04/10 by operator Tom Winans.
2) Conversion factor to ground (1.000274972).
3) Elevations based on NAVD 88 GPS heights and Geoid 2003 corrections.
4) See improvement map for visible improvements within 400 of pad site.
5) The location falls on natural ground.

NOTICE: According to Colorado law you MUST commence any legal action based upon any defect in this W.L.C. within three years after you first discover such defect. In no event may any action based upon any defect in this W.L.C. be commenced more than ten years from this said date of the certification shown hereon.

I hereby certify that this Well Location Certificate was prepared by me or under my direct supervision on 2/2/11 for and on behalf of EnCana Oil & Gas (USA) Inc. That it is not a Land Survey Plat or an Improvement Survey Plat and that it is not to be relied upon for establishment of fences, buildings, or other future improvement lines.

John Robert McGehee PLS#38219
Well: Aristocrat Angus 4-6-4 WLC