


PLS Group, LLC
220 East Mulberry Street
Fort Collins, Colorado 80524

WELL LOCATION CERTIFICATE

THIS MAP DOES NOT
REPRESENT A BOUNDARY SURVEY

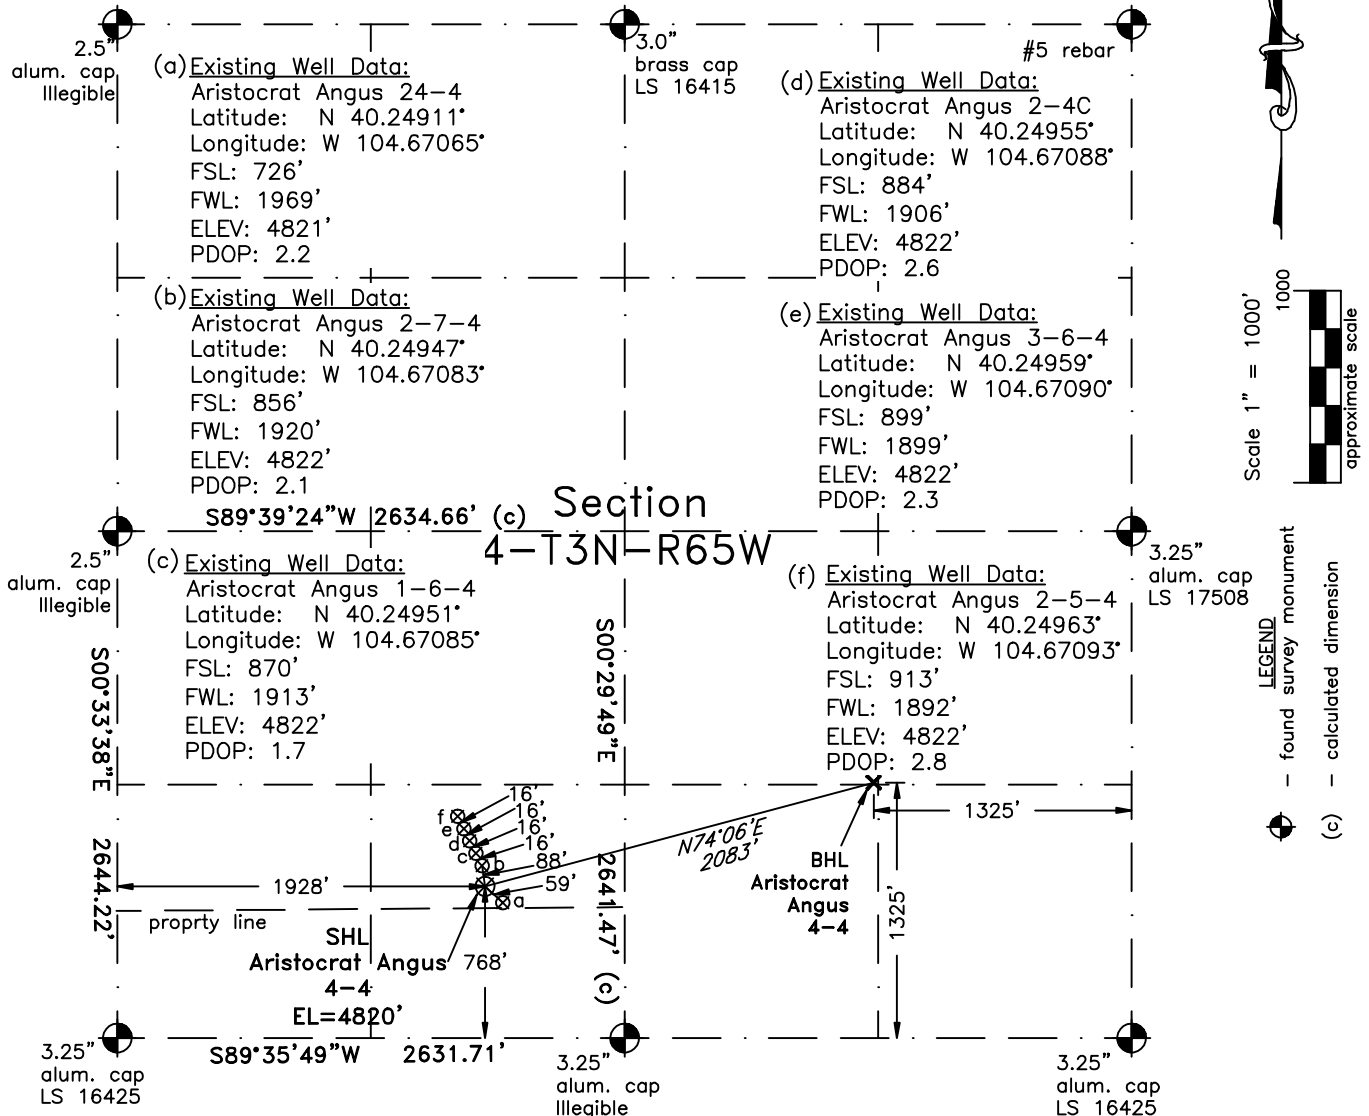

In accordance with a request from Dave Bale of EnCana Oil & Gas (USA) Inc., PLS Group, LLC has determined the location of the **Aristocrat Angus 4-4** well site to be SHL: 768' FSL and 1928' FWL, (BHL 1325' FSL and 1325' FEL) as measured at ninety (90) degrees from the section lines of Section 4, Township 3 North, Range 65 West, 6th Principal Meridian, County of Weld, CO.

Proposed Surface Hole Data:

Latitude: N 40.24923° (BHL 40.25074°)
Longitude: W 104.67080° (BHL 104.66360°)
PDOP: 1.5

Nearest: Building 3541' southwest Above Ground Utility 4059' southwest
Public Road 660' south Railroad 30,060' northwest
Property Line 103' south Well Window: SHL is 93' inside
Existing Well: Aristocrat Angus 24-4 59' southeast

Notes:

- 1) Bearings and distances based on NAD 83 Colorado North State Plane Coordinates using RTK GPS observations taken 10/04/10 by operator Tom Winans.
- 2) Conversion factor to ground (1.000274972).
- 3) Elevations based on NAVD 88 GPS heights and Geoid 2003 corrections.
- 4) See improvement map for visible improvements within 400 of pad site.
- 5) The location falls on natural ground.

NOTICE: According to Colorado law you MUST commence any legal action based upon any defect in this W.L.C. within three years after you first discover such defect. In no event may any action based upon any defect in this W.L.C. be commenced more than ten years from this said date of the certification shown hereon.

I hereby certify that this Well Location Certificate was prepared by me or under my direct supervision on 2/2/11 for and on behalf of EnCana Oil & Gas (USA) Inc. That it is not a Land Survey Plat or an Improvement Survey Plat and that it is not to be relied upon for establishment of fences, buildings, or other future improvement lines.

John Robert McGehee PLS#38219
Well: Aristocrat Angus 4-4 WLC