


WELL LOCATION CERTIFICATE


THIS MAP DOES NOT REPRESENT A BOUNDARY SURVEY

SECTION: 25
TOWNSHIP: 2N
RANGE: 65W

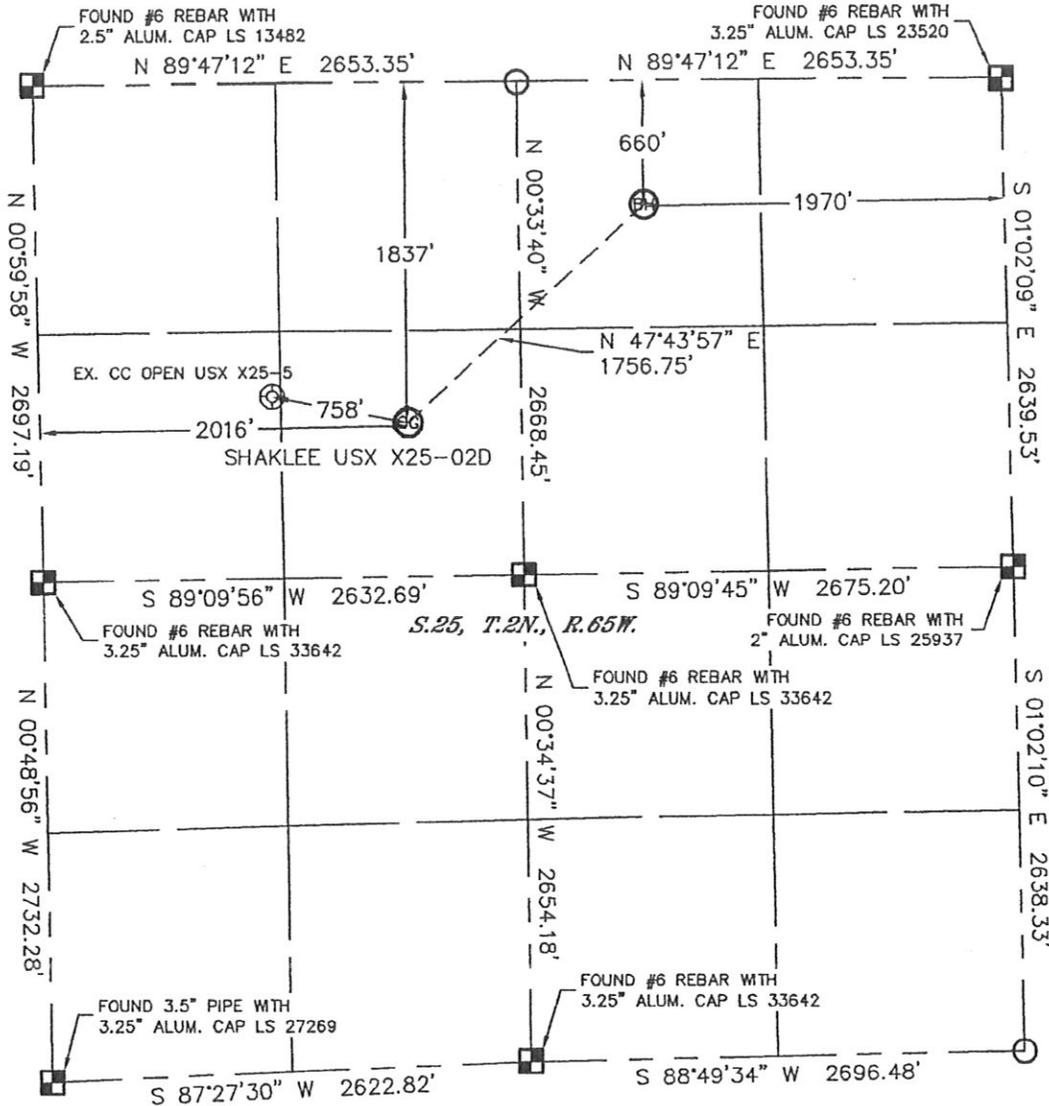

In accordance with a request from Mike Rodine with Noble Energy Inc. Lat40°, Inc. has determined the surface location of the SHAKLEE USX X25-02D to be 1837' from the NORTH line and 2016' from the WEST line and the bottom hole to be 660' from the NORTH line and 1970' from the EAST line as measured at right angles from the section lines of Section 25, Township 2 North, Range 65 West of the Sixth Principal Meridian, County of Weld, State of Colorado.

I hereby state that this Well Location Certificate was prepared by me, or under my direct supervision, that the fieldwork was completed on 3/4/11, for and on behalf of Noble Energy Inc. That this is not a Land Survey Plat or an Improvement Survey Plat, and that it is not to be relied upon for establishment of fence, building, or other future improvement lines.

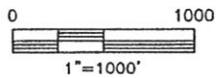

NOTE:

- 1) Bearings shown are Grid Bearings of the Colorado State Plane Coordinate System, North Zone, North American Datum 1983/2007. The lineal dimensions as contained herein are based upon the "U.S. Survey Foot."
- 2) Ground elevations are based on an observed GPS elevation (NAVD 1988 DATUM).
- 3) NEAREST EXISTING WELL: CC OPEN USX X25-5 758'
- 4) IMPROVEMENTS: See LOCATION DRAWING for all visible improvements within 400' of disturbed area.
- 5) SURFACE USE: RANGELAND
- 6) INSTRUMENT OPERATOR: AARON LUND

SURFACE LOCATION	BOTTOM HOLE
LATITUDE: 40.11170°N	LATITUDE: 40.11491°N
LONGITUDE: 104.61450°W	LONGITUDE: 104.60981°W
PDOP: 1.9	
ELEV: 4904'	
1/4, 1/4: SE1/4NW1/4	
NEAREST PROPERTY LINE: 623' EAST	

NOTE

According to Colorado law, you must commence any legal action based upon any defect in this W.L.C. within three years after you discover such defect. In no event, may any action based upon any defect in this survey be commenced more than ten years after the date of the certificate shown hereon. (13-80-105 C.R.S.)

LEGEND

-  = ALIQUOT MONUMENT AS DESCRIBED
-  = CALCULATED POSITION




Brian T. Brinkman—On behalf of Lat40°, Inc.
Colorado Licensed Professional
Land Surveyor No. 38175

PROJECT#: 2011033

SITE SKETCH

SHAKLEE USX X25-02D

SECTION: 25
TOWNSHIP: 2N
RANGE: 65W

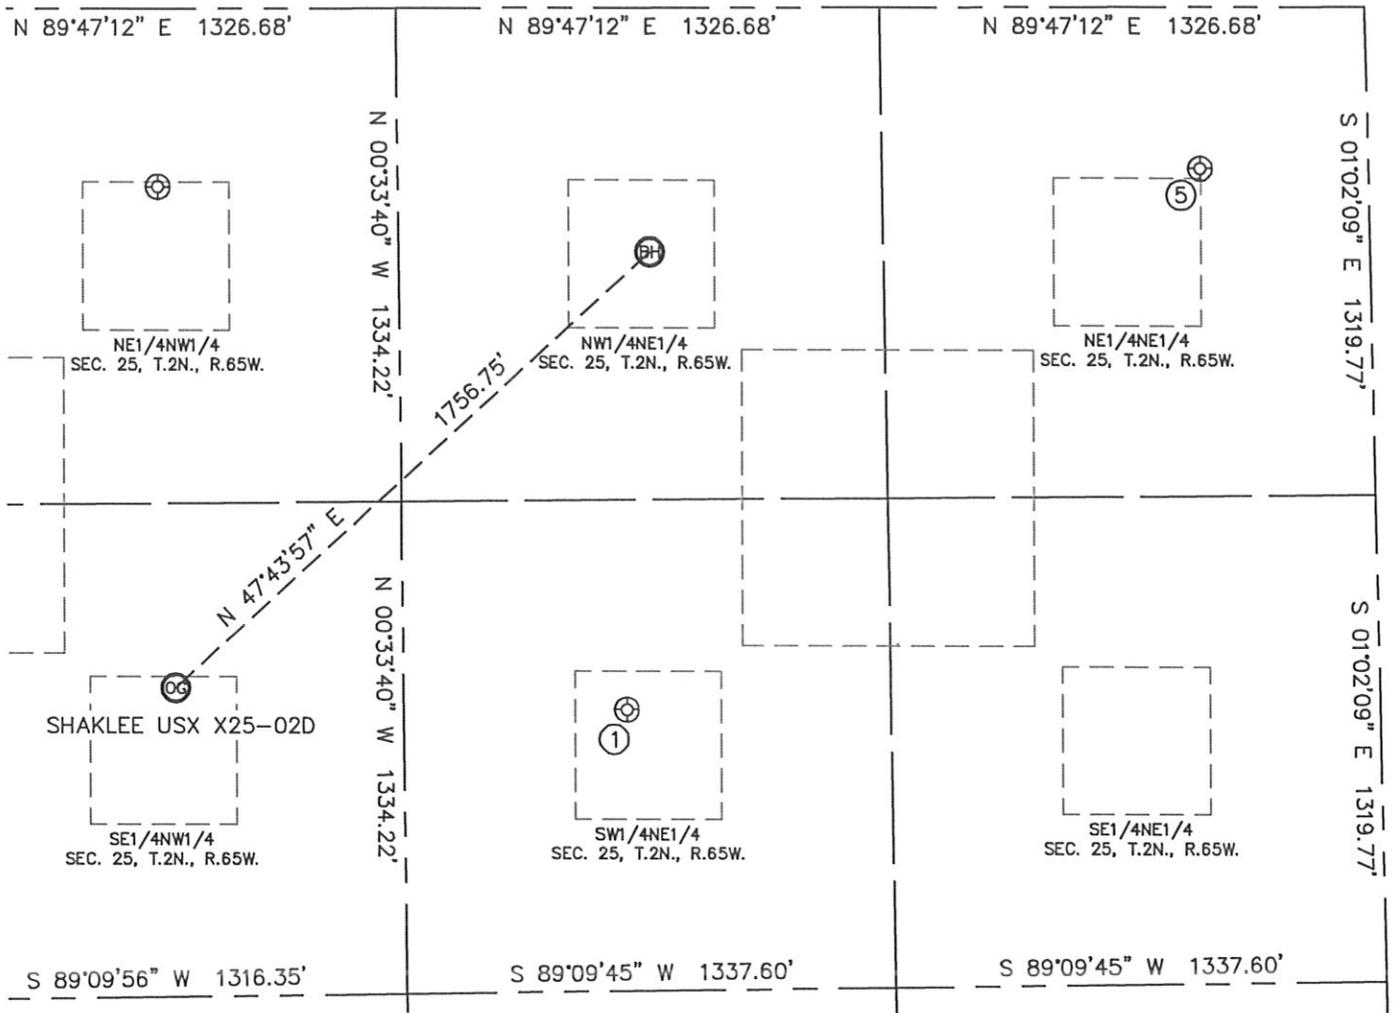

①

SHAKLEE 32-25
SW1/4NE1/4
1899' FNL
2058' FEL
LAT-40.11151°N
LONG-104.61009°W
PDOP: 2.0
ELEV: 4898'

⑤

SHAKLEE 41-25
NE1/4NE1/4
436' FNL
461' FEL
LAT-40.11549°N
LONG-104.60442°W
PDOP: 0.9
ELEV: 4897'

