




DRILLING COMPANY, INC. **WICHITA, KANSAS**

Wellbore Diagram

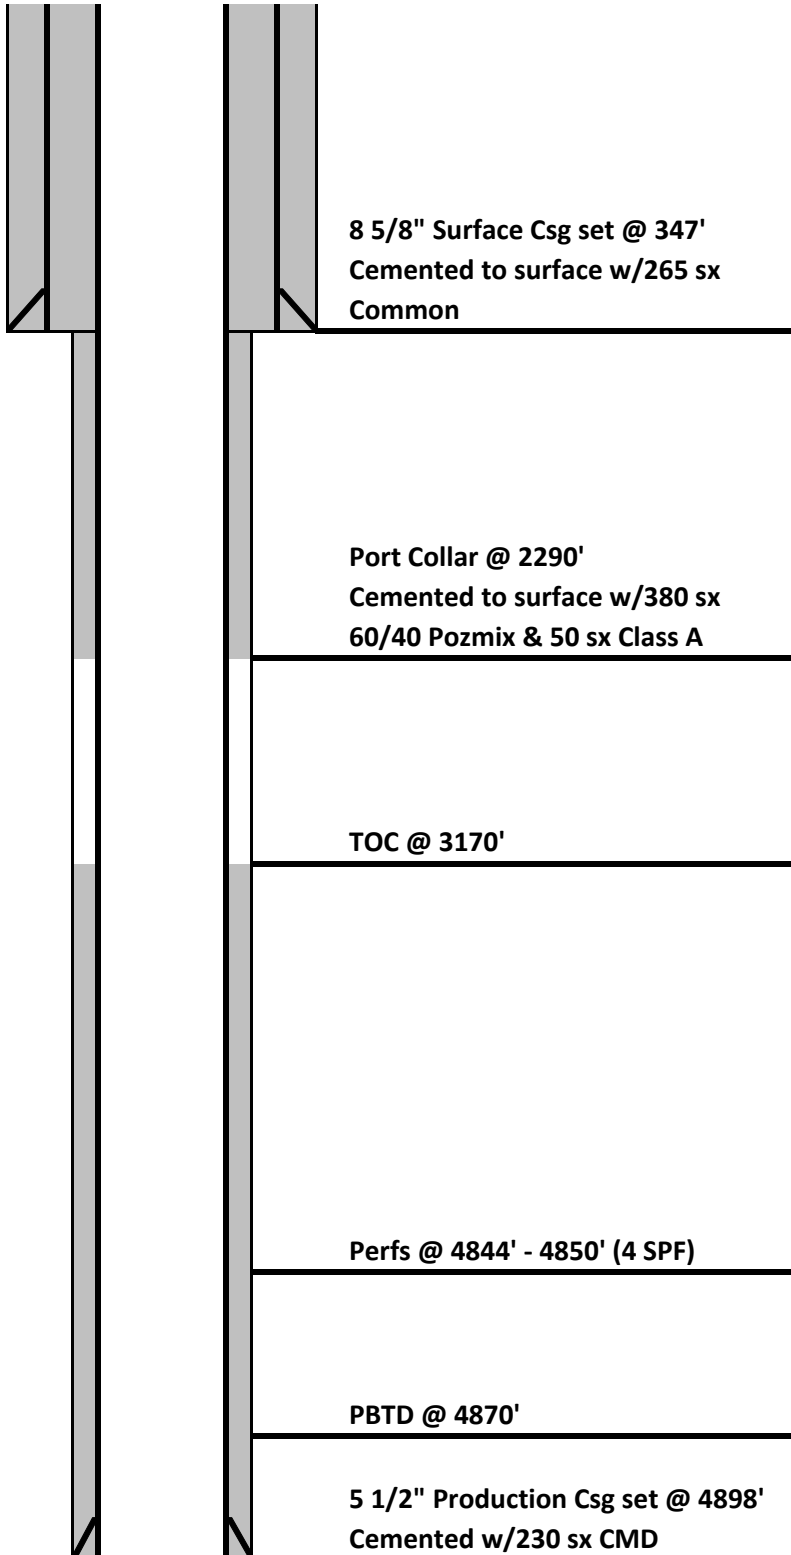

Date:	6/14/2011
Well Name:	Jettie #1-34
Location:	658' FNL & 1621' FWL NE/4 NW/4 34-18S-45W
County:	Kiowa
State:	Colorado
API:	05-061-06852-00
Spud Date:	5/3/2011

Hole Size	12 1/4"
Surface Casing:	Set @ 347' (8 5/8")
Cemented with:	265 sx Common
Production Csg:	Set @ 4898' (5 1/2")
Cemented with:	230 sx CMD

Log Tops:

Anhydrite	2268
B/Anhydrite	2302
Shawnee	3400
Heebner Shale	3602
Lansing	3626
Hushpuckny	3942
B/KC	3974
Marmaton	4012
Fort Scott	4094
Cherokee Shale	4150
Atoka	4284
Morrow Shale	4418
Upper Morrow Sand	4420
Keyes	4566
Miss/St. Gen	4594
Spergen X Marker	4748
Warsaw Lime	4794
Lower Warsaw Poro	4844
Harrison Shale	4854
Osage	4858
RTD	4907
LTD	4896