

Petroleum Field Services, LLC


1801 W. 13th Ave.

Denver, CO 80204

## LOCATION DRAWING


ORR USX A03-15D

SECTION: 3  
TOWNSHIP: 6N  
RANGE: 64W

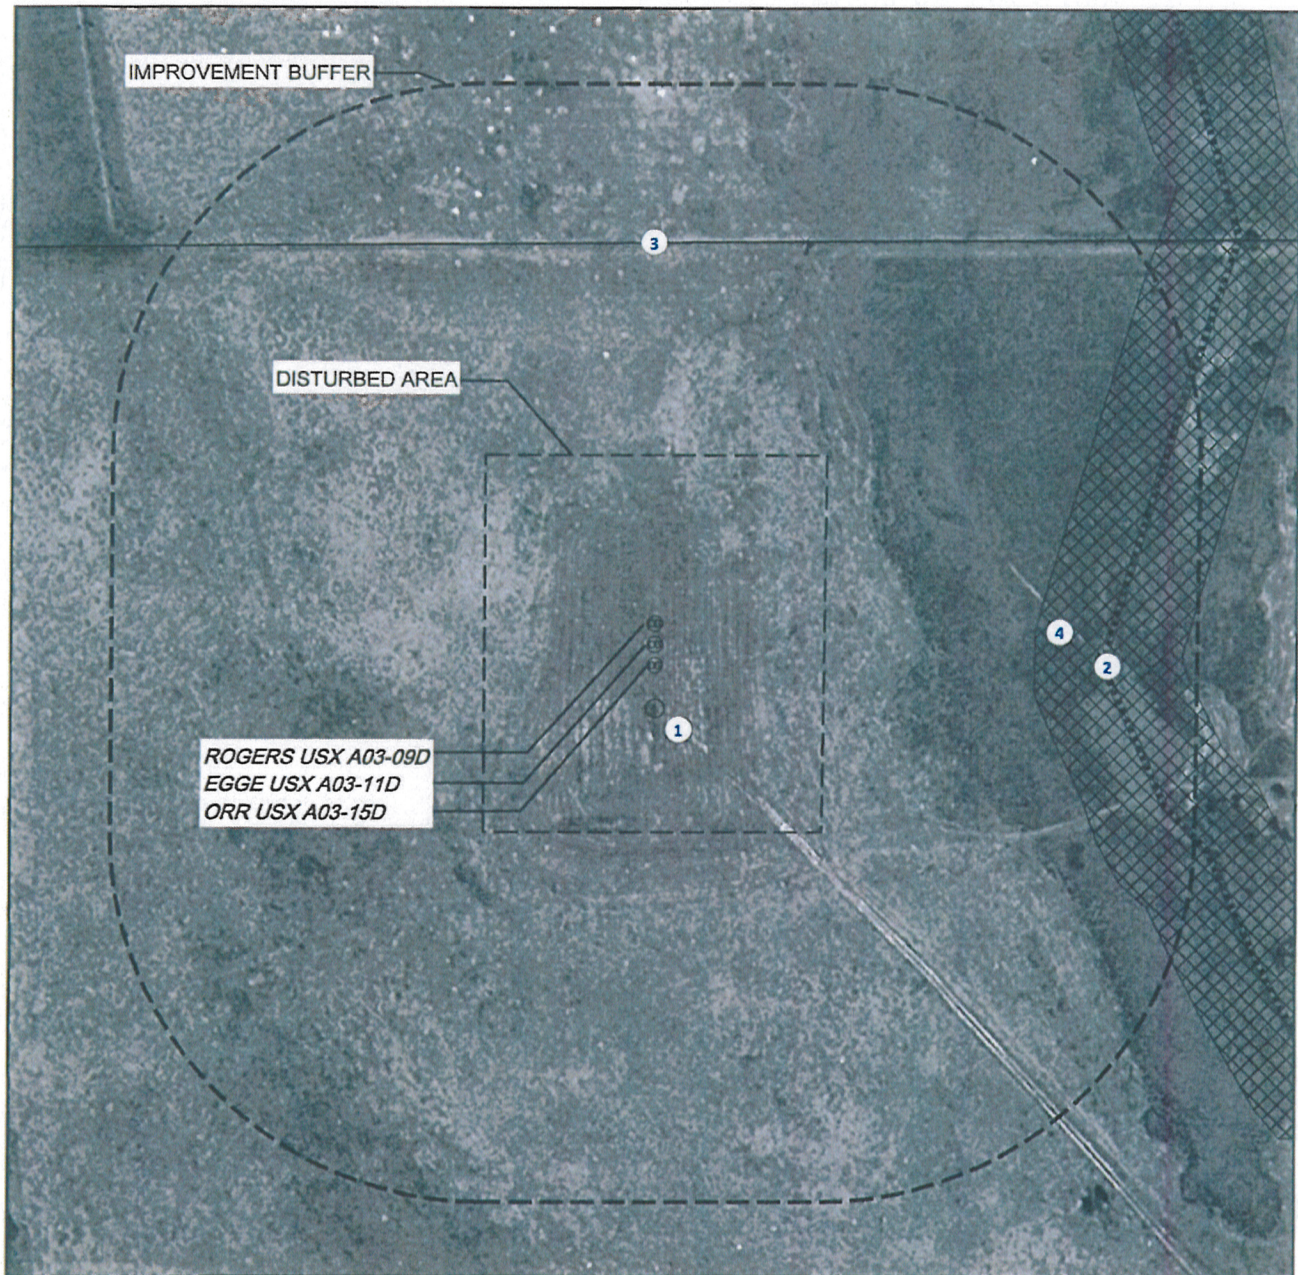

### IMPROVEMENTS:

- ① EXISTING WELL (ROGERS 33-3) 47' S.
- ② INTERMITTENT STREAM 485' E.
- ③ FENCE 455' N.
- ④ MARSHLAND AREA 407' E.

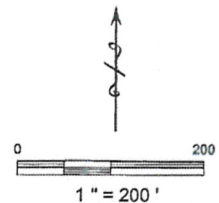

NEAREST: BUILDING 1261' NW (SHED), WEST EDGE OF PUBLIC ROAD 1821' E (CR 57), ABOVE GROUND UTILITY 1497' NW (ABOVE GROUND POWER LINE), RAILROAD 5280' + W, PROPERTY LINE 454' N.