
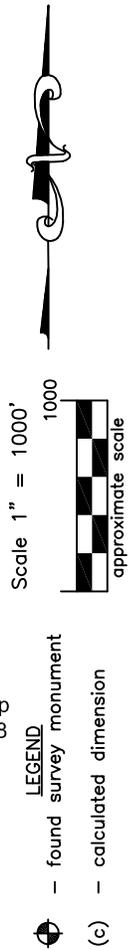


PLS Group, LLC

109 Coronado Ct. - Building No. 7
 Fort Collins, Colorado 80525
 P. 970-282-3446 Fx. 970-377-6767

WELL LOCATION CERTIFICATE

*THIS MAP DOES NOT
 REPRESENT A BOUNDARY SURVEY*

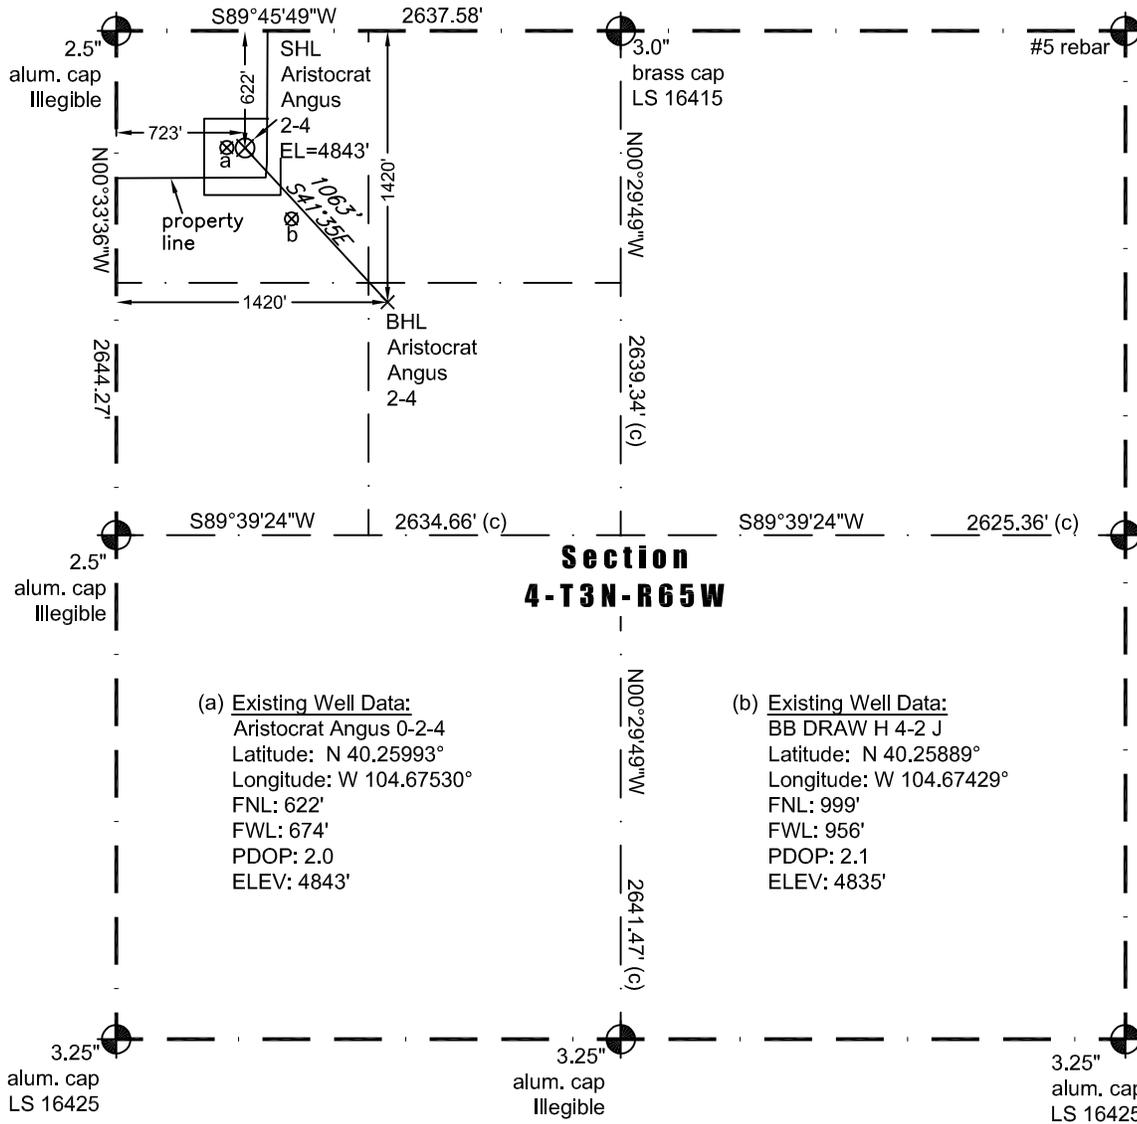

**Section
 4-T3N-R65W**

(a) Existing Well Data:
 Aristocrat Angus 0-2-4
 Latitude: N 40.25993°
 Longitude: W 104.67530°
 FNL: 622'
 FWL: 674'
 PDOP: 2.0
 ELEV: 4843'

(b) Existing Well Data:
 BB DRAW H 4-2 J
 Latitude: N 40.25889°
 Longitude: W 104.67429°
 FNL: 999'
 FWL: 956'
 PDOP: 2.1
 ELEV: 4835'

LEGEND
 — found survey monument
 - - - calculated dimension
 (c)

In accordance with a request from Kevin Brakovec of EnCana Oil & Gas (USA) Inc., PLS Group, LLC has determined the location of the **Aristocrat Angus 2-4** well site to be SHL: 622' FNL and 723' FWL, (BHL 1420' FNL and 1420' FWL) as measured at ninety (90) degrees from the section lines of Section 4, Township 3 North, Range 65 West, 6th Principal Meridian, County of Weld, CO.

Proposed Surface Hole Data:

Latitude: N 40.25993° (BHL 40.25773°)
 Longitude: W 104.67512° (BHL 104.67262°)
 PDOP: 1.3

Nearest:

- Building 990' northeast
- Public Road 606' north
- Property Line 112' east
- Existing Well: Aristocrat Angus 0-2-4 49' west
- Above Ground Utility 927' northeast
- Railroad 26,660' northwest
- Well Window: SHL is 137' inside

Notes:

- 1) Bearings and distances based on NAD 83 Colorado North State Plane Coordinates using RTK GPS observations taken 4/17/11 by operator J.R. McGehee.
- 2) Conversion factor to ground (1.000274972).
- 3) Elevations based on NAVD 88 GPS heights and Geoid 2003 corrections.
- 4) See improvement map for visible improvements within 400 of pad site.
- 5) The surface use is agricultural field.

NOTICE: According to Colorado law you MUST commence any legal action based upon any defect in this W.L.C. within three years after you first discover such defect. In no event may any action based upon any defect in this W.L.C. be commenced more than ten years from this said date of the certification shown hereon.

I hereby certify that this Well Location Certificate was prepared by me or under my direct supervision on 5/11/11 for and on behalf of EnCana Oil & Gas (USA) Inc. That it is not a Land Survey Plat or an Improvement Survey Plat and that it is not to be relied upon for establishment of fences, buildings, or other future improvement lines.

John Robert McGehee PLS#38219
 Well: Aristocrat Angus 2-4 WLC