


# LOCATION DRAWING

OJEDA USX XX07-09D FACILITY

SECTION: 07  
TOWNSHIP: 1N  
RANGE: 65W

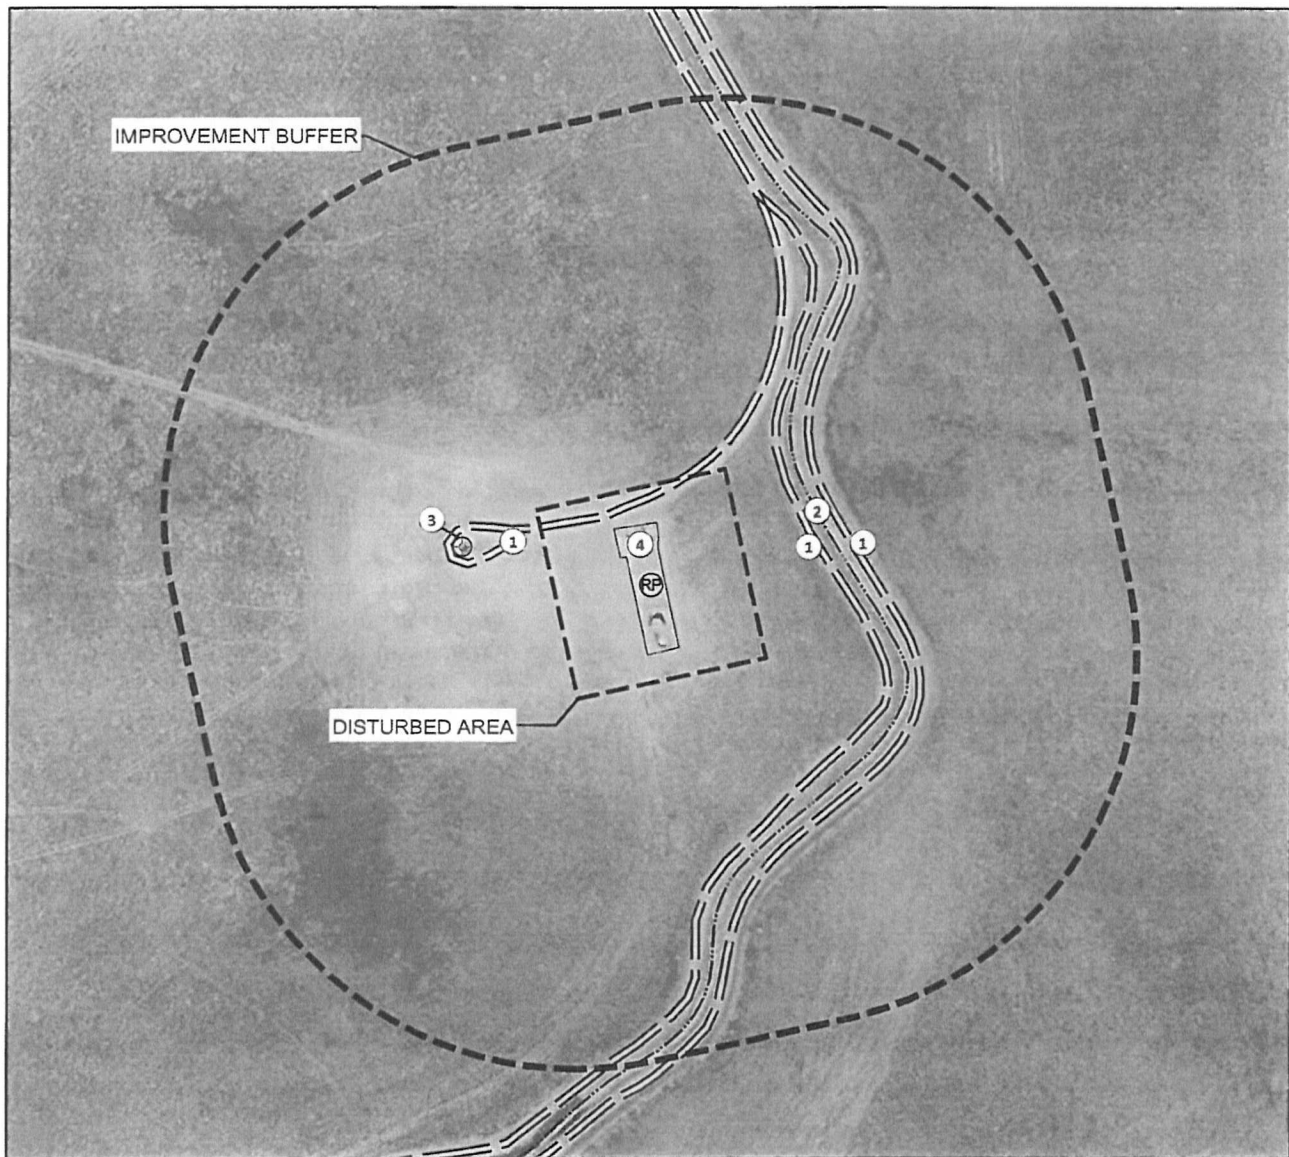

## Reference Point:

Latitude: 40.070405  
Longitude: -104.700011  
Elevation: 4988'  
PDOP: 1.79  
Date: 5/16/11  
Operator: Chris Boub  
¼ ¼ : NE¼ NE¼  
FNL: 1054'  
FEL: 774'

Distance to OJEDA USX XX07-09D - 400' SW

## Associated Proposed Wells:


GREEN USX XX07-07D  
OJEDA USX XX07-09D  
GREEN USX XX07-08D

## Associated Existing Wells:

GREEN 31-7  
GREEN USX XX7-1

## IMPROVEMENTS:

- ① FIELD ROAD 100' N, 178' NE, 210' NE.
- ② DIRT DITCH 212' E.  
(FEATURE DRY AT TIME OF MAPPING)
- ③ EXISTING WELL GREEN USX XX7-1 204' NW.
- ④ EXISTING FACILITY

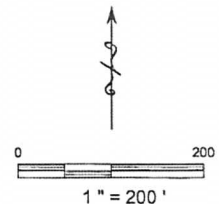

NEAREST: BUILDING 1380' SE (BARN), PUBLIC ROAD 1055' N (CR 12), ABOVE GROUND UTILITY 1524' SE (POWER LINE), RAILROAD 5280' + SE, PROPERTY LINE 538' W.