



Location for McDaniel 34-9 TR

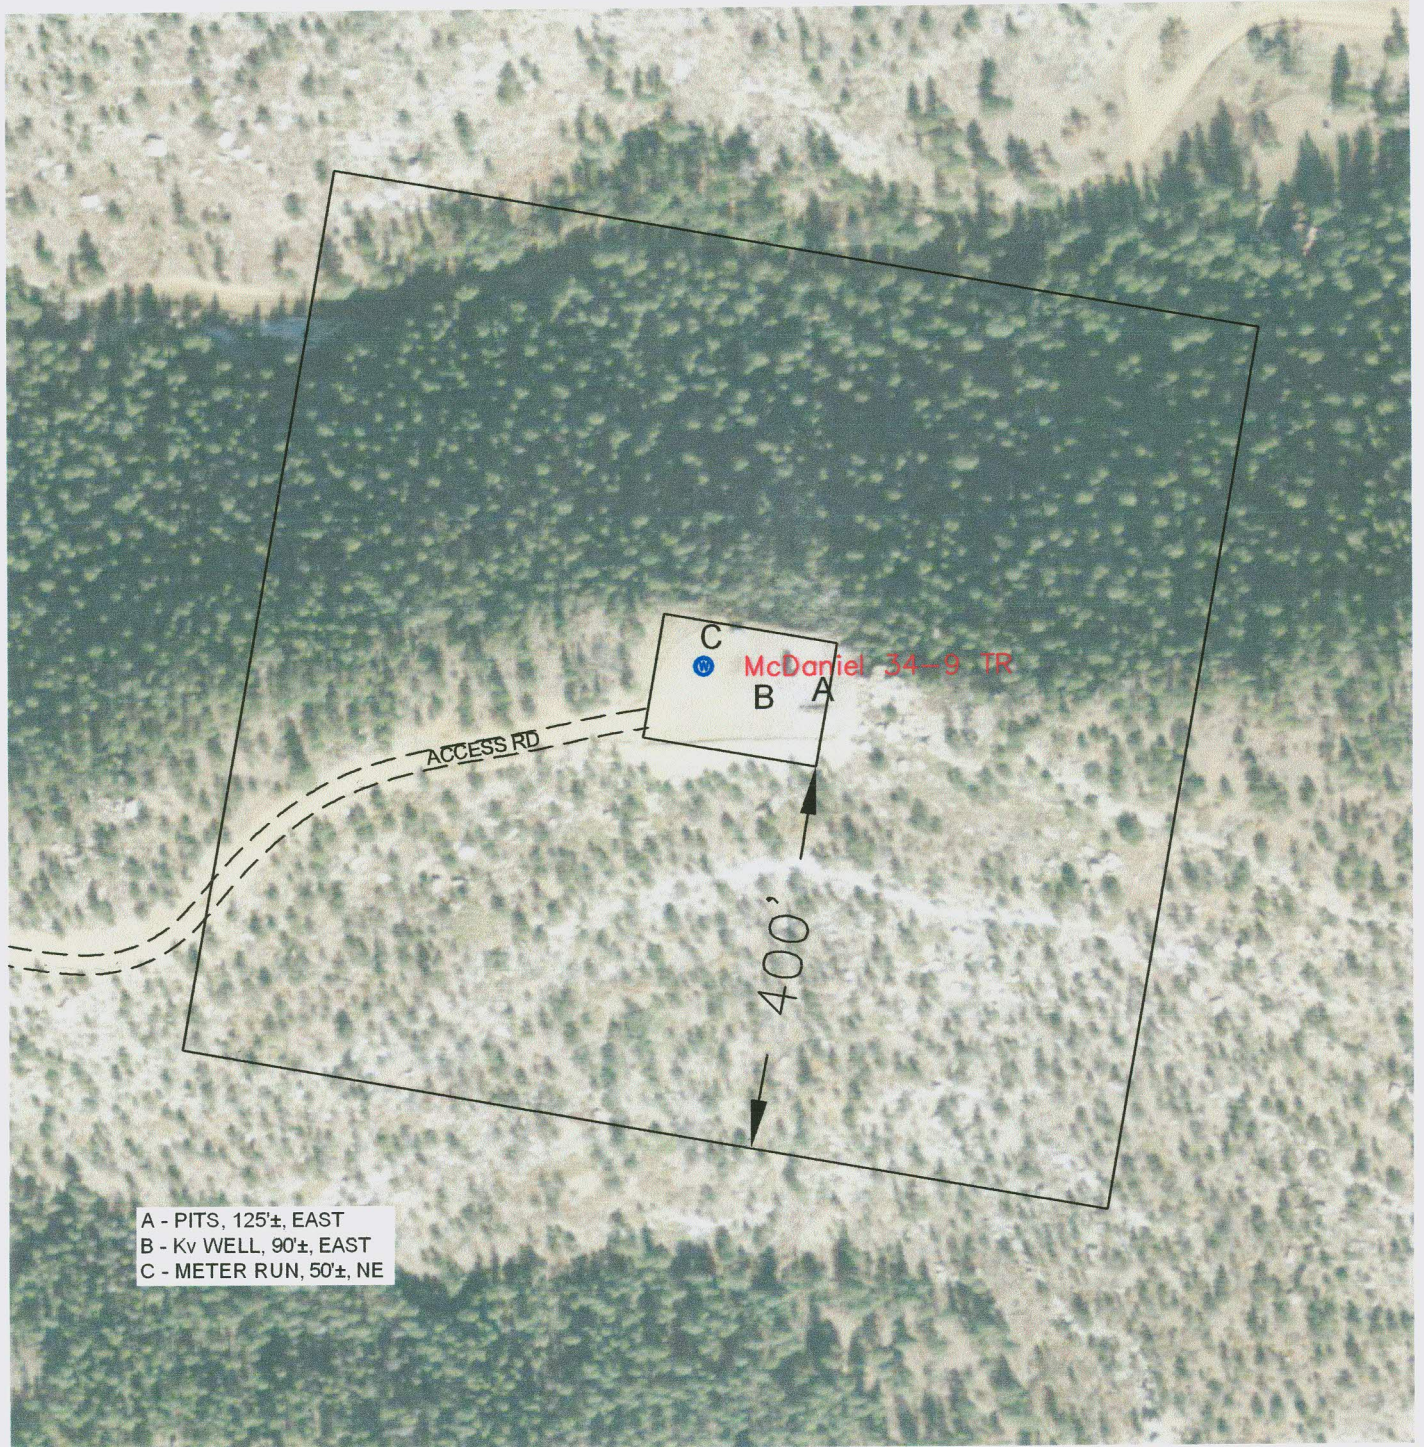

NOTE:

FOOTAGES GIVEN ARE ONLY ESTIMATES BASED ON SUBDIVISION PLATS AND TIED TO EXISTING CONTROL. A FULL BOUNDARY SURVEY IS REQUIRED TO DETERMINE TRUE SUBDIVISION LOT AND ROAD LOCATIONS, DISTANCES AND AREA OR FOOTAGE CALCULATIONS.

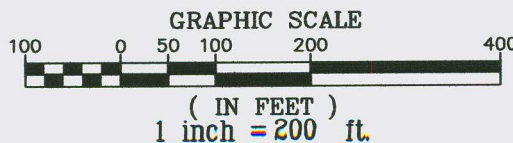

Date: June 02, 2011

S HIELDS SURVEY Ltd. Co.
619 South 2nd Street
P.O. Box 639
Raton, New Mexico 87740
Phone: 445-1232 Fax: 445-3648