



**CASCADE CREEK**  
**CC 697-08-04A**  
 WELL PAD 697-08A  
 GRADED ELEVATION: 8400.40'

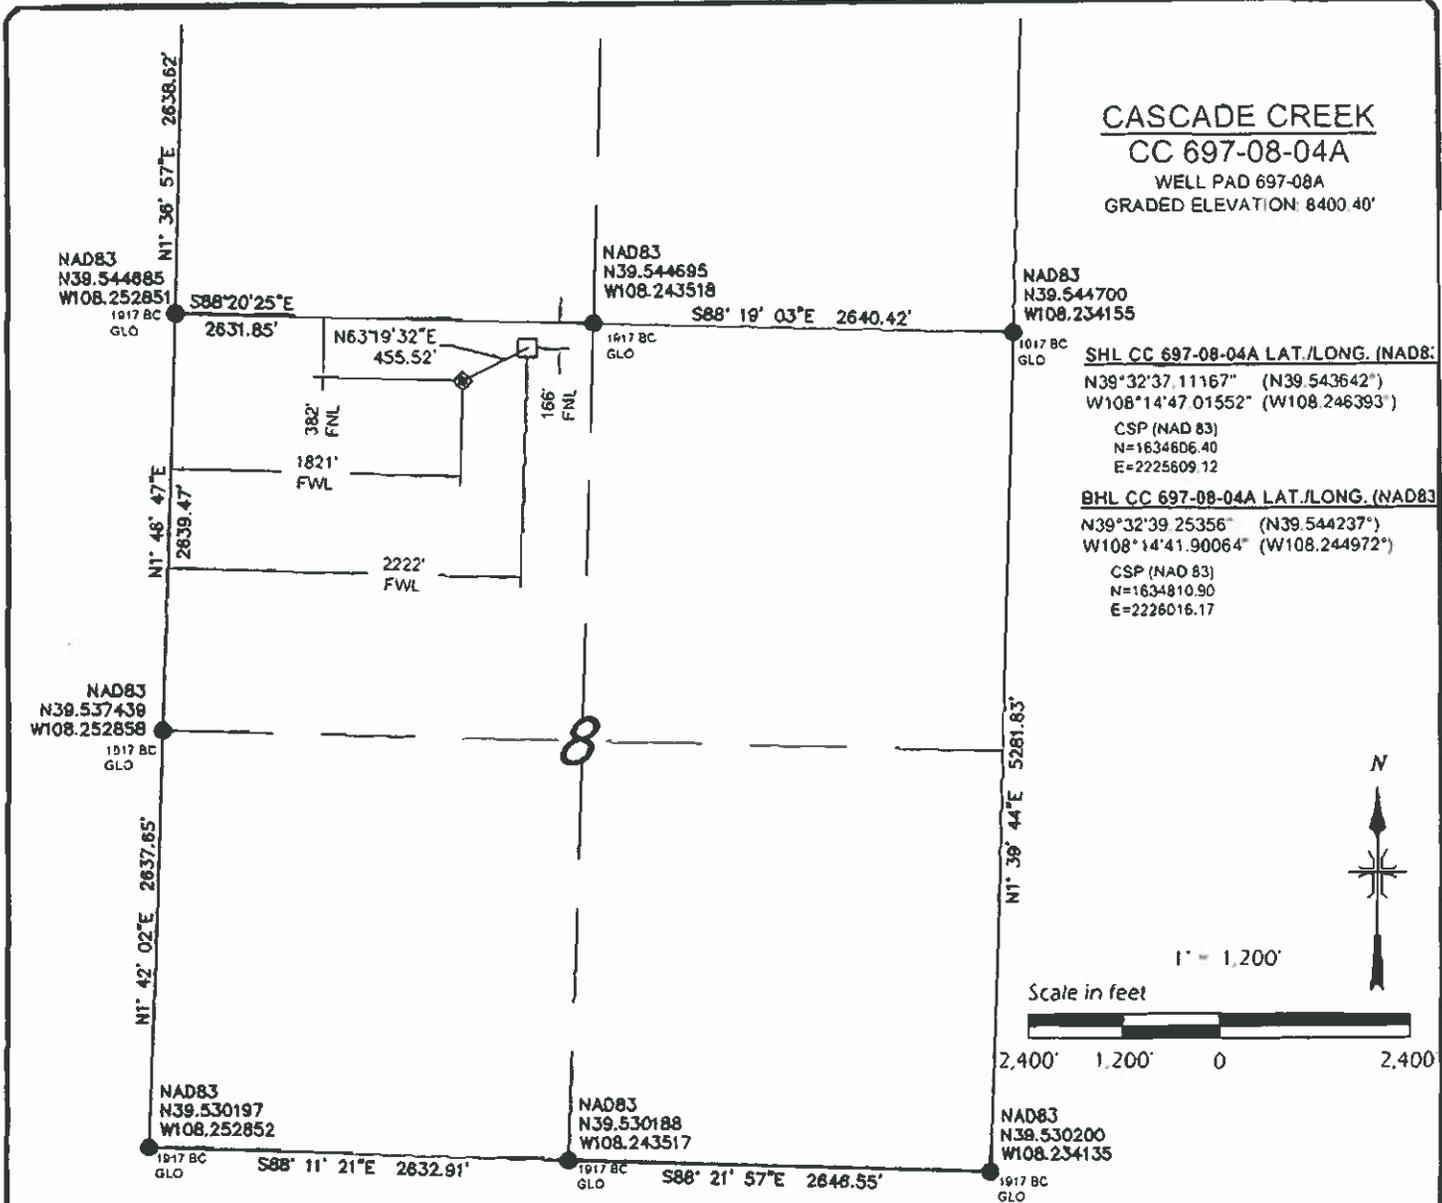

**SHL CC 697-08-04A LAT./LONG. (NAD83):**  
 N39°32'37.11167" (N39.543642")  
 W108°14'47.01552" (W108.246393")  
 CSP (NAD 83)  
 N=1634606.40  
 E=2225609.12

**BHL CC 697-08-04A LAT./LONG. (NAD83)**  
 N39°32'39.25356" (N39.544237")  
 W108°14'41.90064" (W108.244972")  
 CSP (NAD 83)  
 N=1634810.90  
 E=2226016.17

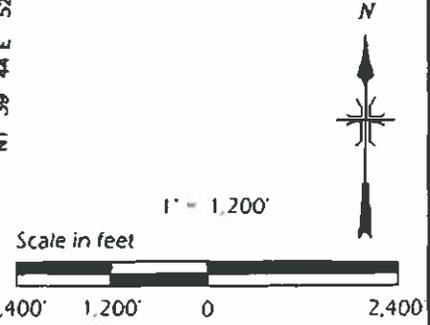

**SURVEYORS CERTIFICATE:**

This is to certify that this exhibit was prepared and location as shown was staked on the ground from actual surveys made by me or under my direct supervision.



Ron K. Borrett L.S. 24299  
 On behalf of Del-Mont Consultants Inc.

**LEGEND**

- FOUND MONUMENT
- CALCULATED CORNER
- ⊙ WELL LOCATION
- ⊕ TARGET LOCATION
- BOTTOM HOLE LOCATION
- SHL - SURFACE HOLE LOCATION
- THL - TARGET HOLE LOCATION
- BHL - BOTTOM HOLE LOCATION

**BASIS OF BEARING/DATUM**

A GPS OBSERVATION FROM NGS PID AJ3463 (McCARY)

**BASIS OF ELEVATION**

A GPS OBSERVATION FROM NGS PID AJ3463 (McCARY). ELEVATION IS 5174.69'

**DIMENSIONAL TIES**

ALL DIMENSIONAL TIES TO SECTION LINES ARE MEASURED AT A 90° ANGLE TO THE SECTION LINE.

**NOTES:**

- 1) GPS OPERATOR A LEWIS OBSERVED A PDOP OF 1.2
- 2) ALL GPS OBSERVATIONS ARE IN COMPLIANCE WITH COGCC RULE 215
- 3) ALL DISTANCES ARE GRID DISTANCE IN U.S. SURVEY FEET, NAD83, COLORADO CENTRAL ZONE
- 4) THIS PLAT COMPLIES WITH COGCC RULE 303c
- 5) NO VISIBLE IMPROVEMENTS WITHIN 400' OF WELL HEAD
- 6) VEGETATION: SCRUB OAK, ASPEN, NATIVE SHRUBS & GRASSES
- 7) TARGET HOLE AND BOTTOM HOLE NAD83 COORDINATES SHOWN ON THIS PLAN ARE CONVERTED FROM A DRILLING REPORT TRANSMITTED JUNE 8, 2011.

DATE REVISED:

DEL-MONT CONSULTANTS IS PROVIDING GRADING DESIGN FOR THIS PROJECT THAT PROVIDES DIMENSIONS AND VOLUME INFORMATION FOR CONSTRUCTION.

<b>DMC</b>		<b>DEL-MONT CONSULTANTS, INC.</b> ENGINEERING • SURVEYING • PLANNING 126 Colorado Ave. • Montevideo, CO 81051 • (970) 344-2261 • (970) 344-2043 fax www.del-mont.com • info@del-mont.com	
DESIGNED BY	MGWS/SNS	SCALE	AS NOTED
CHECKED BY	R. BARRETT	FILE NAME	10080V-007-08A-PLAT



**SECTION 8, T6S, R97W, 6TH PM**  
**WELL LOCATION PLAT**  
**CC 697-08-04A**  
**WELL PAD 697-08A**  
**GARFIELD COUNTY, COLORADO**  
**OXY USA WTP LP**

DMC JOB NO	10080
DATE ISSUED	2011-06-01
DATE SURVEYED	2008-08-19
PLAT	1 of 9