


**PLS Group, LLC**

109 Coronado Ct. - Building No. 7  
 Fort Collins, Colorado 80525  
 P. 970-282-3446 Fx. 970-377-6767

**WELL LOCATION CERTIFICATE**

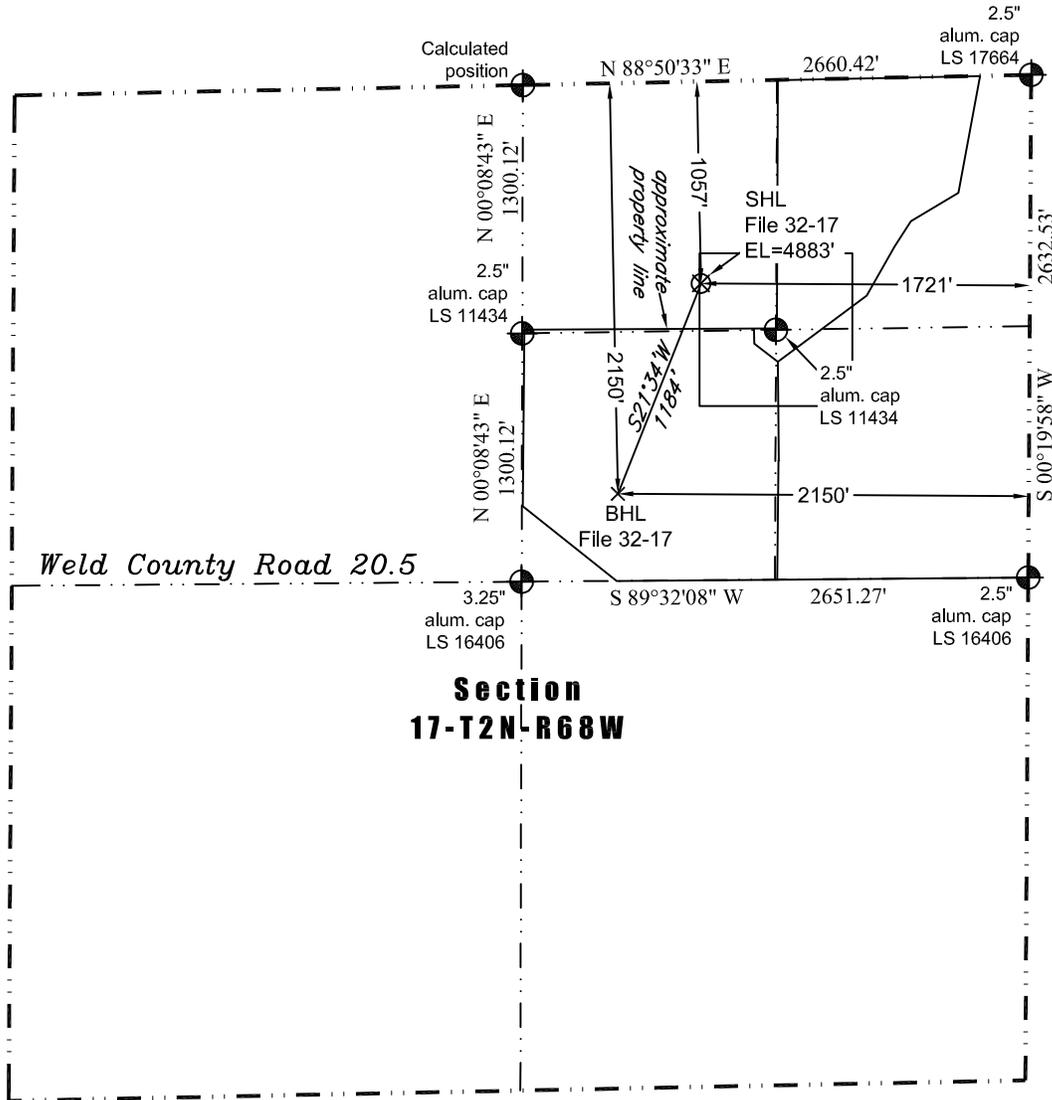

Scale 1" = 1000'  
 1000  
 approximate scale

**LEGEND**  
 (c) - survey monument  
 (c) - calculated position

In accordance with a request from Dave Bale of EnCana Oil & Gas (USA) Inc., PLS Group, LLC has determined the location of the **File 32-17** well site to be SHL: 1057' FNL and 1721' FEL, (BHL 2150' FNL and 2150' FEL) as measured at ninety (90) degrees from the section lines of Section 17, Township 2 North, Range 68 West, 6th Principal Meridian, County of Weld, CO.

**Proposed Surface Hole Data:**

Latitude: N 40.14297° (BHL 40.13995°)  
 Longitude: W 105.02376° (BHL 105.02534°)  
 PDOP: 2.7

**Nearest:**

Building 423' southeast      Above Ground Utility 983' west  
 Public Road 1,545' south      Railroad 9,833' northwest  
 Property Line 237' south      Well Window: SHL is 8' inside  
 Existing Well: Longmont #8-10K 2,765' northeast

**Notes:**

- 1) Bearings and distances based on NAD 83 Colorado North State Plane Coordinates using RTK GPS observations taken 5/9/11 by operator Craig bBurke.
- 2) Conversion factor to ground (1.00027187).
- 3) Elevations based on NAVD 88 GPS heights and Geoid 2003 corrections.
- 4) See improvement map for visible improvements within 400' of pad site.
- 5) The surface use is agricultural field.

I hereby certify that this Well Location Certificate was prepared by me or under my direct supervision on 5/18/2011 for and on behalf of EnCana Oil & Gas (USA) Inc. That it is not a Land Survey Plat or an Improvement Survey Plat and that it is not to be relied upon for establishment of fences, buildings, or other future improvement lines.



John Robert McGehee LS#38219  
 Well: File 32-17 WLC

**NOTICE:** According to Colorado law you MUST commence any legal action based upon any defect in this W.L.C. within three years after you first discover such defect. In no event may any action based upon any defect in this W.L.C. be commenced more than ten years from this said date of the certification shown hereon.