


Complete Well Summary

Complete Well Summary

HORIZONTAL - Original Hole, 7/7/2011 1:49:20 PM								
Vertical schematic (actual)								
	OD (in)	Item Des	Btm (ftKB)	Jts	ID (in)	Wt (kips)	Grade	Top Thread
	4 1/2	Blank Liner	8,437.8	1			P-110	
	4 1/2	Casing Joints	8,527.0	1	4.000	1.0	P-110	
	4 1/2	External Casing Packer	8,542.8	1			P-110	
	4 1/2	Casing Joints	8,626.5	1	4.000	1.0	P-110	
	4 1/2	Blank Liner	8,629.8	1			P-110	
	4 1/2	Casing Joints	8,716.5	1	4.000	1.0	P-110	
	4 1/2	External Casing Packer	8,732.3	1		0.2	P-110	
	4 1/2	Casing Joints	8,777.7	1	4.000	0.5	P-110	
	4 1/2	Blank Liner	8,781.0	1			P-110	
	4 1/2	Casing Joints	8,868.1	1	4.000	1.0	P-110	
	4 1/2	External Casing Packer	8,883.8	1			P-110	
	4 1/2	Casing Joints	8,929.0	1	4.000	0.5	P-110	
	4 1/2	Blank Liner	8,932.3	1			P-110	
	4 1/2	Casing Joints	9,016.8	1	4.000	1.0	P-110	
	4 1/2	External Casing Packer	9,032.6	1			P-110	
	4 1/2	Casing Joints	9,078.0	1	4.000	0.5	P-110	
	4 1/2	Blank Liner	9,081.3	1			P-110	
	4 1/2	Casing Joints	9,172.4	1	4.000	1.1	P-110	
	4 1/2	External Casing Packer	9,188.2	1			P-110	
	4 1/2	Casing Joints	10,151.0	1	4.000	11.2	P-110	
	4 1/2	Centralizer	10,151.6	1		0.0	P-110	
	4 1/2	Packer Hanger	10,155.0	1				
	4 1/2	PBR	10,170.0	1				
PRODUCTION, 10,170ftKB								
Run Date		Centralizers						String Min Drift (in)
6/8/2011		1						
OD (in)	Item Des	Btm (ftKB)	Jts	ID (in)	Wt (kips)	Grade	Top Thread	
5	Guide Shoe	5,816.5	1	0.750			LT&C	
5	Float Collar	5,817.6	1				LT&C	
5	Blank Liner	5,863.2		4.000	0.5	P-110	LT&C	
5	Float Collar	5,864.3					LT&C	
5	Blank Liner	5,909.6					LT&C	
5.42	PORT SUB	5,912.9		0.643			LT&C	
5	Blank Liner	5,998.6					LT&C	
5 3/4	PACKER	6,014.4					LT&C	
5	Blank Liner	6,099.1					LT&C	
5.42	PORT SUB	6,102.4		0.768			LT&C	
5	Blank Liner	6,188.6					LT&C	
5 3/4	PACKER	6,204.3					LT&C	
5	Blank Liner	6,293.7					LT&C	
5.42	PORT SUB	6,297.0		0.893			LT&C	
5	Blank Liner	6,384.5					LT&C	
5 3/4	PACKER	6,400.2					LT&C	
5	Blank Liner	6,491.6					LT&C	
5.42	PORT SUB	6,494.9		1.018			LT&C	
5	Blank Liner	6,585.6					LT&C	
5 3/4	PACKER	6,601.4					LT&C	
5	Blank Liner	6,689.5					LT&C	
5.42	PORT SUB	6,692.8		1.143			LT&C	
5	Blank Liner	6,774.3					LT&C	
5 3/4	PACKER	6,790.0					LT&C	
5	Blank Liner	6,879.8					LT&C	
5.42	PORT SUB	6,883.1		1.275			LT&C	
5	Blank Liner	6,971.0					LT&C	
5 3/4	PACKER	6,986.7					LT&C	
5	Blank Liner	7,076.8					LT&C	
5.42	PORT SUB	7,080.1		1.395			LT&C	
5	Blank Liner	7,165.7					LT&C	
5 3/4	PACKER	7,181.5					LT&C	
5	Blank Liner	7,269.9					LT&C	
5.42	PORT SUB	7,273.2		1.519			LT&C	
5	Blank Liner	7,361.6					LT&C	
5 3/4	PACKER	7,377.3					LT&C	
5	Blank Liner	7,465.9					LT&C	
5.42	PORT SUB	7,469.2		1.644			LT&C	
5	Blank Liner	7,555.3					LT&C	
5 3/4	PACKER	7,571.1					LT&C	
5	Blank Liner	7,662.2					LT&C	
5.42	PORT SUB	7,665.5		1.770			LT&C	
5	Blank Liner	7,756.2					LT&C	
5 3/4	PACKER	7,771.9					LT&C	
5	Blank Liner	7,860.3					LT&C	
5.42	PORT SUB	7,863.6		1.897			LT&C	
5	Blank Liner	7,953.7					LT&C	
5 3/4	PACKER	7,969.5					LT&C	
5	Blank Liner	8,052.3					LT&C	
5.42	PORT SUB	8,055.6		2.090			LT&C	
5	Blank Liner	8,138.0					LT&C	
5 3/4	PACKER	8,153.8					LT&C	
5	Blank Liner	8,240.3					LT&C	
5.42	PORT SUB	8,243.6		2.270			LT&C	
5	Blank Liner	8,330.6					LT&C	
5 3/4	PACKER	8,346.3					LT&C	
5	Blank Liner	8,434.5					LT&C	
5.42	PORT SUB	8,437.8		2.418			LT&C	
5	Blank Liner	8,527.0					LT&C	
5 3/4	PACKER	8,542.8					LT&C	
5	Blank Liner	8,626.5					LT&C	
5.42	PORT SUB	8,629.8		2.644			LT&C	
5	Blank Liner	8,716.5					LT&C	
5 3/4	PACKER	8,732.3					LT&C	
5	Blank Liner	8,777.7					LT&C	
5.42	PORT SUB	8,781.0		2.893			LT&C	
5	Blank Liner	8,868.1					LT&C	
5 3/4	PACKER	8,883.8					LT&C	
5	Blank Liner	8,929.0					LT&C	
5.42	PORT SUB	8,932.3		3.146			LT&C	
5	Blank Liner	9,016.8					LT&C	
5 3/4	PACKER	9,032.6					LT&C	
5	Blank Liner	9,078.0					LT&C	
5.42	PORT SUB	9,081.3		3.396			LT&C	

Complete Well Summary

Complete Well Summary

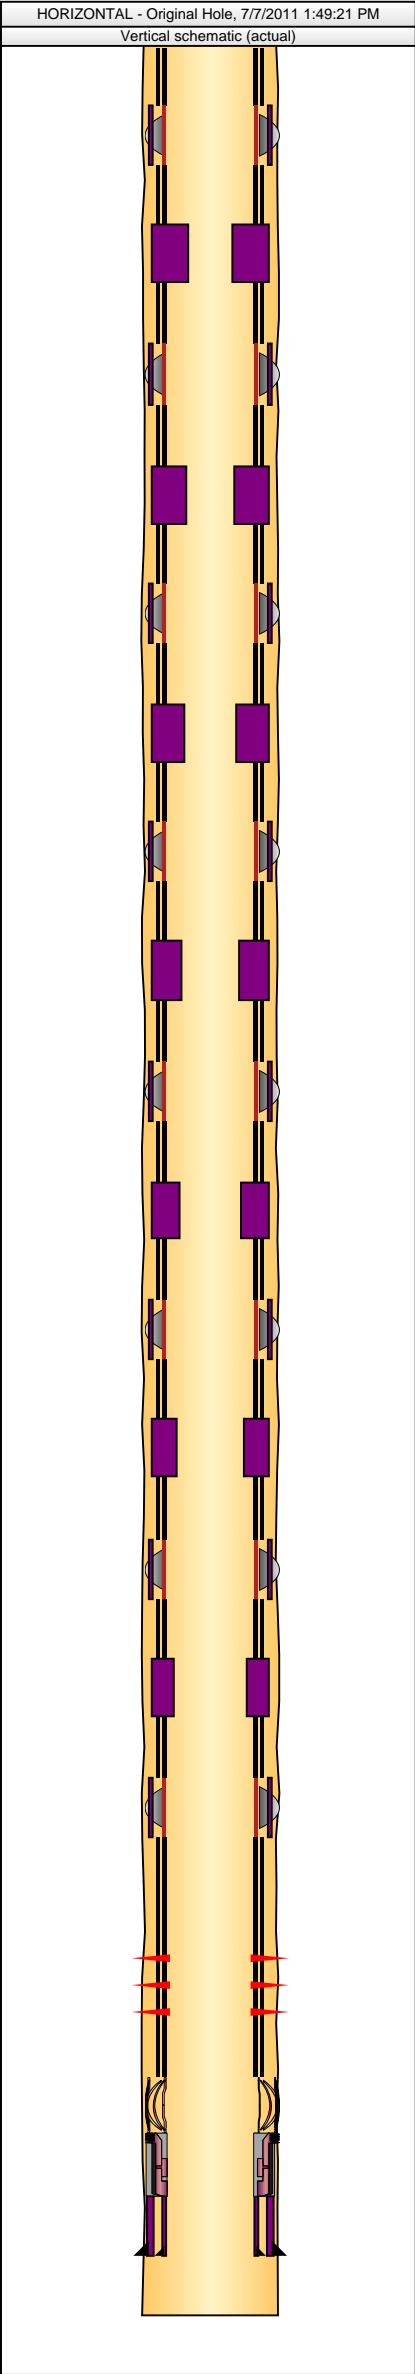

BHA #8, Steerable											
BHA #		Size (in)		Model		IADC Codes		IADC Bit Dull			
8		6 1/8		QD405		---		1-1-----0-1-TD			
Depth In (ftKB)		Depth Out (ftKB)		Depth Drilled (ft)		Drilling Time (hr)		Bit Hours Out (hr)			
6,788		10,192		3,404		101.00		101.00			
String Components											
Hughes QD405, 4" XT39 H WT DP, 4" XT39 DP, XO Sub, NMDC, MWD - Directional, Float Sub, Mud Motor - Bent Housing											
Job Category				Primary Job Type				Start Date		End Date	
COMPLETION/WORKOVER				COMPLETION				6/10/2011			
COMPLETION, 6/10/2011 07:00											
AFE Number		Total AFE + Supp Amount (Cost)			Total Field Estimate (Cost)			Total Final Invoice (Cost)			
310099		2,534,658.00			39,512.00						
Summary											
Phases											
						<i>Planned Likely Phase Cost (Cost)</i>		<i>PI Cum Days ML (days)</i>		<i>Planned End Depth (ftKB)</i>	
<i>Phase Type 1</i>											
Job Contacts											
<i>Contact Name</i>		<i>Company</i>			<i>Title</i>		<i>Office</i>		<i>Mobile</i>		
Kirk Williams		Schneider Energy Consulting			Consultant		970-867-9437		970-441-0257		
JOSHUA BERGER		J.B. INC.									
BHA #<stringno>, <des>											
BHA #		Size (in)		Model		IADC Codes		IADC Bit Dull			
Depth In (ftKB)		Depth Out (ftKB)		Depth Drilled (ft)		Drilling Time (hr)		Bit Hours Out (hr)		IADC Bit Dull	
String Components											
Job Category				Primary Job Type				Start Date		End Date	
Completion/Workover				Fracture Treatment				6/28/2011		6/29/2011	
Fracture Treatment, 6/28/2011 08:00											
AFE Number		Total AFE + Supp Amount (Cost)			Total Field Estimate (Cost)			Total Final Invoice (Cost)			
					3,202,590.82						
Summary											
Phases											
						<i>Planned Likely Phase Cost (Cost)</i>		<i>PI Cum Days ML (days)</i>		<i>Planned End Depth (ftKB)</i>	
<i>Phase Type 1</i>											
Job Contacts											
<i>Contact Name</i>		<i>Company</i>			<i>Title</i>		<i>Office</i>		<i>Mobile</i>		
KIRK WILLIAMS		SCHNEIDER ENERGY CONSULTING			WSS		970-573-3059		970-441-0257		
JEFF SCHNEIDER		SCHNEIDER ENERGY CONSULTING					970-573-3059				
JOSH BERGER											
BHA #<stringno>, <des>											
BHA #		Size (in)		Model		IADC Codes		IADC Bit Dull			
Depth In (ftKB)		Depth Out (ftKB)		Depth Drilled (ft)		Drilling Time (hr)		Bit Hours Out (hr)		IADC Bit Dull	
String Components											