

Noble Energy

Garfield County, CO (NAD 83)

Sec. 35-T7S-R95W (Battlement Mesa 35L PAD)

BM 34-43C (ABANDONED) - B9

Plan A

Design: Gyro and Sperry MWD Survey

Sperry Drilling Services

Final Survey Report

15 March, 2011

Well Coordinates: 1,577,305.50 N, 2,301,444.10 E (39° 23' 32.53" N, 107° 58' 19.40" W)

Ground Level: 9,211.00 ft

Local Coordinate Origin: Centered on Well BM 34-43C (ABANDONED) - Slot B

Viewing Datum: RKB 24' @ 9235.00ft (H&P 322)

TVDs to System: N

North Reference: Grid

Unit System: API - US Survey Feet - Custom

Geodetic Scale Factor Applied

Version: 2003.16 Build: 43I

HALLIBURTON

Design Report for BM 34-43C (ABANDONED) - Gyro and Sperry MWD Survey

Measured Depth (ft)	Inclination (°)	Azimuth (°)	Vertical Depth (ft)	+N/-S (ft)	+E/-W (ft)	Vertical Section (ft)	Dogleg Rate (°/100ft)
0.00	0.00	0.00	0.00	0.00	0.00	0.00	0.00
187.00	1.68	241.59	186.97	-1.30	-2.41	2.63	0.90
Surveys from 187.00ft to 524.00ft are Gyro Surveys							
249.00	3.05	267.97	248.92	-1.80	-4.86	5.12	2.77
341.00	5.47	262.66	340.66	-2.44	-11.66	11.91	2.66
432.00	7.50	277.45	431.08	-2.23	-21.85	21.85	2.87
524.00	8.97	264.99	522.14	-2.07	-34.95	34.64	2.50
Tie-On to Gyro Survey							
607.00	11.15	251.34	603.87	-5.21	-49.00	49.04	3.88
First Sperry MWD Survey							
698.00	13.16	251.97	692.82	-11.23	-67.19	68.07	2.21
790.00	14.97	248.88	782.06	-18.75	-88.23	90.20	2.13
881.00	16.67	252.66	869.61	-26.88	-111.66	114.79	2.18
973.00	17.30	257.86	957.60	-33.69	-137.63	141.60	1.79
1,067.00	18.47	261.61	1,047.06	-38.80	-166.03	170.44	1.75
1,161.00	18.47	263.49	1,136.22	-42.66	-195.55	200.14	0.63
1,256.00	19.64	263.85	1,226.02	-46.08	-226.38	231.02	1.24
1,350.00	19.21	263.15	1,314.66	-49.62	-257.44	262.15	0.52
1,444.00	18.57	261.68	1,403.60	-53.63	-287.60	292.50	0.85
1,538.00	18.37	259.84	1,492.76	-58.40	-316.99	322.25	0.66
1,633.00	19.02	260.60	1,582.75	-63.57	-347.00	352.69	0.73
1,727.00	18.70	258.08	1,671.70	-69.19	-376.86	383.06	0.93
1,822.00	18.16	257.15	1,761.83	-75.63	-406.19	413.09	0.65
1,916.00	19.12	258.79	1,850.90	-81.88	-435.57	443.13	1.16
2,010.00	18.07	260.59	1,939.99	-87.25	-465.06	473.09	1.27
2,105.00	18.13	258.37	2,030.29	-92.64	-494.07	502.60	0.73
2,199.00	18.37	258.21	2,119.56	-98.62	-522.90	532.04	0.26
2,293.00	19.41	260.70	2,208.50	-104.17	-552.81	562.45	1.40
2,388.00	19.63	262.18	2,298.04	-108.89	-584.20	594.15	0.57
2,482.00	19.18	259.61	2,386.70	-113.82	-615.03	625.34	1.03
2,577.00	19.95	261.37	2,476.22	-119.07	-646.40	657.13	1.02
2,671.00	19.25	260.84	2,564.77	-123.94	-677.56	688.62	0.77
2,765.00	18.79	260.64	2,653.64	-128.87	-707.79	719.23	0.49
2,860.00	18.36	258.59	2,743.69	-134.32	-737.55	749.48	0.82
2,954.00	18.10	259.20	2,832.97	-139.98	-766.41	778.88	0.34
3,048.00	17.67	261.62	2,922.43	-144.80	-794.87	807.73	0.91
3,143.00	17.47	262.20	3,013.00	-148.84	-823.26	836.35	0.28
3,237.00	16.92	262.03	3,102.80	-152.65	-850.79	864.08	0.59
3,270.00	16.90	262.02	3,134.37	-153.98	-860.29	873.65	0.06
Final Sperry MWD Survey							
3,332.00	16.90	262.02	3,193.69	-156.48	-878.14	891.64	0.00
Estimated BHL: 1906' FSL, 303' FEL - Survey Projection to TD of Sperry Directional Work							

Design Report for BM 34-43C (ABANDONED) - Gyro and Sperry MWD Survey**Design Annotations**

Measured Depth (ft)	Vertical Depth (ft)	Local Coordinates		Comment
		+N/-S (ft)	+E/-W (ft)	
187.00	186.97	-1.30	-2.41	Surveys from 187.00ft to 524.00ft are Gyro Surveys
524.00	522.14	-2.07	-34.95	Tie-On to Gyro Survey
607.00	603.87	-5.21	-49.00	First Sperry MWD Survey
3,270.00	3,134.37	-153.98	-860.29	Final Sperry MWD Survey
3,332.00	3,193.69	-156.48	-878.14	Estimated BHL: 1906' FSL, 303' FEL
3,332.00	3,193.69	-156.48	-878.14	Survey Projection to TD of Sperry Directional Work

Vertical Section Information

Angle Type	Target	Azimuth (°)	Origin Type	Origin		Start TVD (ft)
				+N/_S (ft)	+E/-W (ft)	
User	No Target (Freehand)	258.33	Slot	0.00	0.00	0.00

Survey tool program

From (ft)	To (ft)	Survey/Plan	Survey Tool
187.00	524.00	Gyro Surveys	NS-GYRO-MS
607.00	3,332.00	Sperry MWD Surveys	MWD

North Reference Sheet for Sec. 35-T7S-R95W (Battlement Mesa 35L PAD) - BM 34-43C (ABANDONED) - Plan A

All data is in US Feet unless otherwise stated. Directions and Coordinates are relative to Grid North Reference.

Vertical Depths are relative to RKB 24' @ 9235.00ft (H&P 322). Northing and Easting are relative to BM 34-43C (ABANDONED) - Slot B9

Coordinate System is US State Plane 1983, Colorado Central Zone using datum North American Datum 1983, ellipsoid GRS 1980

Projection method is Lambert Conformal Conic (2 parallel)

Central Meridian is 105° 30' 0.000 W°, Longitude Origin:0° 0' 0.000 E°, Latitude Origin:39° 45' 0.000 N°

False Easting: 3,000,000.00ft, False Northing: 1,000,000.00ft, Scale Reduction: 0.99994880


Grid Coordinates of Well: 1,577,305.50 ft N, 2,301,444.10 ft E

Geographical Coordinates of Well: 39° 23' 32.53" N, 107° 58' 19.40" W

Grid Convergence at Surface is: -1.56°

Based upon Minimum Curvature type calculations, at a Measured Depth of 3,332.00ft the Bottom Hole Displacement is 891.97ft in the Direction of 259.90° (Grid).

Magnetic Convergence at surface is: -11.97° (3 November 2010, , BGGM2010)

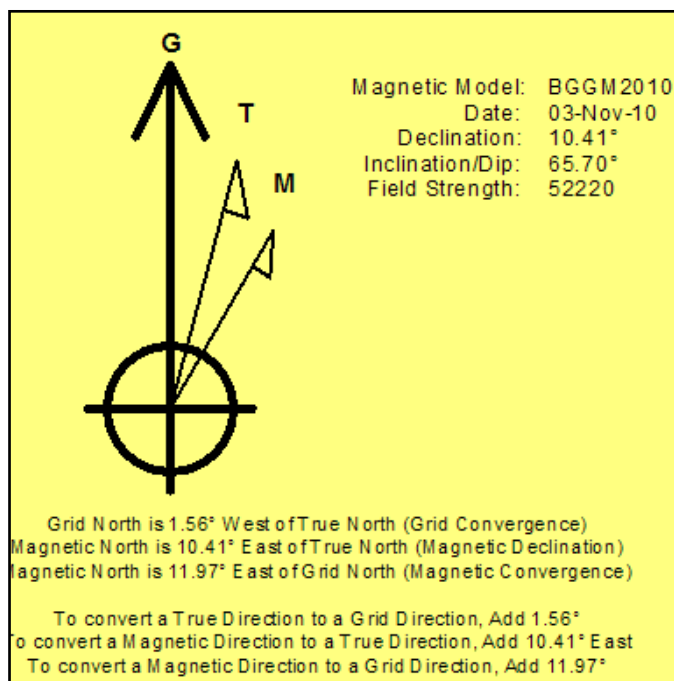

Noble Energy

Garfield County, CO (NAD 83)

Sec. 35-T7S-R95W (Battlement Mesa 35L PAD)

BM 34-43C - A6

Plan A

Design: Vaughn Gyro and Sperry MWD Survey

Sperry Drilling Services

Final Survey Report

15 March, 2011

Well Coordinates: 1,577,317.20 N, 2,301,464.80 E (39° 23' 32.65" N, 107° 58' 19.14" W)

Ground Level: 9,211.00 ft

Local Coordinate Origin:

Centered on Well BM 34-43C - Slot A6

Viewing Datum:

RKB 24' @ 9235.00ft

TVDs to System:

N

North Reference:

Grid

Unit System:

API - US Survey Feet - Custom

Geodetic Scale Factor Applied

Version: 2003.16 Build: 43I

HALLIBURTON

Design Report for BM 34-43C - Vaughn Gyro and Sperry MWD Survey

Measured Depth (ft)	Inclination (°)	Azimuth (°)	Vertical Depth (ft)	+N/-S (ft)	+E/-W (ft)	Vertical Section (ft)	Dogleg Rate (°/100ft)
0.00	0.00	0.00	0.00	0.00	0.00	0.00	0.00
191.00	0.49	202.78	191.00	-0.75	-0.32	0.47	0.26
Surveys from 191.00ft to 557.00ft are Vaughn Gyro Surveys							
282.00	2.58	266.12	281.96	-1.25	-2.51	2.72	2.64
312.00	2.96	292.76	311.93	-1.00	-3.90	4.02	4.43
374.00	3.12	287.76	373.84	0.14	-6.98	6.80	0.50
435.00	2.73	253.45	434.77	0.23	-9.96	9.69	2.89
465.00	2.63	249.01	464.73	-0.22	-11.28	11.08	0.77
557.00	3.84	277.97	556.59	-0.55	-16.30	16.06	2.17
Tie-On to Vaughn Gyro Survey							
610.00	4.98	249.43	609.44	-1.11	-20.22	20.01	4.60
First Sperry MWD Survey							
702.00	6.59	246.71	700.97	-4.60	-28.80	29.13	1.77
793.00	7.27	241.70	791.30	-9.40	-38.67	39.78	1.00
885.00	8.22	246.47	882.47	-14.78	-49.83	51.81	1.25
976.00	8.53	253.69	972.50	-19.27	-62.27	64.91	1.20
1,070.00	9.49	255.05	1,065.34	-23.23	-76.45	79.60	1.05
1,165.00	11.11	263.49	1,158.81	-26.29	-93.11	96.54	2.33
1,259.00	12.38	262.39	1,250.84	-28.65	-112.10	115.60	1.37
1,353.00	13.95	261.28	1,342.36	-31.70	-133.28	136.96	1.69
1,447.00	15.61	262.51	1,433.25	-35.07	-157.03	160.88	1.80
1,542.00	17.22	262.59	1,524.38	-38.55	-183.64	187.65	1.69
1,636.00	18.21	263.51	1,613.92	-42.00	-212.04	216.14	1.09
1,731.00	19.56	264.76	1,703.80	-45.14	-242.62	246.71	1.48
1,825.00	19.44	263.31	1,792.41	-48.39	-273.83	277.91	0.53
1,919.00	19.94	260.93	1,880.92	-52.74	-305.19	309.49	1.01
2,013.00	18.79	258.75	1,969.60	-58.22	-335.87	340.64	1.44
2,108.00	18.96	260.03	2,059.49	-63.88	-366.08	371.36	0.47
2,202.00	20.06	260.62	2,148.09	-69.15	-397.02	402.73	1.19
2,297.00	20.13	260.22	2,237.31	-74.58	-429.21	435.34	0.16
2,391.00	21.25	259.85	2,325.24	-80.33	-461.92	468.53	1.20
2,485.00	22.00	260.92	2,412.63	-86.11	-496.07	503.14	0.90
2,580.00	21.49	262.55	2,500.87	-91.18	-530.90	538.26	0.83
2,674.00	21.09	262.81	2,588.45	-95.53	-564.75	572.28	0.44
2,769.00	20.91	262.93	2,677.14	-99.75	-598.53	606.20	0.19
2,863.00	20.68	262.53	2,765.02	-103.98	-631.63	639.46	0.29
2,957.00	20.58	262.68	2,852.99	-108.24	-664.48	672.47	0.12
3,052.00	20.66	262.67	2,941.91	-112.51	-697.66	705.82	0.08
3,146.00	20.68	263.20	3,029.86	-116.59	-730.59	738.88	0.20
3,240.00	20.39	263.67	3,117.88	-120.36	-763.35	771.70	0.35
3,383.00	18.53	264.57	3,252.71	-125.25	-810.73	819.07	1.32
3,477.00	18.61	260.83	3,341.82	-129.06	-840.41	848.89	1.27
3,571.00	18.20	257.43	3,431.01	-134.64	-869.54	878.55	1.22
3,666.00	18.23	257.32	3,521.25	-141.13	-898.52	908.25	0.05
3,760.00	17.89	256.06	3,610.62	-147.84	-926.88	937.38	0.55
3,854.00	17.31	256.74	3,700.22	-154.53	-954.50	965.79	0.65
3,949.00	16.25	255.41	3,791.17	-161.12	-981.12	993.20	1.19
4,043.00	15.48	255.29	3,881.59	-167.61	-1,005.99	1,018.87	0.82
4,137.00	14.20	255.02	3,972.45	-173.78	-1,029.26	1,042.91	1.36
4,232.00	13.24	254.47	4,064.74	-179.70	-1,051.00	1,065.41	1.02

Design Report for BM 34-43C - Vaughn Gyro and Sperry MWD Survey

Measured Depth (ft)	Inclination (°)	Azimuth (°)	Vertical Depth (ft)	+N/-S (ft)	+E/-W (ft)	Vertical Section (ft)	Dogleg Rate (°/100ft)
4,326.00	12.59	254.28	4,156.36	-185.36	-1,071.23	1,086.37	0.69
4,421.00	11.78	251.37	4,249.22	-191.27	-1,090.39	1,106.34	1.07
4,515.00	10.93	256.29	4,341.39	-196.44	-1,108.14	1,124.78	1.37
4,609.00	10.50	254.39	4,433.75	-200.86	-1,125.04	1,142.23	0.59
4,703.00	10.30	260.61	4,526.21	-204.54	-1,141.58	1,159.18	1.21
4,798.00	9.47	258.77	4,619.79	-207.44	-1,157.63	1,175.47	0.93
4,892.00	8.72	254.92	4,712.61	-210.80	-1,172.10	1,190.32	1.03
4,986.00	8.21	260.50	4,805.59	-213.77	-1,185.60	1,204.14	1.03
5,081.00	7.08	264.68	4,899.75	-215.43	-1,198.12	1,216.74	1.32
5,175.00	6.72	266.35	4,993.06	-216.31	-1,209.37	1,227.93	0.44
5,269.00	5.40	271.65	5,086.54	-216.54	-1,219.28	1,237.67	1.52
5,364.00	3.26	272.17	5,181.26	-216.31	-1,226.45	1,244.64	2.25
5,458.00	3.06	274.11	5,275.12	-216.03	-1,231.62	1,249.64	0.24
5,552.00	2.92	269.63	5,368.99	-215.86	-1,236.52	1,254.39	0.29
5,647.00	2.62	267.56	5,463.88	-215.97	-1,241.11	1,258.91	0.33
5,741.00	2.26	262.79	5,557.79	-216.29	-1,245.09	1,262.87	0.44
5,836.00	2.63	258.00	5,652.71	-216.98	-1,249.09	1,266.92	0.44
5,930.00	2.59	268.95	5,746.61	-217.47	-1,253.32	1,271.16	0.53
6,024.00	2.51	264.00	5,840.52	-217.72	-1,257.49	1,275.29	0.25
6,118.00	2.32	259.06	5,934.43	-218.30	-1,261.40	1,279.24	0.30
6,212.00	2.50	259.94	6,028.35	-219.02	-1,265.29	1,283.19	0.20
6,307.00	1.21	230.04	6,123.30	-220.02	-1,268.10	1,286.15	1.65
6,401.00	0.88	233.62	6,217.29	-221.09	-1,269.44	1,287.68	0.36
6,495.00	0.81	213.39	6,311.28	-222.07	-1,270.39	1,288.81	0.32
6,590.00	0.89	221.53	6,406.26	-223.19	-1,271.25	1,289.88	0.15
6,684.00	0.68	201.23	6,500.26	-224.25	-1,271.93	1,290.78	0.37
6,778.00	0.89	246.96	6,594.25	-225.06	-1,272.81	1,291.80	0.68
6,873.00	0.85	249.46	6,689.24	-225.59	-1,274.15	1,293.22	0.06
6,967.00	0.86	219.77	6,783.23	-226.38	-1,275.25	1,294.46	0.47
7,061.00	1.04	231.77	6,877.21	-227.45	-1,276.37	1,295.78	0.28
7,156.00	0.65	296.13	6,972.21	-227.75	-1,277.53	1,296.98	1.01
7,250.00	0.91	303.51	7,066.20	-227.10	-1,278.63	1,297.92	0.30
7,344.00	0.82	293.32	7,160.19	-226.42	-1,279.87	1,298.99	0.19
7,439.00	0.47	263.72	7,255.18	-226.20	-1,280.88	1,299.94	0.50
7,533.00	1.24	204.52	7,349.17	-227.16	-1,281.69	1,300.93	1.15
7,627.00	1.47	206.94	7,443.14	-229.16	-1,282.66	1,302.29	0.25
7,722.00	1.55	211.01	7,538.11	-231.35	-1,283.87	1,303.93	0.14
7,816.00	1.70	208.07	7,632.07	-233.67	-1,285.18	1,305.69	0.18
7,910.00	1.81	206.01	7,726.03	-236.24	-1,286.49	1,307.51	0.13
8,005.00	1.81	197.07	7,820.98	-239.02	-1,287.59	1,309.16	0.30
8,099.00	1.80	186.63	7,914.94	-241.90	-1,288.20	1,310.35	0.35
8,193.00	2.05	180.04	8,008.88	-245.05	-1,288.37	1,311.17	0.35
8,288.00	1.76	180.88	8,103.83	-248.21	-1,288.39	1,311.85	0.31
8,382.00	1.05	161.43	8,197.80	-250.47	-1,288.14	1,312.07	0.90
8,476.00	1.74	173.23	8,291.77	-252.70	-1,287.70	1,312.10	0.79
8,570.00	0.86	174.97	8,385.75	-254.82	-1,287.47	1,312.32	0.94
8,665.00	0.91	177.08	8,480.74	-256.29	-1,287.36	1,312.52	0.06
8,759.00	0.49	194.06	8,574.73	-257.42	-1,287.42	1,312.82	0.49
8,853.00	0.65	188.82	8,668.72	-258.34	-1,287.60	1,313.18	0.18
8,948.00	0.53	187.01	8,763.72	-259.31	-1,287.74	1,313.52	0.13
9,042.00	0.36	244.64	8,857.72	-259.86	-1,288.06	1,313.95	0.48

Design Report for BM 34-43C - Vaughn Gyro and Sperry MWD Survey

Measured Depth (ft)	Inclination (°)	Azimuth (°)	Vertical Depth (ft)	+N/-S (ft)	+E/-W (ft)	Vertical Section (ft)	Dogleg Rate (°/100ft)
9,137.00	0.54	205.56	8,952.71	-260.40	-1,288.52	1,314.51	0.36
9,231.00	0.70	225.97	9,046.71	-261.20	-1,289.13	1,315.27	0.29
9,325.00	0.92	240.28	9,140.70	-261.97	-1,290.20	1,316.47	0.32
9,420.00	0.86	246.94	9,235.69	-262.63	-1,291.51	1,317.90	0.13
9,514.00	0.92	266.39	9,329.68	-262.95	-1,292.92	1,319.34	0.33
9,608.00	1.36	316.94	9,423.66	-262.18	-1,294.43	1,320.66	1.12
9,703.00	1.76	318.54	9,518.63	-260.27	-1,296.17	1,321.96	0.42
9,797.00	1.20	320.04	9,612.59	-258.43	-1,297.75	1,323.13	0.60
9,892.00	1.31	283.56	9,707.57	-257.41	-1,299.45	1,324.58	0.83
9,986.00	1.31	269.09	9,801.55	-257.18	-1,301.57	1,326.60	0.35
10,080.00	1.36	266.95	9,895.52	-257.25	-1,303.76	1,328.76	0.08
10,102.00	1.28	262.26	9,917.52	-257.30	-1,304.26	1,329.26	0.61
Final Sperry MWD Survey							
10,160.00	1.28	262.26	9,975.50	-257.47	-1,305.54	1,330.55	0.00
Survey Projection to TD - Estimated BHL: 1816' FSL, 709' FEL							

Design Annotations

Measured Depth (ft)	Vertical Depth (ft)	Local Coordinates		Comment
		+N/-S (ft)	+E/-W (ft)	
191.00	191.00	-0.75	-0.32	Surveys from 191.00ft to 557.00ft are Vaughn Gyro Surveys
557.00	556.59	-0.55	-16.30	Tie-On to Vaughn Gyro Survey
610.00	609.44	-1.11	-20.22	First Sperry MWD Survey
10,102.00	9,917.52	-257.30	-1,304.26	Final Sperry MWD Survey
10,160.00	9,975.50	-257.47	-1,305.54	Survey Projection to TD
10,160.00	9,975.50	-257.47	-1,305.54	Estimated BHL: 1816' FSL, 709' FEL

Vertical Section Information

Angle Type	Target	Azimuth (°)	Origin Type	Origin		Start TVD (ft)
				+N/-S (ft)	+E/-W (ft)	
Target	BM 34-43C Plan A0 BHL	258.02	Slot	0.00	0.00	0.00

Survey tool program

From (ft)	To (ft)	Survey/Plan	Survey Tool
191.00	557.00	Vaughn Gyro Surveys	NS-GYRO-MS
610.00	10,160.00	Sperry MWD Surveys	MWD

Design Report for BM 34-43C - Vaughn Gyro and Sperry MWD Survey

Targets

Target Name - hit/miss target - Shape	Dip Angle (°)	Dip Dir. (°)	TVD (ft)	+N/-S (ft)	+E/-W (ft)	Northing (ft)	Easting (ft)	Latitude	Longitude
BM 34-43C Plan A0	0.00	360.00	6,976.00	-275.91	-1,300.07	1,577,041.30	2,300,164.80	39° 23' 29.571 N	107° 58' 35.595 W
- actual wellpath misses target center by 53.18ft at 7159.73ft MD (6975.93 TVD, -227.73 N, -1277.57 E)									
- Rectangle (sides W200.00 H200.00 D3,051.00)									
BM 34-43C Plan A0	0.00	360.00	10,030.00	-275.91	-1,300.07	1,577,041.30	2,300,164.80	39° 23' 29.571 N	107° 58' 35.595 W
- actual wellpath misses target center by 57.79ft at 10160.00ft MD (9975.50 TVD, -257.47 N, -1305.54 E)									
- Point									
BM 34-43C Plan A0	0.00	360.00	6,976.00	-225.91	-1,250.07	1,577,091.30	2,300,214.79	39° 23' 30.078 N	107° 58' 34.976 W
- actual wellpath misses target center by 27.56ft at 7159.49ft MD (6975.69 TVD, -227.73 N, -1277.57 E)									
- Rectangle (sides W25.00 H25.00 D0.00)									

North Reference Sheet for Sec. 35-T7S-R95W (Battlement Mesa 35L PAD) - BM 34-43C - Plan A

All data is in US Feet unless otherwise stated. Directions and Coordinates are relative to Grid North Reference.

Vertical Depths are relative to RKB 24' @ 9235.00ft. Northing and Easting are relative to BM 34-43C - Slot A6

Coordinate System is US State Plane 1983, Colorado Central Zone using datum North American Datum 1983, ellipsoid GRS 1980

Projection method is Lambert Conformal Conic (2 parallel)

Central Meridian is 105° 30' 0.000 W°, Longitude Origin:0° 0' 0.000 E°, Latitude Origin:39° 45' 0.000 N°

False Easting: 3,000,000.00ft, False Northing: 1,000,000.00ft, Scale Reduction: 0.99994881


Grid Coordinates of Well: 1,577,317.20 ft N, 2,301,464.80 ft E

Geographical Coordinates of Well: 39° 23' 32.65" N, 107° 58' 19.14" W

Grid Convergence at Surface is: -1.56°

Based upon Minimum Curvature type calculations, at a Measured Depth of 10,160.00ft the Bottom Hole Displacement is 1,330.69ft in the Direction of 258.84° (Grid).

Magnetic Convergence at surface is: -11.97° (2 November 2010, , BGGM2010)

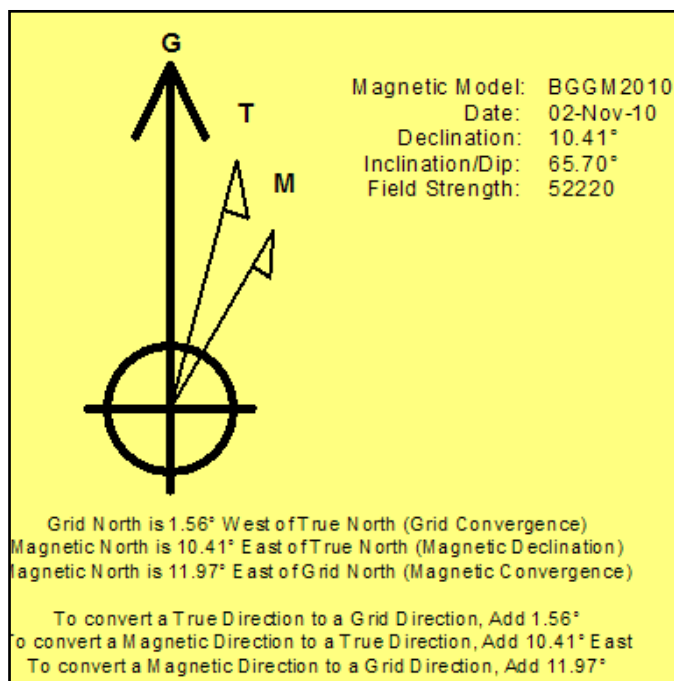


Project: Garfield County, CO (NAD 83)
 Site: Sec. 35-T7S-R95W (Battlement Mesa 35L PAD)
 Well: BM 34-43C

Noble Energy

HALLIBURTON

Sperry Drilling

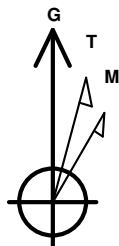


Azimuths to Grid North
 True North: 1.56°
 Magnetic North: 11.97°


Magnetic Field
 Strength: 52220.3snT
 Dip Angle: 65.70°
 Date: 11/2/2010
 Model: BGGM2010

LEGEND

- BM 34-43C, Plan A, Plan A rev1 V0
- BM 34-43C (ABANDONED), Plan A, Gyro and Sperry MWD Survey V0
- Vaughn Gyro and Sperry MWD Survey

Halliburton Energy Services, Inc. ("Halliburton") recently completed directional drilling and MWD operations at the Battlement Mesa 34-43C well located at Garfield County, CO. At the conclusion of the job Halliburton performed a final survey on the well. Noble Energy has requested that Halliburton provide them the distances from BHL to section lines from that final survey to allow Noble Energy to meet its requirements under Colorado law. These distances are generated by a mathematical algorithm based on rough data collected after the well is drilled. Halliburton considers it to be a rough estimate only and it is not to be relied upon in any application where accurate data is required. In consideration for Halliburton releasing this data to Noble Energy, Noble Energy agrees to release Halliburton from any consequences of it or anyone else relying on such data.

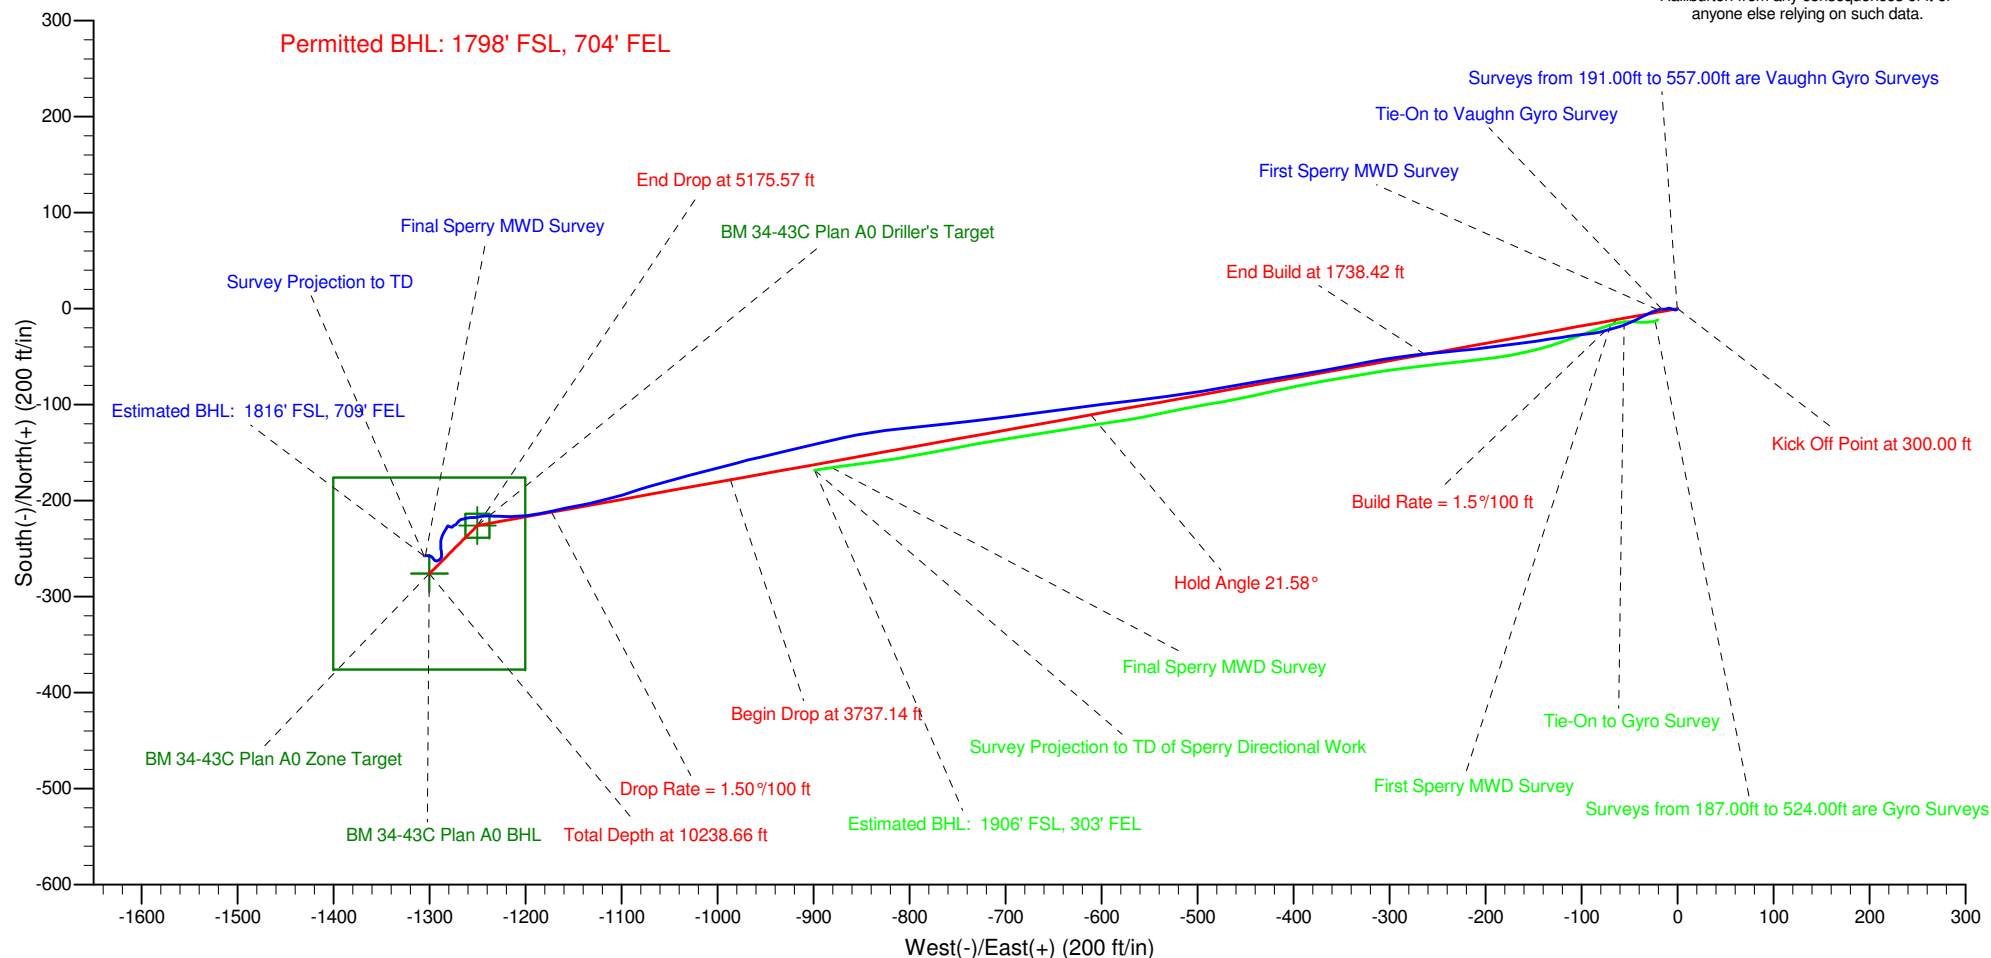

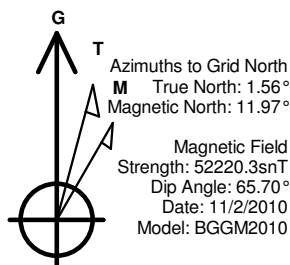

LEGEND

- BM 34-43C, Plan A, Plan A rev1 V0
- BM 34-43C (ABANDONED), Plan A, Gyro and Sperry MWD Survey
- Vaughn Gyro and Sperry MWD Survey

Halliburton Energy Services, Inc. ("Halliburton") recently completed directional drilling and MWD operations at the Battlement Mesa 34-43C well located at Garfield County, CO. At the conclusion of the job Halliburton performed a final survey on the well. Noble Energy has requested that Halliburton provide them the distances from BHL to section lines from that final survey to allow Noble Energy to meet its requirements under Colorado law. These distances are generated by a mathematical algorithm based on rough data collected after the well is drilled. Halliburton considers it to be a rough estimate only and it is not to be relied upon in any application where accurate data is required. In consideration for Halliburton releasing this data to Noble Energy, Noble Energy agrees to release Halliburton from any consequences of it or anyone else relying on such data.

