


KING SURVEYORS, INC.

650 E. GARDEN DR.

WINDSOR, CO 80550

# SITE SKETCH SWD #C7b

SECTION: 34  
TOWNSHIP: 7N  
RANGE: 63W

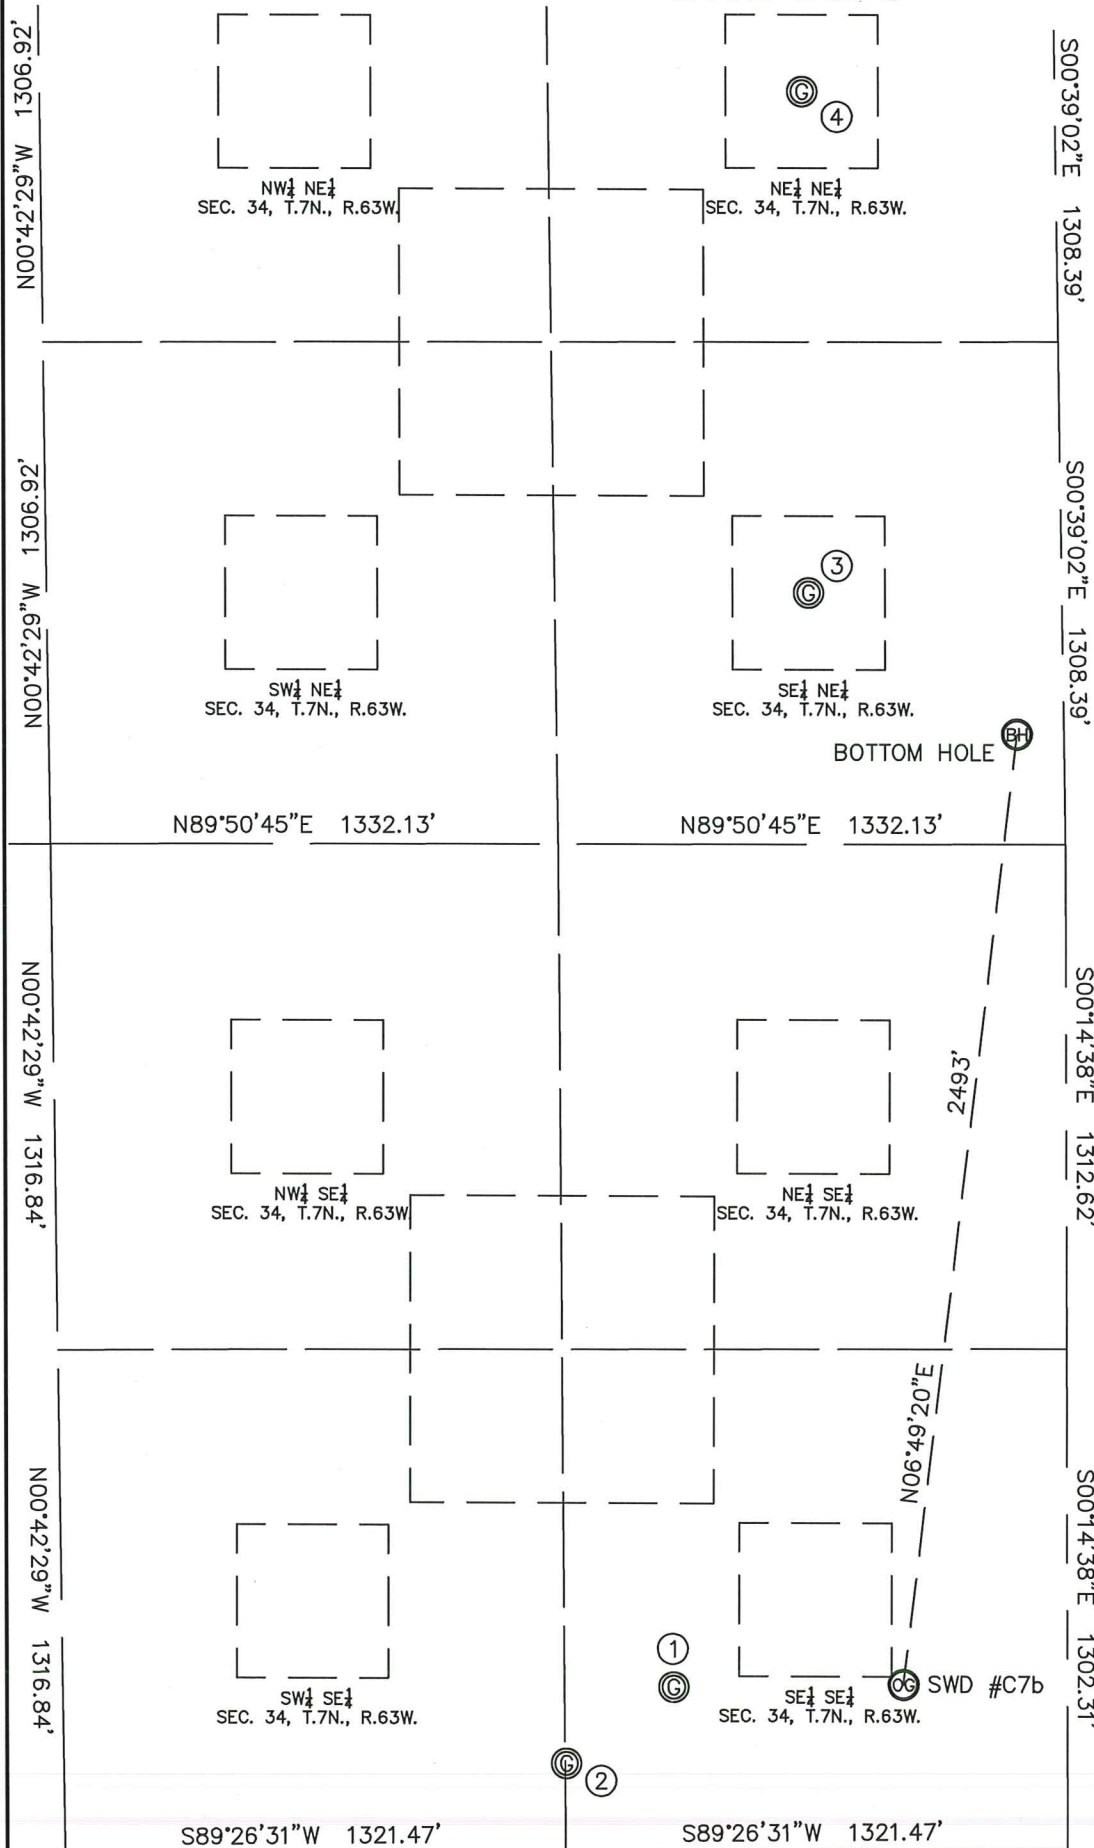


①  
SWD #C7a  
SE1/4 SE1/4  
427' FSL  
1035' FEL  
LAT-40.52414°N  
LONG-104.41672°W  
PDOP:1.4  
ELEV: 4713'

②  
WILSON 34-34H  
SE1/4 SE1/4  
230' FSL  
1318' FEL  
LAT-40.52360°N  
LONG-104.41775°W  
PDOP:2.1  
ELEV: 4714'

③  
WAHLERT 42-34  
SE1/4 NE1/4  
1962' FNL  
667' FEL  
LAT-40.53195°N  
LONG-104.41534°W  
PDOP:1.3  
ELEV: 4720'

④  
WAHLERT 41-34  
NE1/4 NE1/4  
654' FNL  
667' FEL  
LAT-40.53554°N  
LONG-104.41533°W  
PDOP:1.4  
ELEV: 4735'

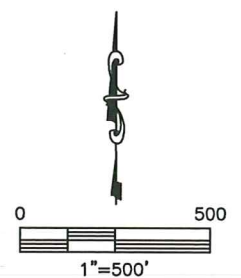

PROJECT#: 2010142