WEBER 32-04

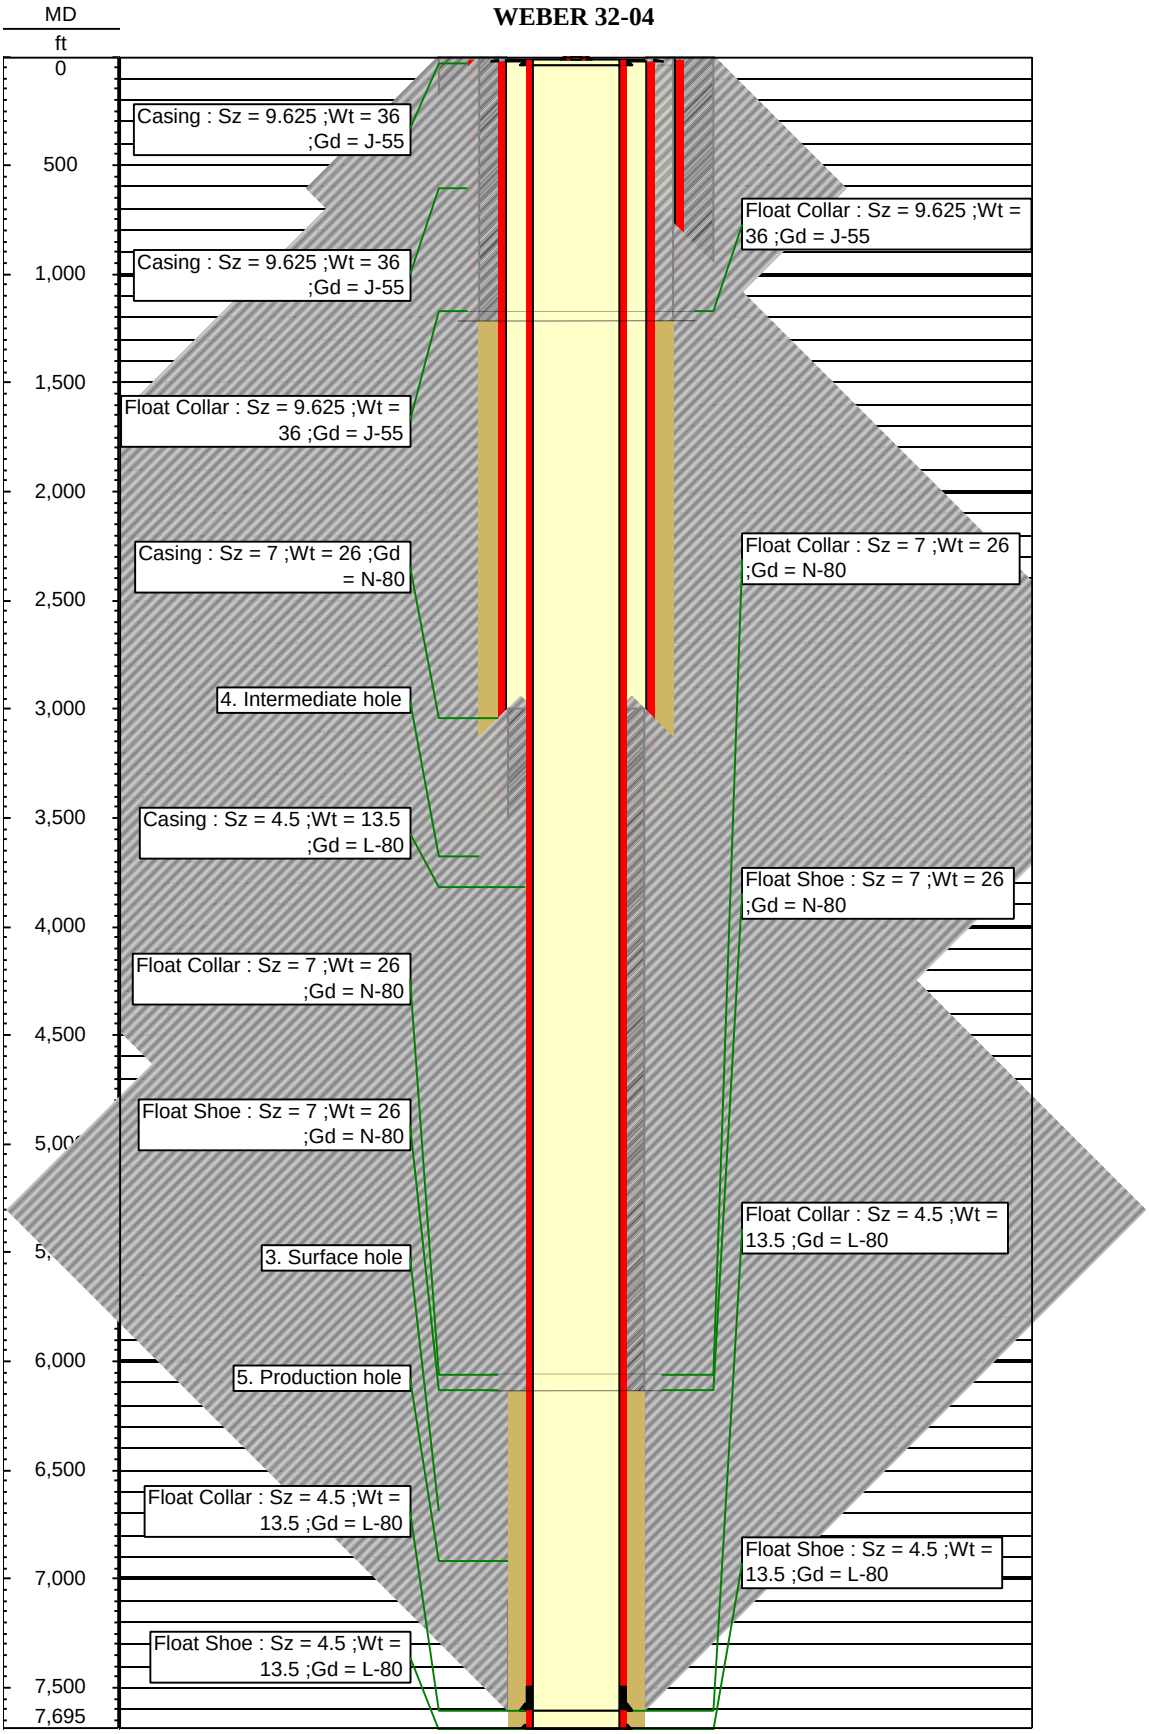
MD
ft
0
500
1,000
1,500
2,000
2,500
3,000
3,500
4,000
4,500
5,000
5,
6,000
6,500
7,000
7,500
7,695
Casing : Sz = 9.625 ;Wt = 36 ;Gd = J-55
Casing : Sz = 9.625 ;Wt = 36 ;Gd = J-55
Float Collar : Sz = 9.625 ;Wt = 36 ;Gd = J-55
Float Collar : Sz = 9.625 ;Wt = 36 ;Gd = J-55
Casing : Sz = 7 ;Wt = 26 ;Gd = N-80
Float Collar : Sz = 7 ;Wt = 26 ;Gd = N-80
4. Intermediate hole
Casing : Sz = 4.5 ;Wt = 13.5 ;Gd = L-80
Float Shoe : Sz = 7 ;Wt = 26 ;Gd = N-80
Float Collar : Sz = 7 ;Wt = 26 ;Gd = N-80
Float Shoe : Sz = 7 ;Wt = 26 ;Gd = N-80
Float Collar : Sz = 4.5 ;Wt = 13.5 ;Gd = L-80
3. Surface hole
5. Production hole
Float Collar : Sz = 4.5 ;Wt = 13.5 ;Gd = L-80
Float Shoe : Sz = 4.5 ;Wt = 13.5 ;Gd = L-80
Float Shoe : Sz = 4.5 ;Wt = 13.5 ;Gd = L-80