

KING SURVEYORS, INC. 650 E. GARDEN DR. WINDSOR, CO 80550
WELL LOCATION CERTIFICATE

MEIS 32-8B


SECTION: 8
 TOWNSHIP: 1N
 RANGE: 46W

THIS MAP DOES NOT REPRESENT A BOUNDARY SURVEY

FOUND #5 REBAR WITH
 1 1/2" ILLEGIBLE ALUMINUM CAP
 SET 3 1/4" ALUM CAP ON
 FOUND #5 REBAR LS 38106, 2011

SET #6 REBAR WITH
 3 1/4" ALUMINUM CAP
 LS 38106, 2011

FOUND 3/4" DIA BAR WITH
 3 1/4" ALUMINUM CAP
 LS 26602

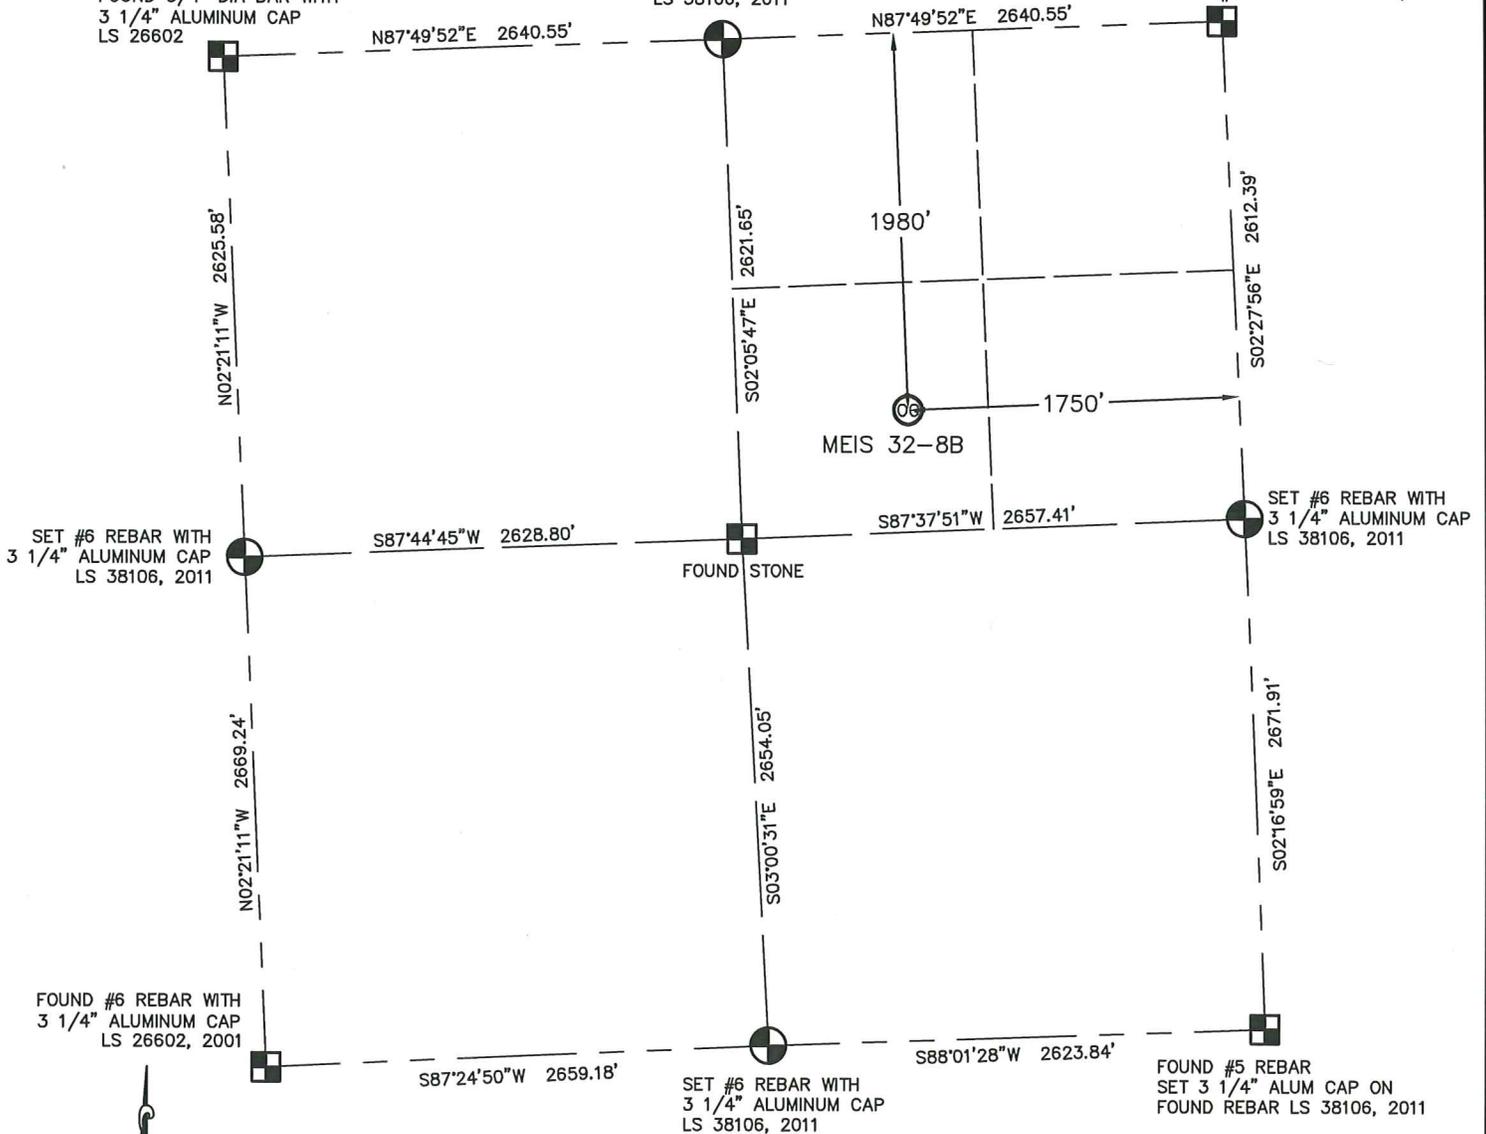

In accordance with a request from DAVID LEDEI with NOBLE ENERGY INC.
 King Surveyors Inc. has determined the surface location of MEIS 32-8B to be 1980' from the NORTH line and 1750' from the EAST line, as measured at right angles, from the section lines of Section 8, Township 1 North, Range 46 West of the Sixth Principal Meridian, County of Yuma, State of Colorado.

I hereby state that this Well Location Certificate was prepared by me, or under my direct supervision, that the fieldwork was completed on 7-12-2011, for and on behalf of NOBLE ENERGY INC. That this is not a Land Survey Plat or an Improvement Survey Plat, and that it is not to be relied upon for establishment of fence, building, or other future improvement lines.

SURFACE LOCATION
 LATITUDE: 40.07017°N
 LONGITUDE: 102.53609°W
 PDOP: 1.5
 ELEV: 3966'
 1/4,1/4: SW1/4 NE1/4
 NEAREST PROPERTY LINE: 671' NORTH

- NOTE:
- 1) Bearings shown are Grid Bearings of the Colorado State Plane Coordinate System, North Zone, North American Datum 1983/2007. The lineal dimensions as contained herein are based upon the "U.S. Survey Foot."
 - 2) Ground elevations are based on an observed GPS elevation (NAVD 1988 DATUM).
 - 3) IMPROVEMENTS: See LOCATION DRAWING exhibit for all visible improvements within 400' of disturbed area.
 - 4) SURFACE USE: PASTURE
 - 5) OPERATOR: JEFF POZVEK

LEGEND

- = FOUND ALIQUOT MONUMENT AS DESCRIBED
- = CALCULATED POSITION
- = SET ALIQUOT MONUMENT AS DESCRIBED

NOTE
 According to Colorado law, you must commence any legal action based upon any defect in this W.L.C. within three years after you discover such defect. In no event, may any action based upon any defect in this survey be commenced more than ten years after the date of the certificate shown hereon. (13-80-105 C.R.S.)

Michael Chad Dilka - On Behalf of King Surveyors, Inc.
 Colorado Licensed Professional Land Surveyor #38106
 PROJECT#: 2011299