




Lease Name: M&T # 10DD

Legals: SWSE –

Sec. 2110, T6N, R65W

County: Weld County, Colorado

API#: 05-123-31724

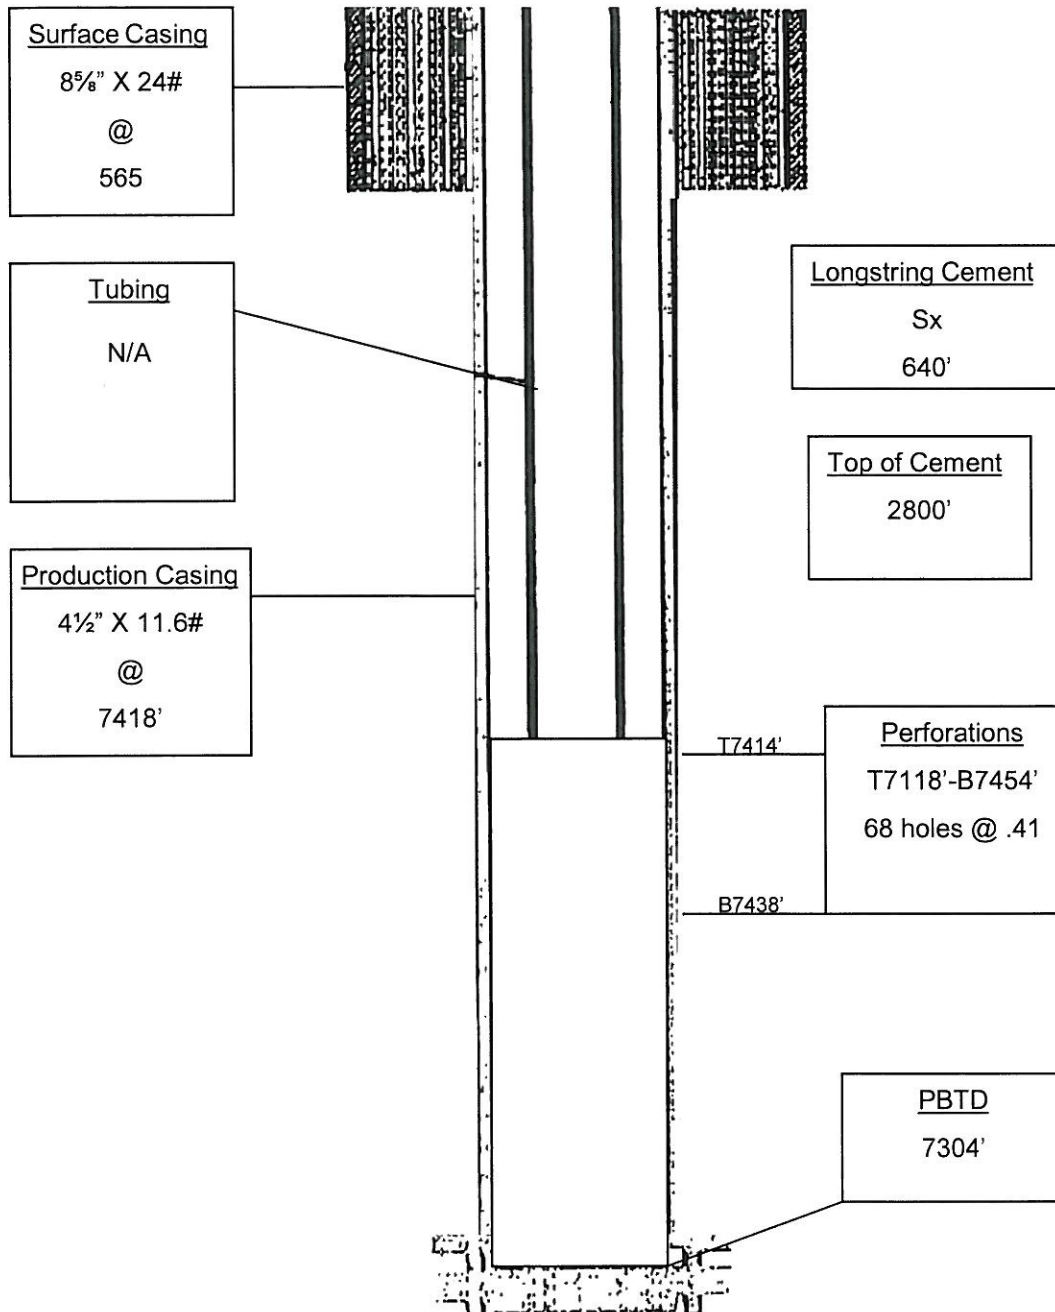

Wellbore Diagram