


# WELL LOCATION CERTIFICATE

SECTION: 19  
TOWNSHIP: 3N  
RANGE: 64W


THIS MAP DOES NOT REPRESENT A BOUNDARY SURVEY

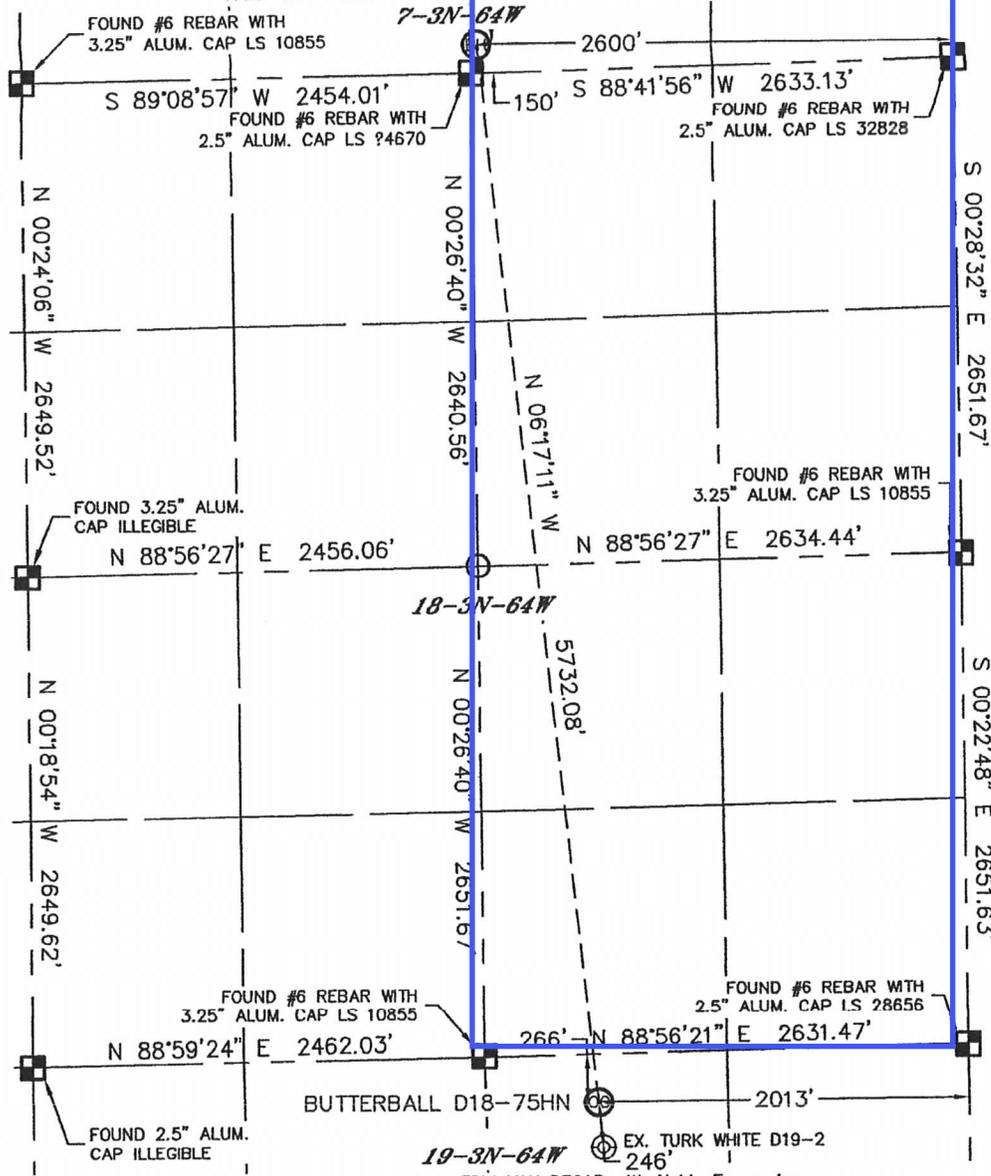

In accordance with a request from **ERIK VAN DECAR** with **Noble Energy Inc.** Lat40°, LLC has determined the surface location of the **BUTTERBALL D18-75HN** to be 266' from the NORTH line and 2013' from the EAST line as measured at right angles from the section lines of **Section 19, Township 3 North, Range 64 West** and the bottom hole to be 150' from the SOUTH line and 2600' from the EAST line as measured at right angles from the section lines of **Section 7, Township 3 North, Range 64 West** of the Sixth Principal Meridian, County of Weld, State of Colorado.

I hereby state that this Well Location Certificate was prepared by me, or under my direct supervision, that the fieldwork was completed on 11-15-10, for and on behalf of **Noble Energy Inc.** That this is not a Land Survey Plat or an Improvement Survey Plat, and that it is not to be relied upon for establishment of fence, building, or other future improvement lines.

<b>SURFACE LOCATION</b>	<b>BOTTOM HOLE</b>
LATITUDE: 40.21728°N	LATITUDE: 40.23294°N
LONGITUDE: 104.59165°W	LONGITUDE: 104.59369°W
PDOP: 2.8	
ELEV: 4772	
1/4,1/4: NW1/4NE1/4	
NEAREST PROPERTY LINE: 266' NORTH	

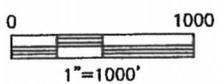

**NOTE:**

- 1) Bearings shown are Grid Bearings of the Colorado State Plane Coordinate System, North Zone, North American Datum 1983/2007. The lineal dimensions as contained herein are based upon the "U.S. Survey Foot."
- 2) Ground elevations are based on an observed GPS elevation (NAVD 1988 DATUM).
- 3) NEAREST EXISTING WELL: **TURK WHITE D19-2 246'**
- 4) IMPROVEMENTS: See **LOCATION DRAWING** for all visible improvements within 400' of disturbed area.
- 5) SURFACE USE: RANGELAND
- 6) INSTRUMENT OPERATOR: **BRIAN BRINKMAN**

**NOTE**  
According to Colorado law, you must commence any legal action based upon any defect in this W.L.C. within three years after you discover such defect. In no event, may any action based upon any defect in this survey be commenced more than ten years after the date of the certificate shown hereon. (13-80-105 C.R.S.)

**LEGEND**

- = ALIQUOT MONUMENT AS DESCRIBED
- = CALCULATED POSITION

*SHEET 1 OF 3*

Brian T. Brinkman—On behalf of **Lat40°, LLC**  
Colorado Licensed Professional  
Land Surveyor No. 38175 PROJECT#: 2010139

