


Lat40°, LLC 1635 Foxtrail Drive, Suite 325 Loveland, CO 80538

WELL LOCATION CERTIFICATE

SECTION: 19
TOWNSHIP: 3N
RANGE: 64W

THIS MAP DOES NOT REPRESENT A BOUNDARY SURVEY

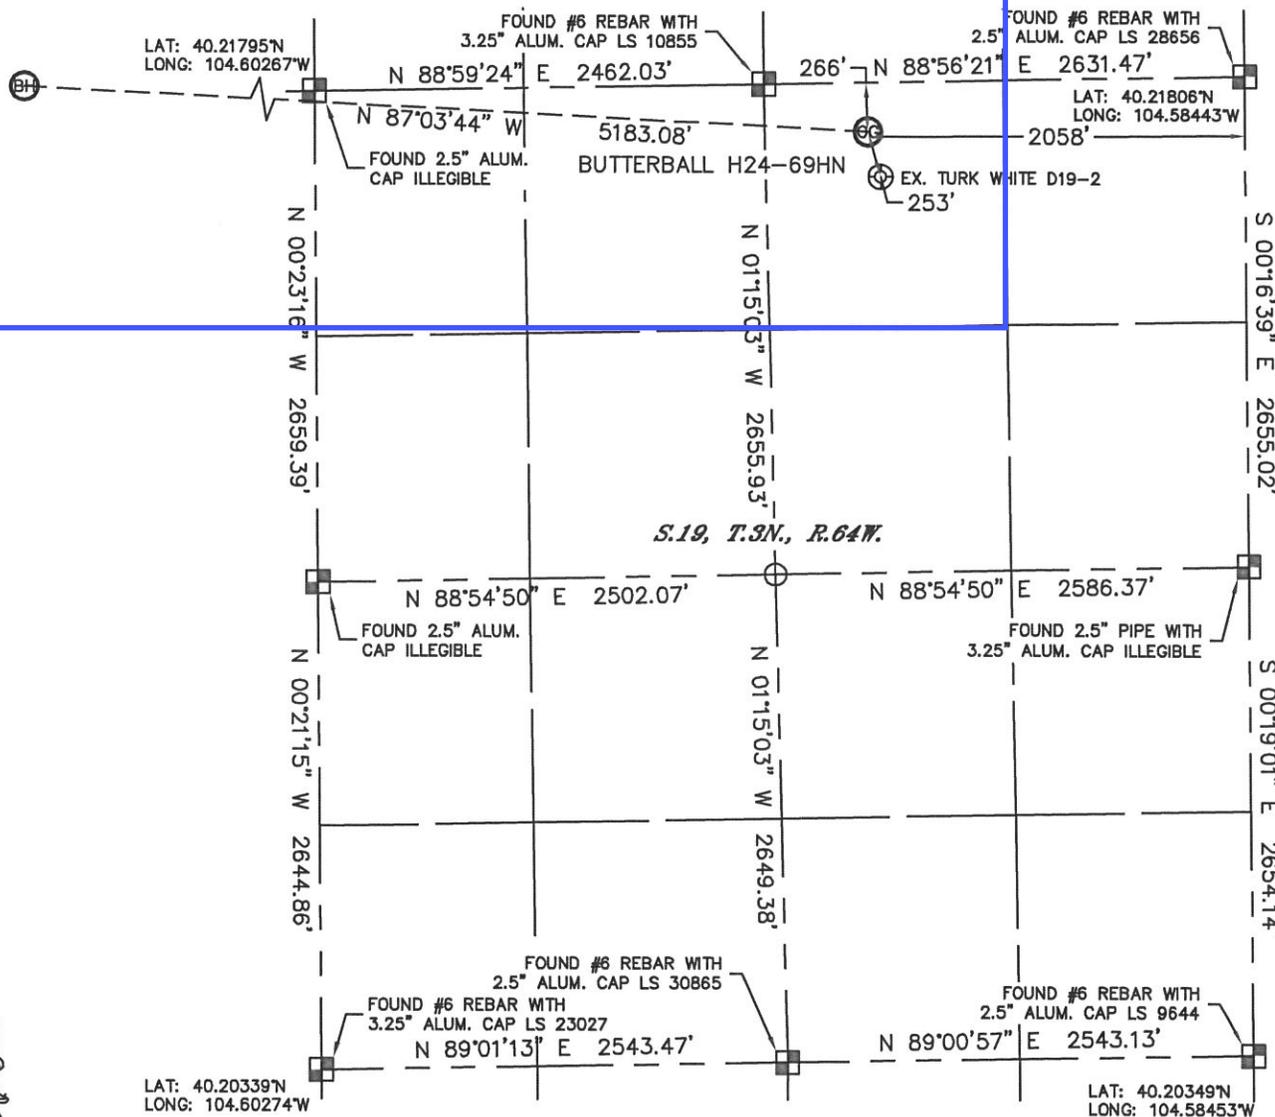

S.19, T.3N., R.64W.

In accordance with a request from ERIK VAN DECAR with Noble Energy Inc. Lat40°, LLC has determined the surface location of the BUTTERBALL H24-69HN to be 266' from the NORTH line and 2058' from the EAST line as measured at right angles from the section lines of Section 19, Township 3 North, Range 64 West and the bottom hole to be 75' from the SOUTH line and 2140' from the EAST line as measured at right angles from the section lines of Section 13, Township 3 North, Range 65 West of the Sixth Principal Meridian, County of Weld, State of Colorado.

I hereby state that this Well Location Certificate was prepared by me, or under my direct supervision, that the fieldwork was completed on 11-15-10, for and on behalf of Noble Energy Inc. That this is not a Land Survey Plat or an Improvement Survey Plat, and that it is not to be relied upon for establishment of fence, building, or other future improvement lines.

NOTE:

- 1) Bearings shown are Grid Bearings of the Colorado State Plane Coordinate System, North Zone, North American Datum 1983/2007. The lineal dimensions as contained herein are based upon the "U.S. Survey Foot."
- 2) Ground elevations are based on an observed GPS elevation (NAVD 1988 DATUM).
- 3) NEAREST EXISTING WELL: TURK WHITE D19-2 253'
- 4) IMPROVEMENTS: See LOCATION DRAWING for all visible improvements within 400' of disturbed area.
- 5) SURFACE USE: RANGELAND
- 6) INSTRUMENT OPERATOR: BRIAN BRINKMAN

SURFACE LOCATION	BOTTOM HOLE
LATITUDE: 40.21728°N	LATITUDE: 40.21815°N
LONGITUDE: 104.59181°W	LONGITUDE: 104.61033°W
PDOP: 2.7	
ELEV: 4774	
1/4, 1/4: NW1/4NE1/4	
NEAREST PROPERTY LINE: 266' NORTH	

NOTE

According to Colorado law, you must commence any legal action based upon any defect in this W.L.C. within three years after you discover such defect. In no event, may any action based upon any defect in this survey be commenced more than ten years after the date of the certificate shown hereon. (13-80-105 C.R.S.)

LEGEND

-  = ALIQUOT MONUMENT AS DESCRIBED
-  = CALCULATED POSITION

PROJECT#: 2010139