


Footages for *Marla 33-20* (*Apishipa River Ranches Subdivision*)

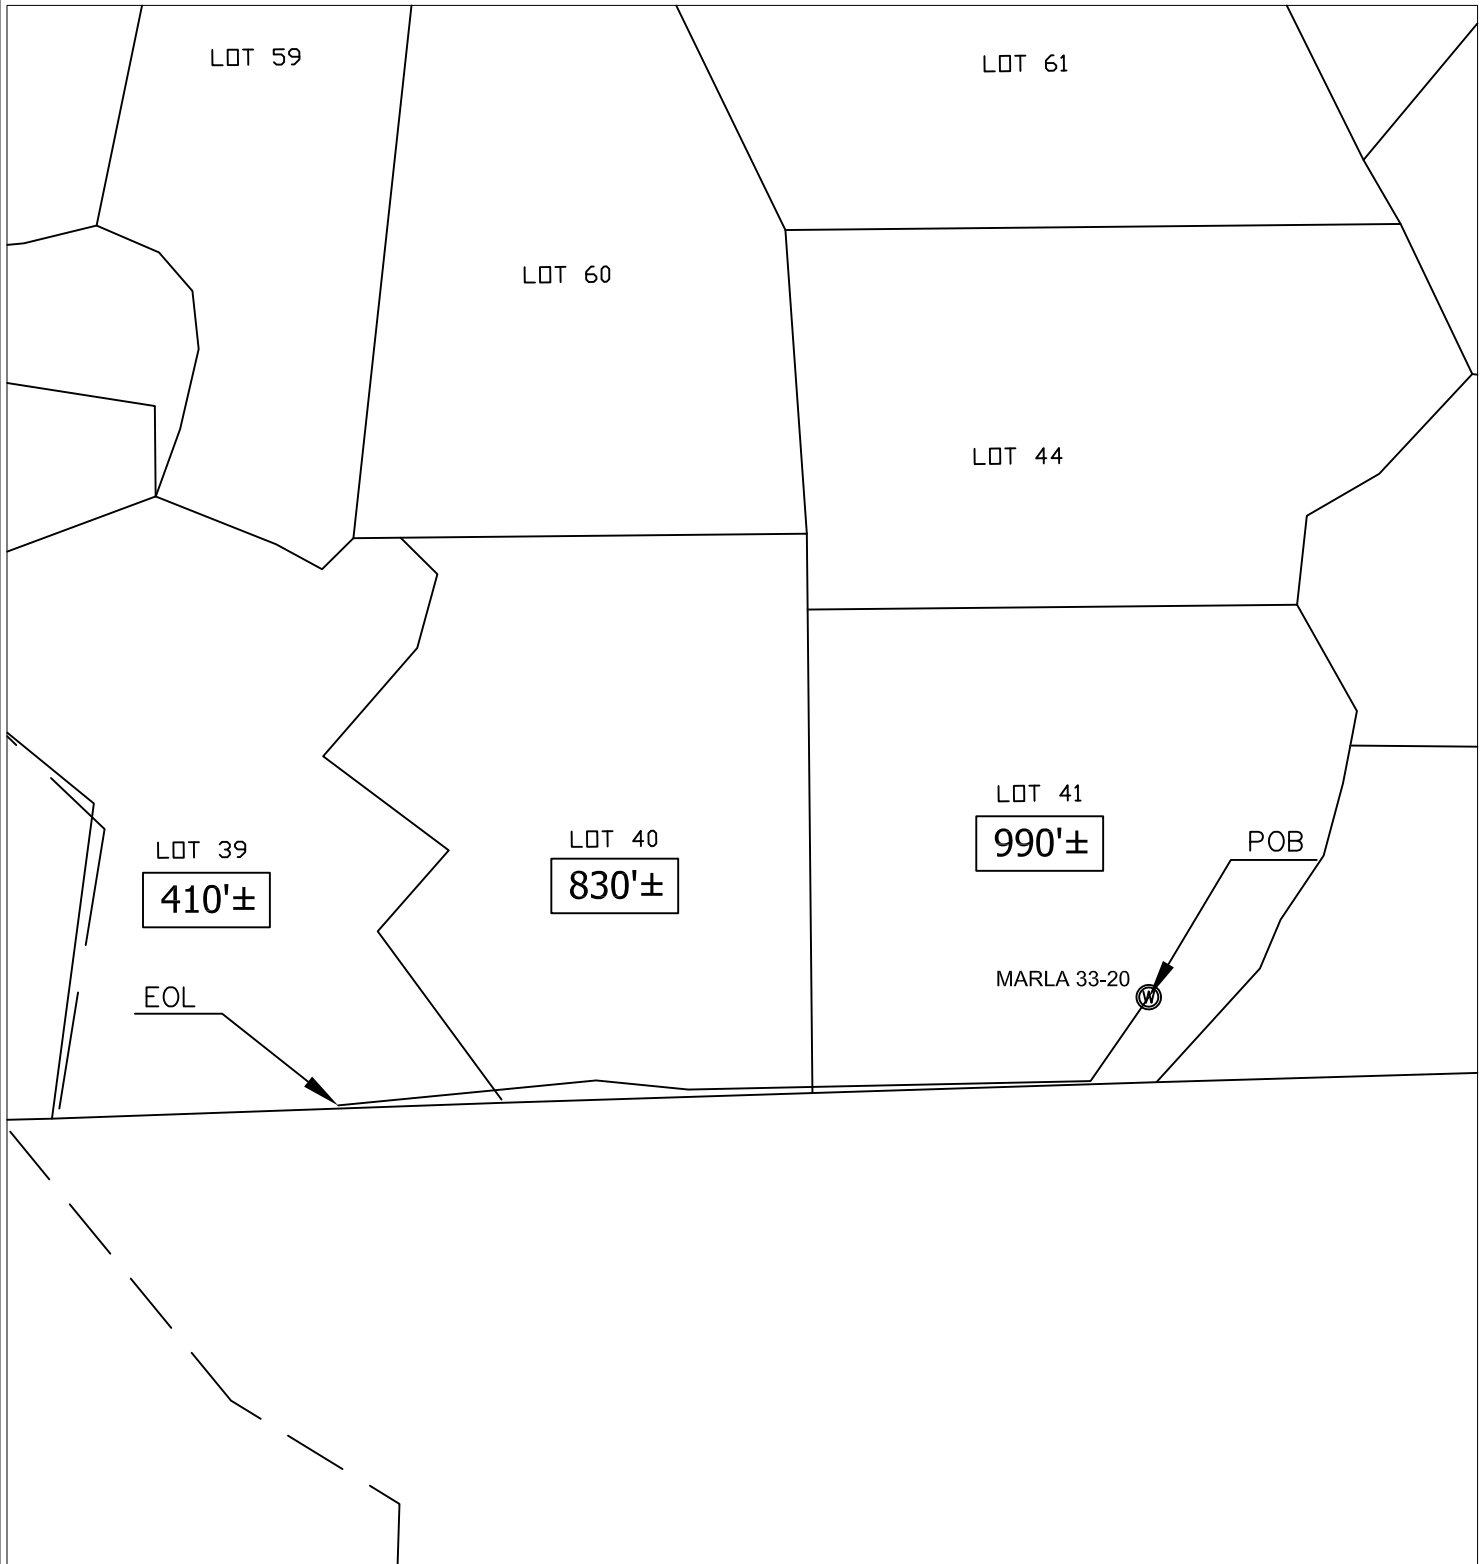


NOTE:

FOOTAGES GIVEN ARE ONLY ESTIMATES BASED ON SUBDIVISION PLATS AND TIED TO EXISTING CONTROL. A FULL BOUNDARY SURVEY IS REQUIRED TO DETERMINE TRUE SUBDIVISION LOT LOCATIONS AND DISTANCES.

DATE: July 07, 2011

GRAPHIC SCALE

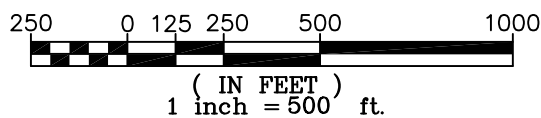

SHIELDS SURVEY L^{td}. Co.
Raton, New Mexico 87740
(575)445-1232