



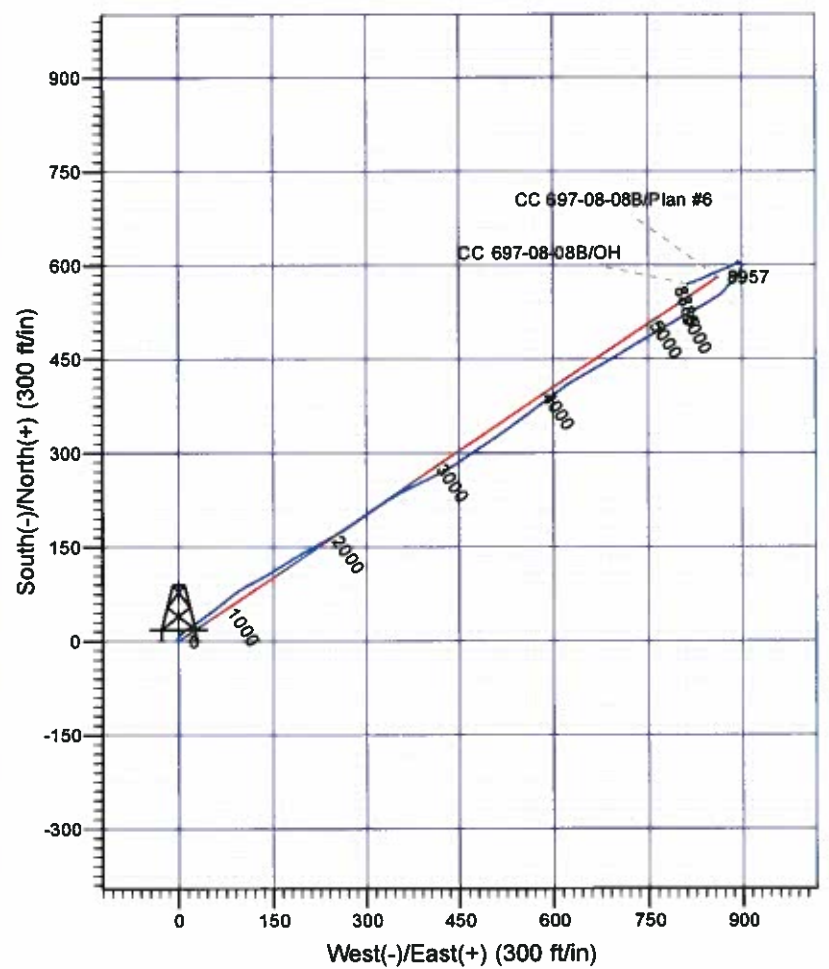

**Scientific Drilling**  
Rocky Mountain Operations

Company: OXY USA RMAT  
Project: Garfield County, CO NAD27  
Site: Cascade Creek 608-41 Pad  
Well: CC 697-08-08B  
Wellbore: OH  
Design: OH

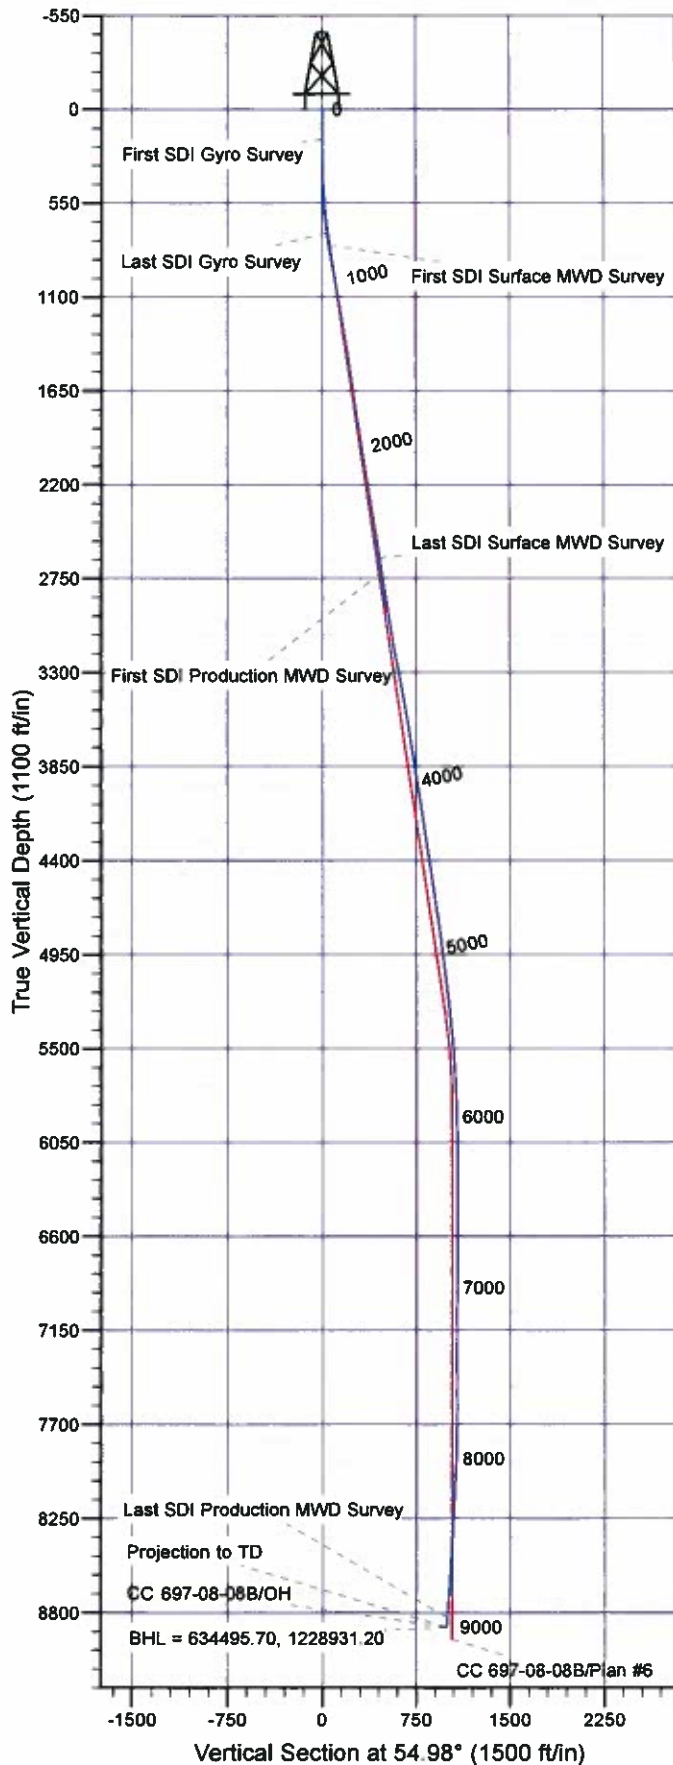

#### Well Details: CC 697-08-08B

+N/-S	+E/-W	Northing	Easting	Latitude	Longitude	Slot
0.00	0.00	633951.10	1228101.96	39° 32' 31.509 N	108° 14' 14.704 W	1

#### REFERENCE INFORMATION

Co-ordinate (N/E) Reference: Well CC 697-08-08B - Slot 1, True North  
Vertical (TVD) Reference: GL 8407' & RBK 30' @ 8437.00ft (H&P)  
Section (VS) Reference: Slot - I(0.00N, 0.00E)  
Measured Depth Reference: GL 8407' & RBK 30' @ 8437.00ft (H&P)  
Calculation Method: Minimum Curvature

#### PROJECT DETAILS: Garfield County, CO NAD27

Geodetic System: US State Plane 1927 (Exact solution)  
Datum: NAD 1927 (NADCON CONUS)  
Ellipsoid: Clarke 1866  
Zone: Colorado Central 502

System Datum: Mean Sea Level

Plan: OH

16:46, July 13 2011  
Created By: Janie Cooke

# **OXY USA RMAT**

**Garfield County, CO NAD27  
Cascade Creek 608-41 Pad  
CC 697-08-08B - Slot I**

**OH**

**Design: OH**

## **Standard Survey Report**

**13 July, 2011**



**Scientific Drilling International, Inc.**  
Survey Report



<b>Company:</b>	OXY USA RMAT	<b>Local Co-ordinate Reference:</b>	Well CC 697-08-08B - Slot I
<b>Project:</b>	Garfield County, CO NAD27	<b>TVD Reference:</b>	GL 8407' & RBK 30' @ 8437.00ft (H&P)
<b>Site:</b>	Cascade Creek 608-41 Pad	<b>MD Reference:</b>	GL 8407' & RBK 30' @ 8437.00ft (H&P)
<b>Well:</b>	CC 697-08-08B	<b>North Reference:</b>	True
<b>Wellbore:</b>	OH	<b>Survey Calculation Method:</b>	Minimum Curvature
<b>Design:</b>	OH	<b>Database:</b>	Rockies Compass Server

<b>Project</b>	Garfield County, CO NAD27		
<b>Map System:</b>	US State Plane 1927 (Exact solution)	<b>System Datum:</b>	Mean Sea Level
<b>Geo Datum:</b>	NAD 1927 (NADCON CONUS)		
<b>Map Zone:</b>	Colorado Central 502		

<b>Site</b>	Cascade Creek 608-41 Pad, SECTION 8 T6S R97W				
<b>Site Position:</b>		<b>Northing:</b>	633,966.95 usft	<b>Latitude:</b>	39° 32' 31.685 N
<b>From:</b>	Map	<b>Easting:</b>	1,228,168.67 usft	<b>Longitude:</b>	108° 14' 13.859 W
<b>Position Uncertainty:</b>	0.00 ft	<b>Slot Radius:</b>	13.200 in	<b>Grid Convergence:</b>	-1.73 °

<b>Well</b>	CC 697-08-08B - Slot I,				
<b>Well Position</b>	<b>+N-S</b>	0.00 ft	<b>Northing:</b>	633,951.10 usft	<b>Latitude:</b> 39° 32' 31.509 N
	<b>+E-W</b>	0.00 ft	<b>Easting:</b>	1,228,101.96 usft	<b>Longitude:</b> 108° 14' 14.704 W
<b>Position Uncertainty</b>		0.00 ft	<b>Wellhead Elevation:</b>	ft	<b>Ground Level:</b> 8,407.00 ft

<b>Wellbore</b>	OH				
<b>Magnetics</b>	<b>Model Name</b>	<b>Sample Date</b>	<b>Declination (°)</b>	<b>Dip Angle (°)</b>	<b>Field Strength (nT)</b>
	IGRF2005-10	10/15/2008	10.79	65.81	52,516

<b>Design</b>	OH				
<b>Audit Notes:</b>					
<b>Version:</b>	1.0	<b>Phase:</b>	ACTUAL	<b>Tie On Depth:</b>	0.00
<b>Vertical Section:</b>	<b>Depth From (TVD) (ft)</b>	<b>+N-S (ft)</b>	<b>+E-W (ft)</b>	<b>Direction (°)</b>	
	0.00	0.00	0.00	54.98	

<b>Survey Program</b>	<b>Date</b>	7/13/2011			
<b>From (ft)</b>	<b>To (ft)</b>	<b>Survey (Wellbore)</b>	<b>Tool Name</b>	<b>Description</b>	
177.00	728.00	Survey #1 - Gyro Survey (OH)	Standard Keeper 103	Standard Wireline Keeper ver 1.0.3	
800.00	2,676.00	Survey #2 - Surface MWD (OH)	MWD-SDI	MWD - Standard ISCWSA	
2,763.00	9,000.00	Survey #3 - Production MWD (OH)	MWD-SDI	MWD - Standard ISCWSA	

Survey									
Measured Depth (ft)	Inclination (°)	Azimuth (°)	Vertical Depth (ft)	+N/-S (ft)	+E/-W (ft)	Vertical Section (ft)	Dogleg Rate (°/100ft)	Build Rate (°/100ft)	Turn Rate (°/100ft)
0.00	0.00	0.00	0.00	0.00	0.00	0.00	0.00	0.00	0.00
177.00	0.97	341.37	176.99	1.42	-0.48	0.42	0.55	0.55	0.00
First SDI Gyro Survey									
269.00	0.97	334.60	268.98	2.86	-1.06	0.77	0.12	0.00	-7.36
361.00	1.94	14.50	360.95	5.07	-1.01	2.09	1.47	1.05	43.37
452.00	3.43	39.90	451.85	8.65	1.13	5.89	2.06	1.64	27.91
544.00	5.89	51.59	543.54	13.70	6.59	13.26	2.85	2.67	12.71
636.00	8.53	55.99	634.81	20.45	15.95	24.80	2.93	2.87	4.78
728.00	10.56	56.25	725.53	28.95	28.61	40.05	2.21	2.21	0.28



<b>Company:</b>	OXY USA RMAT	<b>Local Co-ordinate Reference:</b>	Well CC 697-08-08B - Slot I
<b>Project:</b>	Garfield County, CO NAD27	<b>TVD Reference:</b>	GL 8407' & RBK 30' @ 8437.00ft (H&P)
<b>Site:</b>	Cascade Creek 608-41 Pad	<b>MD Reference:</b>	GL 8407' & RBK 30' @ 8437.00ft (H&P)
<b>Well:</b>	CC 697-08-08B	<b>North Reference:</b>	True
<b>Wellbore:</b>	OH	<b>Survey Calculation Method:</b>	Minimum Curvature
<b>Design:</b>	OH	<b>Database:</b>	Rockies Compass Server

## Survey

Measured Depth (ft)	Inclination (°)	Azimuth (°)	Vertical Depth (ft)	+N/-S (ft)	+E/-W (ft)	Vertical Section (ft)	Dogleg Rate (°/100ft)	Build Rate (°/100ft)	Turn Rate (°/100ft)
<b>Last SDI Gyro Survey</b>									
800.00	11.96	53.72	796.14	37.03	40.12	54.10	2.06	1.94	-3.51
<b>First SDI Surface MWD Survey</b>									
892.00	13.19	52.31	885.93	49.09	56.11	74.12	1.38	1.34	-1.53
984.00	14.51	49.59	975.26	62.98	73.19	96.08	1.60	1.43	-2.96
1,079.00	13.28	54.77	1,067.48	76.99	91.16	118.84	1.84	-1.29	5.45
1,173.00	13.10	62.16	1,159.00	88.19	109.40	140.21	1.80	-0.19	7.86
1,268.00	13.28	61.36	1,251.50	98.45	128.50	161.73	0.27	0.19	-0.84
1,362.00	12.84	59.96	1,343.07	108.85	147.02	182.87	0.58	-0.47	-1.49
1,457.00	12.40	56.00	1,435.77	119.84	164.61	203.58	1.02	-0.46	-4.17
1,552.00	11.96	59.26	1,528.64	130.58	181.53	223.60	0.86	-0.46	3.43
1,646.00	11.17	61.54	1,620.73	139.89	197.91	242.35	0.97	-0.84	2.43
1,741.00	10.76	60.30	1,713.99	148.67	213.70	260.33	0.50	-0.43	-1.31
1,835.00	11.52	60.66	1,806.22	157.62	229.50	278.40	0.81	0.81	0.38
1,930.00	11.78	62.24	1,899.26	166.78	246.35	297.46	0.43	0.27	1.66
2,024.00	12.66	58.82	1,991.13	176.59	263.66	317.26	1.21	0.94	-3.64
2,119.00	12.13	55.65	2,083.92	187.61	280.81	337.63	0.91	-0.56	-3.34
2,214.00	12.57	55.12	2,176.72	199.15	297.53	357.94	0.48	0.46	-0.56
2,308.00	12.49	54.51	2,268.48	210.90	314.19	378.34	0.16	-0.09	-0.65
2,403.00	12.49	57.94	2,361.24	222.32	331.26	398.87	0.78	0.00	3.61
2,497.00	13.98	61.80	2,452.74	233.08	349.89	420.30	1.84	1.59	4.11
2,592.00	12.57	63.30	2,545.20	243.15	369.24	441.92	1.53	-1.48	1.58
2,676.00	11.70	63.47	2,627.32	251.06	385.02	459.39	1.04	-1.04	0.20
<b>Last SDI Surface MWD Survey</b>									
2,763.00	11.32	65.21	2,712.57	258.58	400.67	476.52	0.59	-0.44	2.00
<b>First SDI Production MWD Survey</b>									
2,858.00	12.73	65.28	2,805.48	266.87	418.64	495.99	1.48	1.48	0.07
2,952.00	13.01	58.55	2,897.13	276.72	437.08	516.74	1.62	0.30	-7.16
3,047.00	11.61	53.10	2,989.94	288.04	453.84	536.97	1.91	-1.47	-5.74
3,142.00	12.22	56.00	3,082.90	299.40	469.82	556.58	0.90	0.64	3.05
3,236.00	14.77	56.88	3,174.30	311.51	488.11	578.50	2.72	2.71	0.94
3,331.00	15.30	55.56	3,266.04	325.22	508.59	603.14	0.66	0.56	-1.39
3,425.00	14.51	54.86	3,356.88	339.01	528.45	627.32	0.86	-0.84	-0.74
3,520.00	14.07	53.37	3,448.94	352.75	547.45	650.76	0.60	-0.46	-1.57
3,614.00	13.19	53.45	3,540.29	365.95	565.23	672.90	0.94	-0.94	0.09
3,709.00	12.31	52.84	3,632.95	378.53	582.01	693.86	0.94	-0.93	-0.64
3,803.00	11.96	54.25	3,724.85	390.27	597.90	713.61	0.49	-0.37	1.50
3,898.00	11.17	51.61	3,817.92	401.74	613.10	732.64	1.00	-0.83	-2.78
3,992.00	12.49	59.08	3,909.93	412.61	628.96	751.87	2.15	1.40	7.95
4,087.00	12.40	60.22	4,002.70	422.96	646.63	772.27	0.28	-0.09	1.20
4,181.00	12.31	59.78	4,094.52	433.01	664.04	792.31	0.14	-0.10	-0.47
4,276.00	12.05	59.08	4,187.38	443.21	681.30	812.29	0.31	-0.27	-0.74
4,370.00	11.43	58.02	4,279.41	453.18	697.62	831.38	0.70	-0.66	-1.13
4,465.00	10.73	58.73	4,372.64	462.76	713.16	849.61	0.75	-0.74	0.75





<b>Company:</b>	OXY USA RMAT	<b>Local Co-ordinate Reference:</b>	Well CC 697-08-08B - Slot I
<b>Project:</b>	Garfield County, CO NAD27	<b>TVD Reference:</b>	GL 8407' & RBK 30' @ 8437.00ft (H&P)
<b>Site:</b>	Cascade Creek 608-41 Pad	<b>MD Reference:</b>	GL 8407' & RBK 30' @ 8437.00ft (H&P)
<b>Well:</b>	CC 697-08-08B	<b>North Reference:</b>	True
<b>Wellbore:</b>	OH	<b>Survey Calculation Method:</b>	Minimum Curvature
<b>Design:</b>	OH	<b>Database:</b>	Rockies Compass Server

Survey									
Measured Depth (ft)	Inclination (°)	Azimuth (°)	Vertical Depth (ft)	+N/-S (ft)	+E/-W (ft)	Vertical Section (ft)	Dogleg Rate (°/100ft)	Build Rate (°/100ft)	Turn Rate (°/100ft)
4,559.00	10.99	60.13	4,464.96	471.76	728.41	867.26	0.39	0.28	1.49
4,654.00	12.40	58.90	4,557.98	481.54	745.00	886.46	1.51	1.48	-1.29
4,749.00	11.26	57.15	4,650.96	491.84	761.53	905.90	1.26	-1.20	-1.84
4,843.00	11.70	60.22	4,743.08	501.55	777.51	924.56	0.80	0.47	3.27
4,937.00	10.11	58.99	4,835.38	510.54	792.85	942.29	1.71	-1.69	-1.31
5,032.00	10.20	61.54	4,928.90	518.84	807.39	958.96	0.48	0.09	2.68
5,127.00	10.02	60.49	5,022.42	526.92	821.98	975.54	0.27	-0.19	-1.11
5,221.00	9.67	60.66	5,115.04	534.82	835.98	991.54	0.37	-0.37	0.18
5,315.00	9.23	58.82	5,207.76	542.59	849.31	1,006.92	0.57	-0.47	-1.96
5,410.00	8.18	55.65	5,301.67	550.35	861.41	1,021.28	1.21	-1.11	-3.34
5,504.00	7.21	41.59	5,394.83	558.53	870.85	1,033.70	2.25	-1.03	-14.96
5,599.00	7.03	45.72	5,489.10	567.05	878.97	1,045.24	0.57	-0.19	4.35
5,694.00	4.92	51.78	5,583.57	573.63	886.33	1,055.05	2.32	-2.22	6.38
5,788.00	4.04	27.61	5,677.30	579.06	891.03	1,062.01	2.19	-0.94	-25.71
5,883.00	3.61	23.75	5,772.08	584.76	893.79	1,067.54	0.53	-0.45	-4.06
5,977.00	3.17	27.09	5,865.92	589.79	896.16	1,072.37	0.51	-0.47	3.55
6,072.00	2.37	36.23	5,960.81	593.71	898.52	1,076.55	0.96	-0.84	9.62
6,166.00	1.41	7.49	6,054.76	596.42	899.82	1,079.17	1.41	-1.02	-30.57
6,261.00	1.06	352.19	6,149.74	598.45	899.85	1,080.37	0.50	-0.37	-16.11
6,355.00	0.97	322.58	6,243.72	599.95	899.25	1,080.73	0.56	-0.10	-31.50
6,450.00	1.06	331.19	6,338.71	601.36	898.34	1,080.79	0.19	0.09	9.06
6,544.00	1.23	314.84	6,432.69	602.83	897.21	1,080.71	0.39	0.18	-17.39
6,639.00	1.76	300.16	6,527.66	604.28	895.22	1,079.92	0.68	0.56	-15.45
6,733.00	0.79	285.49	6,621.63	605.18	893.35	1,078.90	1.08	-1.03	-15.61
6,828.00	0.18	211.66	6,716.63	605.23	892.64	1,078.35	0.80	-0.64	-77.72
6,922.00	0.62	172.19	6,810.63	604.60	892.63	1,077.98	0.53	0.47	-41.99
7,017.00	0.79	211.57	6,905.62	603.53	892.36	1,077.14	0.53	0.18	41.45
7,111.00	0.97	219.92	6,999.61	602.37	891.51	1,075.78	0.23	0.19	8.88
7,206.00	0.18	229.50	7,094.60	601.65	890.88	1,074.85	0.83	-0.83	10.08
7,301.00	0.18	254.28	7,189.60	601.52	890.62	1,074.56	0.08	0.00	26.08
7,395.00	0.26	242.51	7,283.60	601.38	890.29	1,074.21	0.10	0.09	-12.52
7,489.00	0.70	79.91	7,377.60	601.38	890.67	1,074.52	1.01	0.47	-172.98
7,584.00	1.06	81.58	7,472.59	601.61	892.11	1,075.83	0.38	0.38	1.76
7,678.00	0.26	52.40	7,566.58	601.87	893.14	1,076.82	0.90	-0.85	-31.04
7,773.00	0.62	257.45	7,661.58	601.89	892.81	1,076.56	0.91	0.38	-163.11
7,867.00	1.41	249.27	7,755.56	601.37	891.23	1,074.97	0.85	0.84	-8.70
7,962.00	2.46	250.15	7,850.51	600.26	888.22	1,071.87	1.11	1.11	0.93
8,057.00	3.43	245.32	7,945.38	598.38	883.72	1,067.11	1.05	1.02	-5.08
8,151.00	3.87	247.43	8,039.19	595.99	878.23	1,061.25	0.49	0.47	2.24
8,245.00	4.22	247.25	8,132.96	593.44	872.11	1,054.77	0.37	0.37	-0.19
8,340.00	4.22	249.63	8,227.70	590.87	865.61	1,047.97	0.18	0.00	2.51
8,434.00	4.22	250.86	8,321.44	588.53	859.10	1,041.30	0.10	0.00	1.31
8,528.00	4.40	244.62	8,415.18	585.85	852.58	1,034.42	0.53	0.19	-6.64



<b>Company:</b>	OXY USA RMAT	<b>Local Co-ordinate Reference:</b>	Well CC 697-08-08B - Slot I
<b>Project:</b>	Garfield County, CO NAD27	<b>TVD Reference:</b>	GL 8407' & RBK 30' @ 8437.00ft (H&P)
<b>Site:</b>	Cascade Creek 608-41 Pad	<b>MD Reference:</b>	GL 8407' & RBK 30' @ 8437.00ft (H&P)
<b>Well:</b>	CC 697-08-08B	<b>North Reference:</b>	True
<b>Wellbore:</b>	OH	<b>Survey Calculation Method:</b>	Minimum Curvature
<b>Design:</b>	OH	<b>Database:</b>	Rockies Compass Server

Survey										
Measured Depth (ft)	Inclination (°)	Azimuth (°)	Vertical Depth (ft)	+N/-S (ft)	+E/-W (ft)	Vertical Section (ft)	Dogleg Rate (°/100ft)	Build Rate (°/100ft)	Turn Rate (°/100ft)	
8,623.00	4.84	243.21	8,509.87	582.48	845.71	1,026.86	0.48	0.46	-1.48	
8,717.00	4.92	246.90	8,603.53	579.11	838.46	1,018.99	0.34	0.09	3.93	
8,811.00	5.45	248.04	8,697.14	575.86	830.61	1,010.70	0.57	0.56	1.21	
8,906.00	5.63	250.07	8,791.70	572.59	822.05	1,001.80	0.28	0.19	2.14	
8,945.00	6.33	251.56	8,830.49	571.25	818.21	997.90	1.84	1.79	3.82	
<b>Last SDI Production MWD Survey</b>										
9,000.00	6.33	251.56	8,885.15	569.34	812.46	992.08	0.00	0.00	0.00	
<b>Projection to TD - BHL = 634495.70, 1228931.20</b>										

Design Annotations					
Measured Depth (ft)	Vertical Depth (ft)	Local Coordinates			
		+N/-S (ft)	+E/-W (ft)	Comment	
177.00	176.99	1.42	-0.48	First SDI Gyro Survey	
728.00	725.53	28.95	28.61	Last SDI Gyro Survey	
800.00	796.14	37.03	40.12	First SDI Surface MWD Survey	
2,676.00	2,627.32	251.06	385.02	Last SDI Surface MWD Survey	
2,763.00	2,712.57	258.58	400.67	First SDI Production MWD Survey	
8,945.00	8,830.49	571.25	818.21	Last SDI Production MWD Survey	
9,000.00	8,885.15	569.34	812.46	Projection to TD	
9,000.00	8,885.15	569.34	812.46	BHL = 634495.70, 1228931.20	

Checked By: \_\_\_\_\_ Approved By: \_\_\_\_\_ Date: \_\_\_\_\_