


# WELL LOCATION CERTIFICATE

SECTION: 25  
TOWNSHIP: 6N  
RANGE: 63W

THIS MAP DOES NOT REPRESENT A BOUNDARY SURVEY

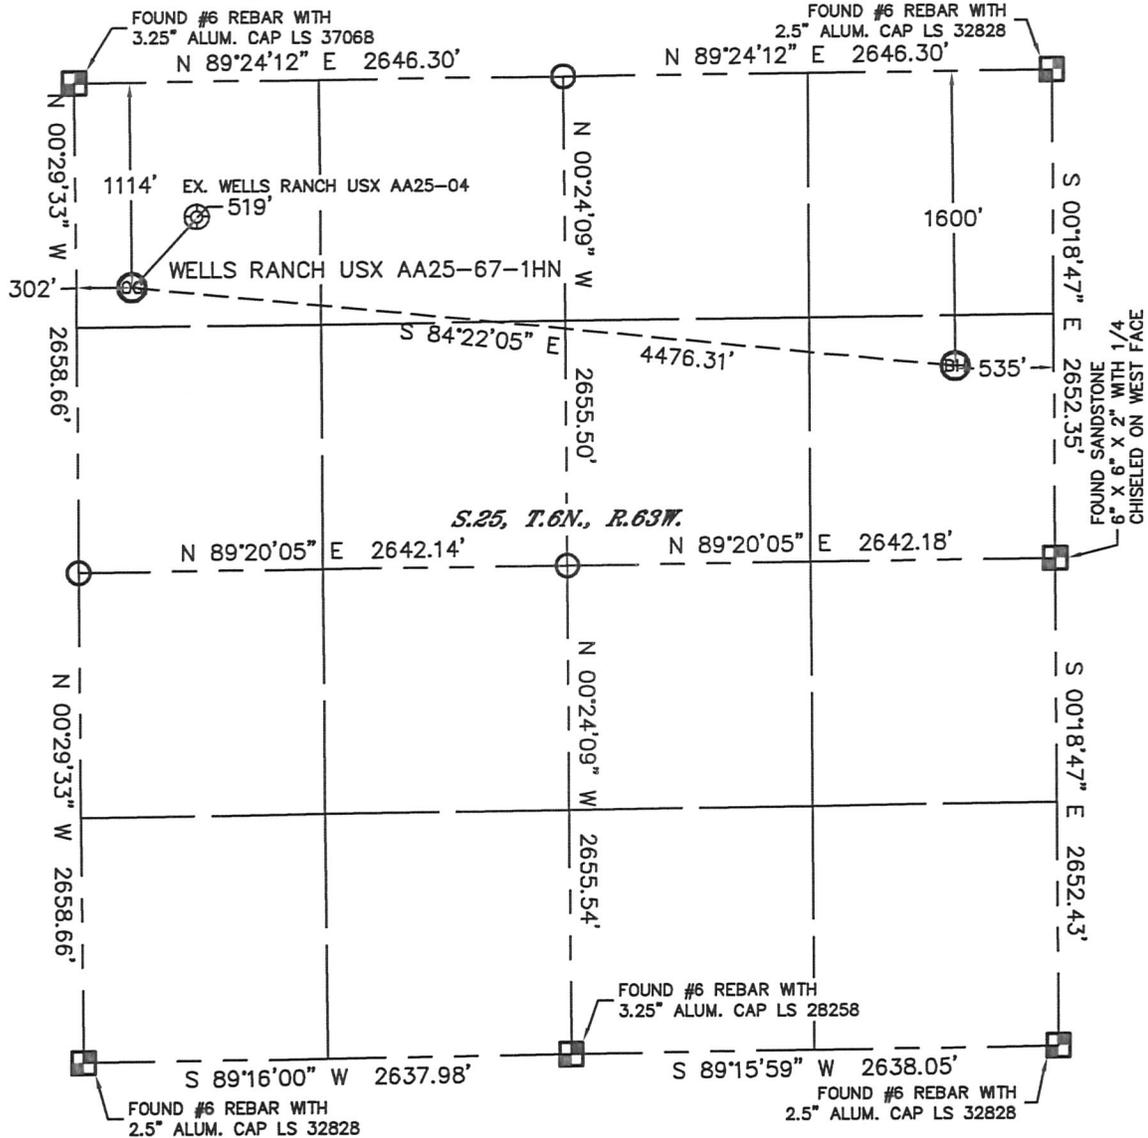


In accordance with a request from Sean Casper with Noble Energy Inc. Lat40°, Inc. has determined the surface location of the WELLS RANCH USX AA25-67-1HN to be 1114' from the NORTH line and 302' from the WEST line and the bottom hole to be 1600' from the NORTH line and 535' from the EAST line as measured at right angles from the section lines of Section 25, Township 6 North, Range 63 West of the Sixth Principal Meridian, County of Weld, State of Colorado.

I hereby state that this Well Location Certificate was prepared by me, or under my direct supervision, that the fieldwork was completed on 7/12/11, for and on behalf of Noble Energy Inc. That this is not a Land Survey Plat or an Improvement Survey Plat, and that it is not to be relied upon for establishment of fence, building, or other future improvement lines.

**NOTE:**

- 1) Bearings shown are Grid Bearings of the Colorado State Plane Coordinate System, North Zone, North American Datum 1983/2007. The lineal dimensions as contained herein are based upon the "U.S. Survey Foot."
- 2) Ground elevations are based on an observed GPS elevation (NAVD 1988 DATUM).
- 3) NEAREST EXISTING WELL: WELLS RANCH USX AA25-04, 519'
- 4) IMPROVEMENTS: See LOCATION DRAWING for all visible improvements within 400' of disturbed area.
- 5) SURFACE USE: RANGELAND
- 6) INSTRUMENT OPERATOR: ADAM KELLY

SURFACE LOCATION	BOTTOM HOLE
LATITUDE: 40.46168°N	LATITUDE: 40.46032°N
LONGITUDE: 104.39353°W	LONGITUDE: 104.37754°W
PDOP: 1.2	
ELEV: 4815'	
1/4, 1/4: NW1/4NW1/4	
NEAREST PROPERTY LINE: 302' WEST	

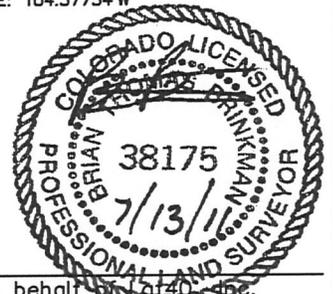

**NOTE**

According to Colorado law, you must commence any legal action based upon any defect in this W.L.C. within three years after you discover such defect. In no event, may any action based upon any defect in this survey be commenced more than ten years after the date of the certificate shown hereon. (13-80-105 C.R.S.)

**LEGEND**


- = ALIQUOT MONUMENT AS DESCRIBED
- = CALCULATED POSITION

Brian T. Brinkman—On behalf of Lat40°, Inc.  
Colorado Licensed Professional  
Land Surveyor No. 38175 PROJECT#: 2011115

# SITE SKETCH

WELLS RANCH USX AA25-67-1HN

SECTION: 25  
TOWNSHIP: 6N  
RANGE: 63W

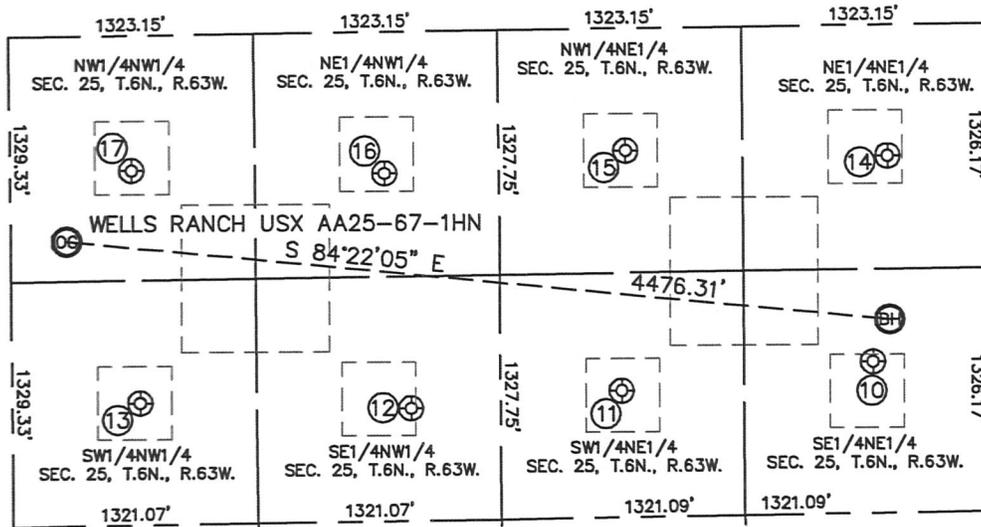

⑩

WELLS RANCH USX  
AA25-08  
SE1/4NE1/4  
1829' FNL  
626' FEL  
LAT-40.45969°N  
LONG-104.37788°W  
PDOP: 3.4  
ELEV: 4745'

⑪

WELLS RANCH USX  
AA25-07  
SW1/4NE1/4  
1967' FNL  
1985' FEL  
LAT-40.45932°N  
LONG-104.38277°W  
PDOP: 3.2  
ELEV: 4749'

⑫

WELLS RANCH USX  
AA25-06  
SE1/4NW1/4  
2046' FNL  
2157' FWL  
LAT-40.45912°N  
LONG-104.38688°W  
PDOP: 1.4  
ELEV: 4763'

⑬

WELLS RANCH USX  
AA25-05  
SW1/4NW1/4  
1997' FNL  
690' FWL  
LAT-40.45926°N  
LONG-104.39215°W  
PDOP: 1.9  
ELEV: 4797'

⑭

WELLS RANCH USX  
AA25-01  
NE1/4NE1/4  
713' FNL  
540' FEL  
LAT-40.46276°N  
LONG-104.37754°W  
PDOP: 1.4  
ELEV: 4752'

⑮

WELLS RANCH USX  
AA25-02  
NW1/4NE1/4  
666' FNL  
1957' FEL  
LAT-40.46290°N  
LONG-104.38263°W  
PDOP: 1.4  
ELEV: 4764'

⑯

WELLS RANCH USX  
AA25-03  
NE1/4NW1/4  
769' FNL  
2024' FWL  
LAT-40.46262°N  
LONG-104.38734°W  
PDOP: 1.8  
ELEV: 4790'

⑰

WELLS RANCH USX  
AA25-04  
NW1/4NW1/4  
735' FNL  
655' FWL  
LAT-40.46272°N  
LONG-104.39225°W  
PDOP: 1.6  
ELEV: 4810'

