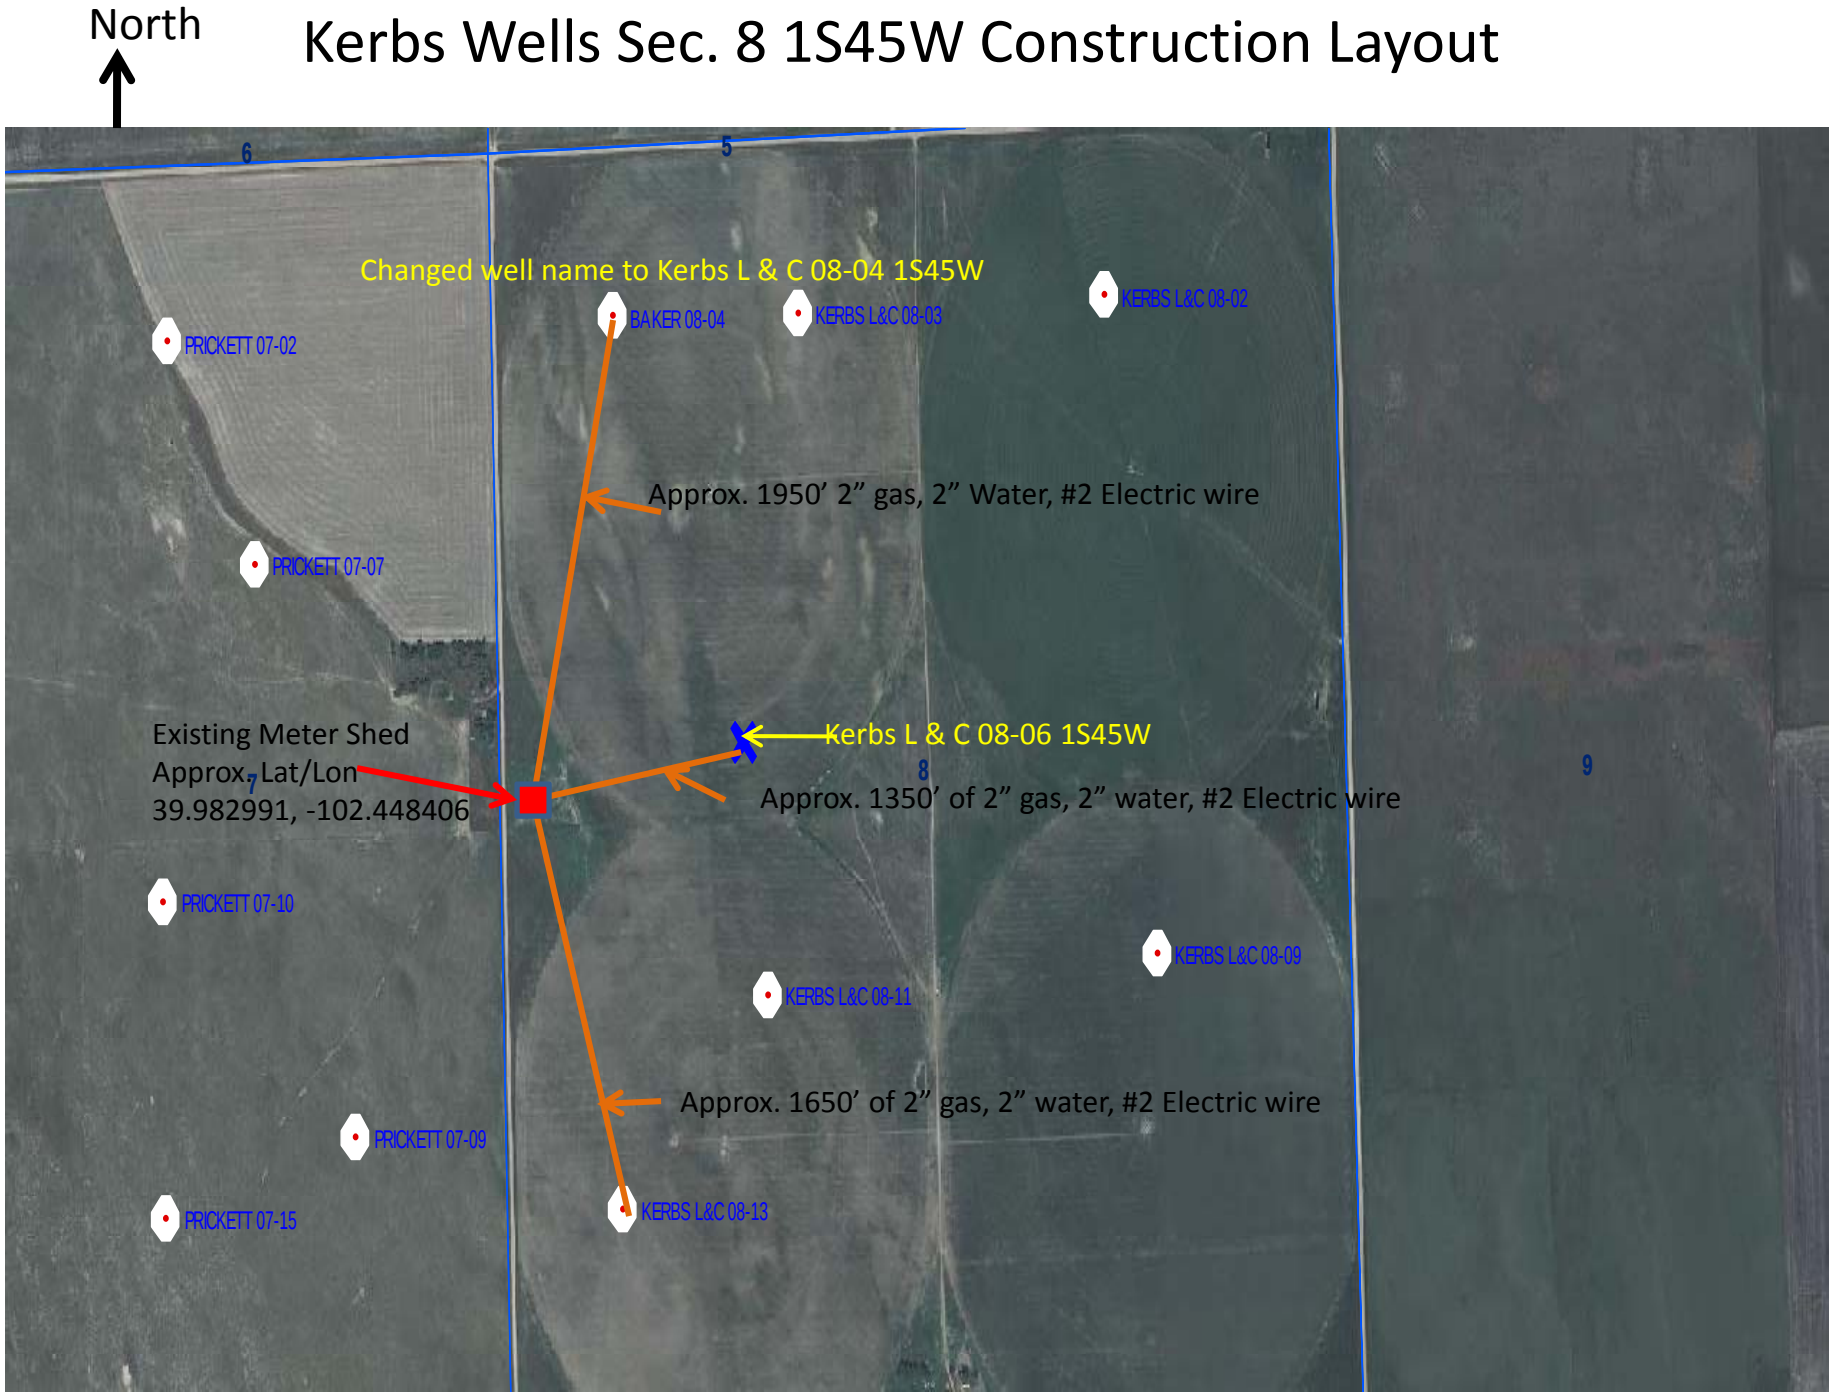Kerbs Wells Sec. 8 1S45W Construction Layout