

# Vader 33-15

NESE, Sec. 10, T7N – R57W  
Larimer County, Colorado  
Elevation: 5082' GR  
API No. 05-069-06404


**Sunburst, Inc.**

1401 E. Girard Ave., Suite 143  
Englewood, CO 80110

## Wellbore Schematic

**JSand**

August 25, 2011

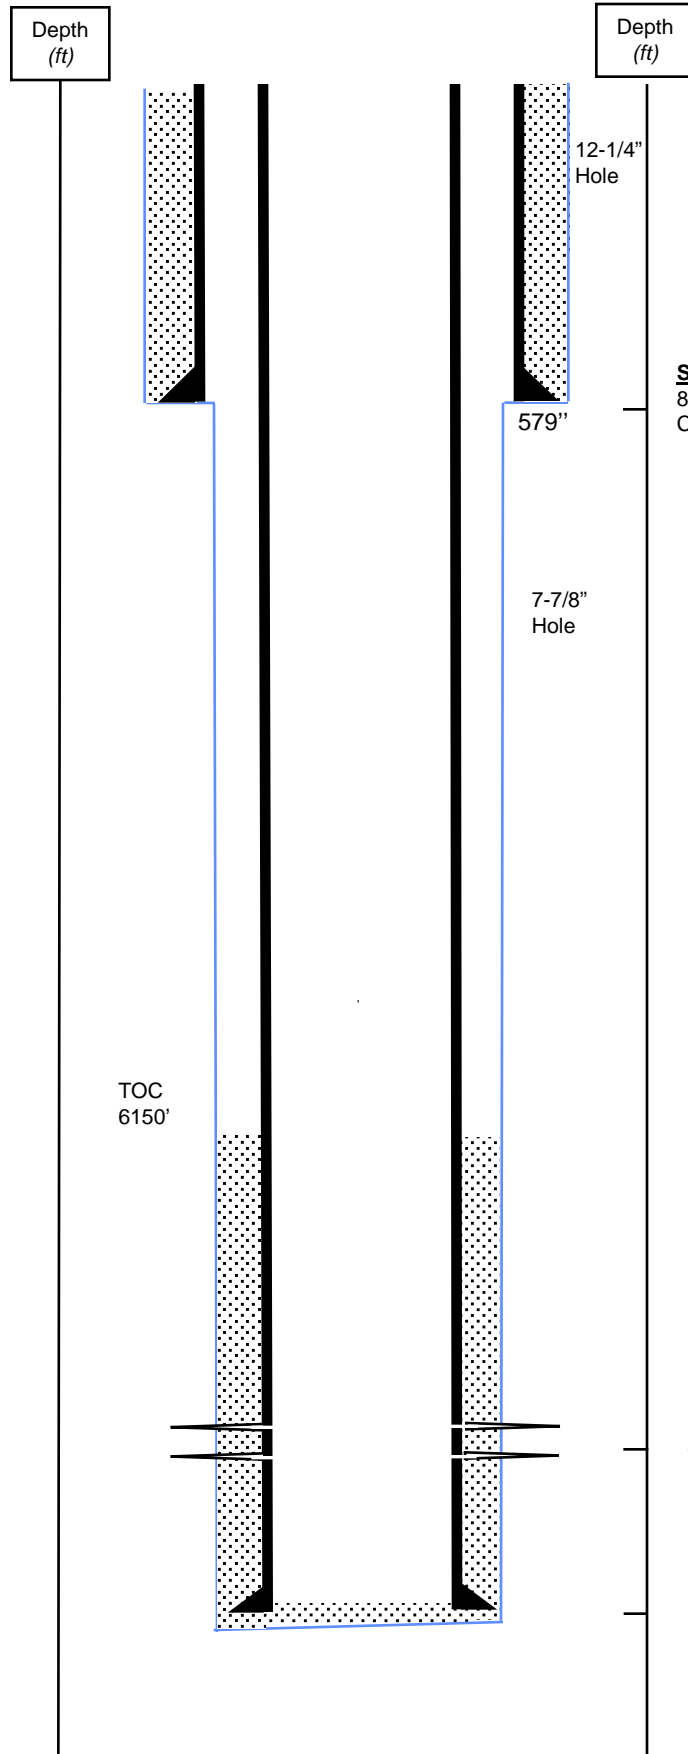

Spud Date: 09/10/2010  
TD Date: 09/19/2010  
Status: Shut In

### Surface Casing:

8-5/8", 24#, set @ 579'  
Cement w/ 410 sx to surface

### JSand Perfs:

7648' – 7668', w/ 2 SPF, 40 holes

### Production Casing:

4-1/2", 11.6#, CSR set @ 7803'  
Cmt w/ 617 sx

PBTD: 7753'  
TD: 7815'