



Appaloosa #33-14 As Built Well Location

NESW Section 33 T7N R65W

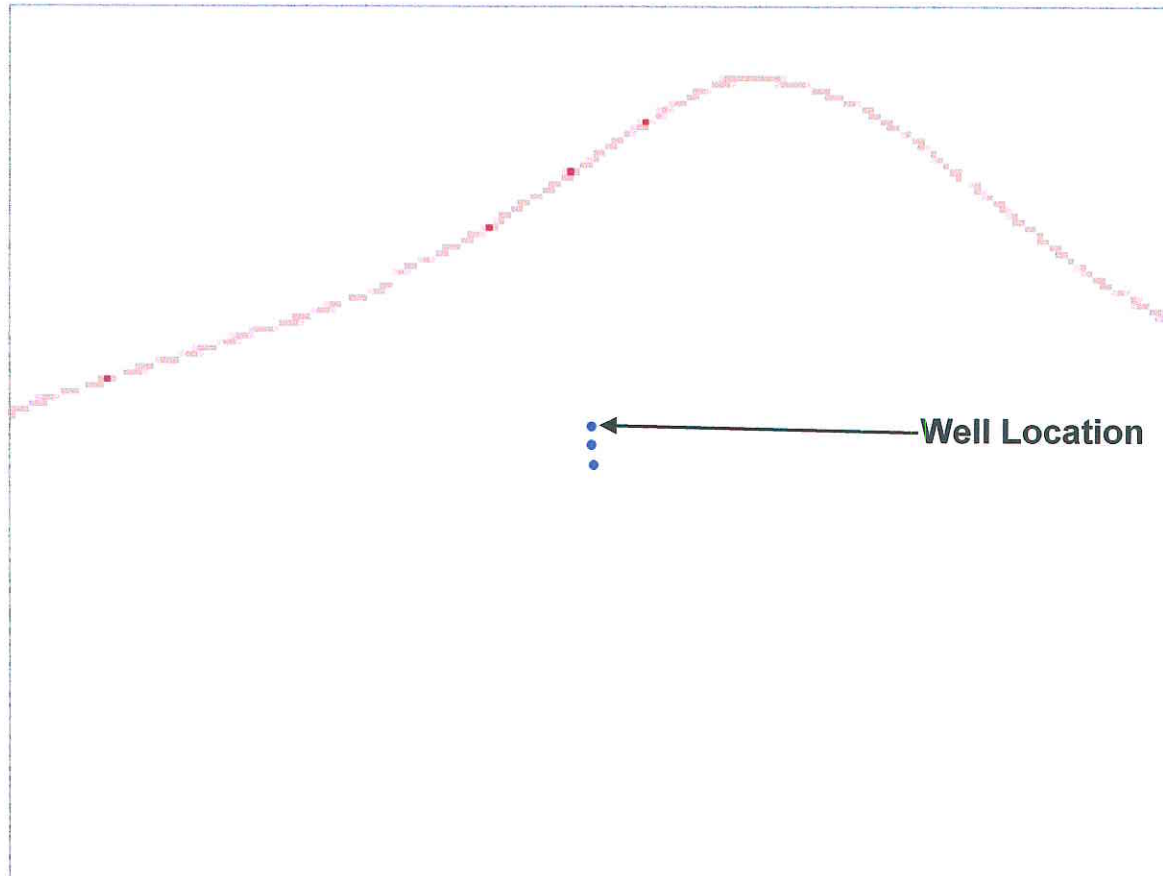

Well Pad View

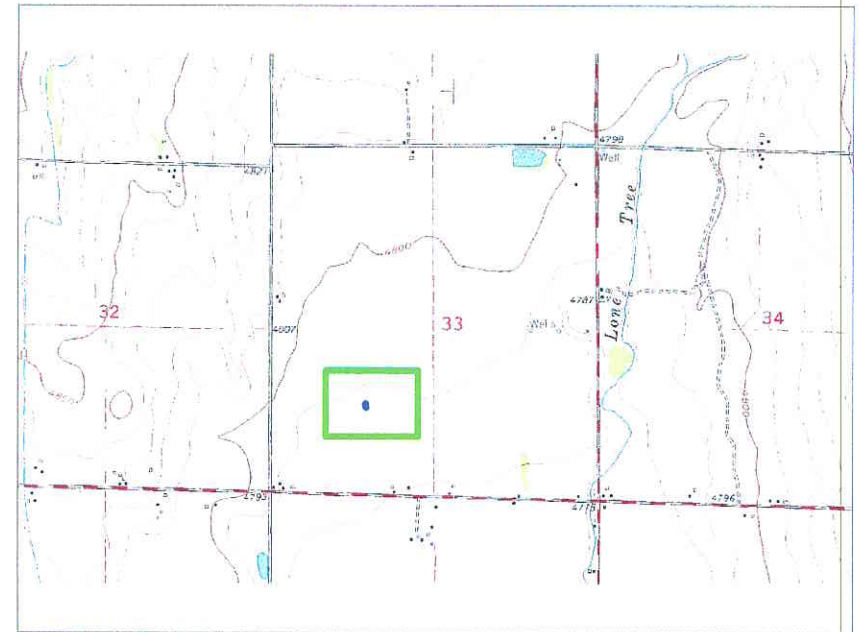

Section View

Latitude: 40.52761

Longitude: -104.67228

PDOP: 2.1

GPS Date: 06-26-2011

GPS Operator: L. Robbins