
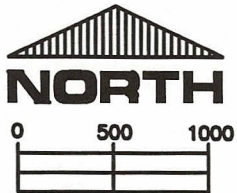


HYDROLOGY / TOPOGRAPHY MAP

SEC. 6 T6N R64W, 6TH P.M.

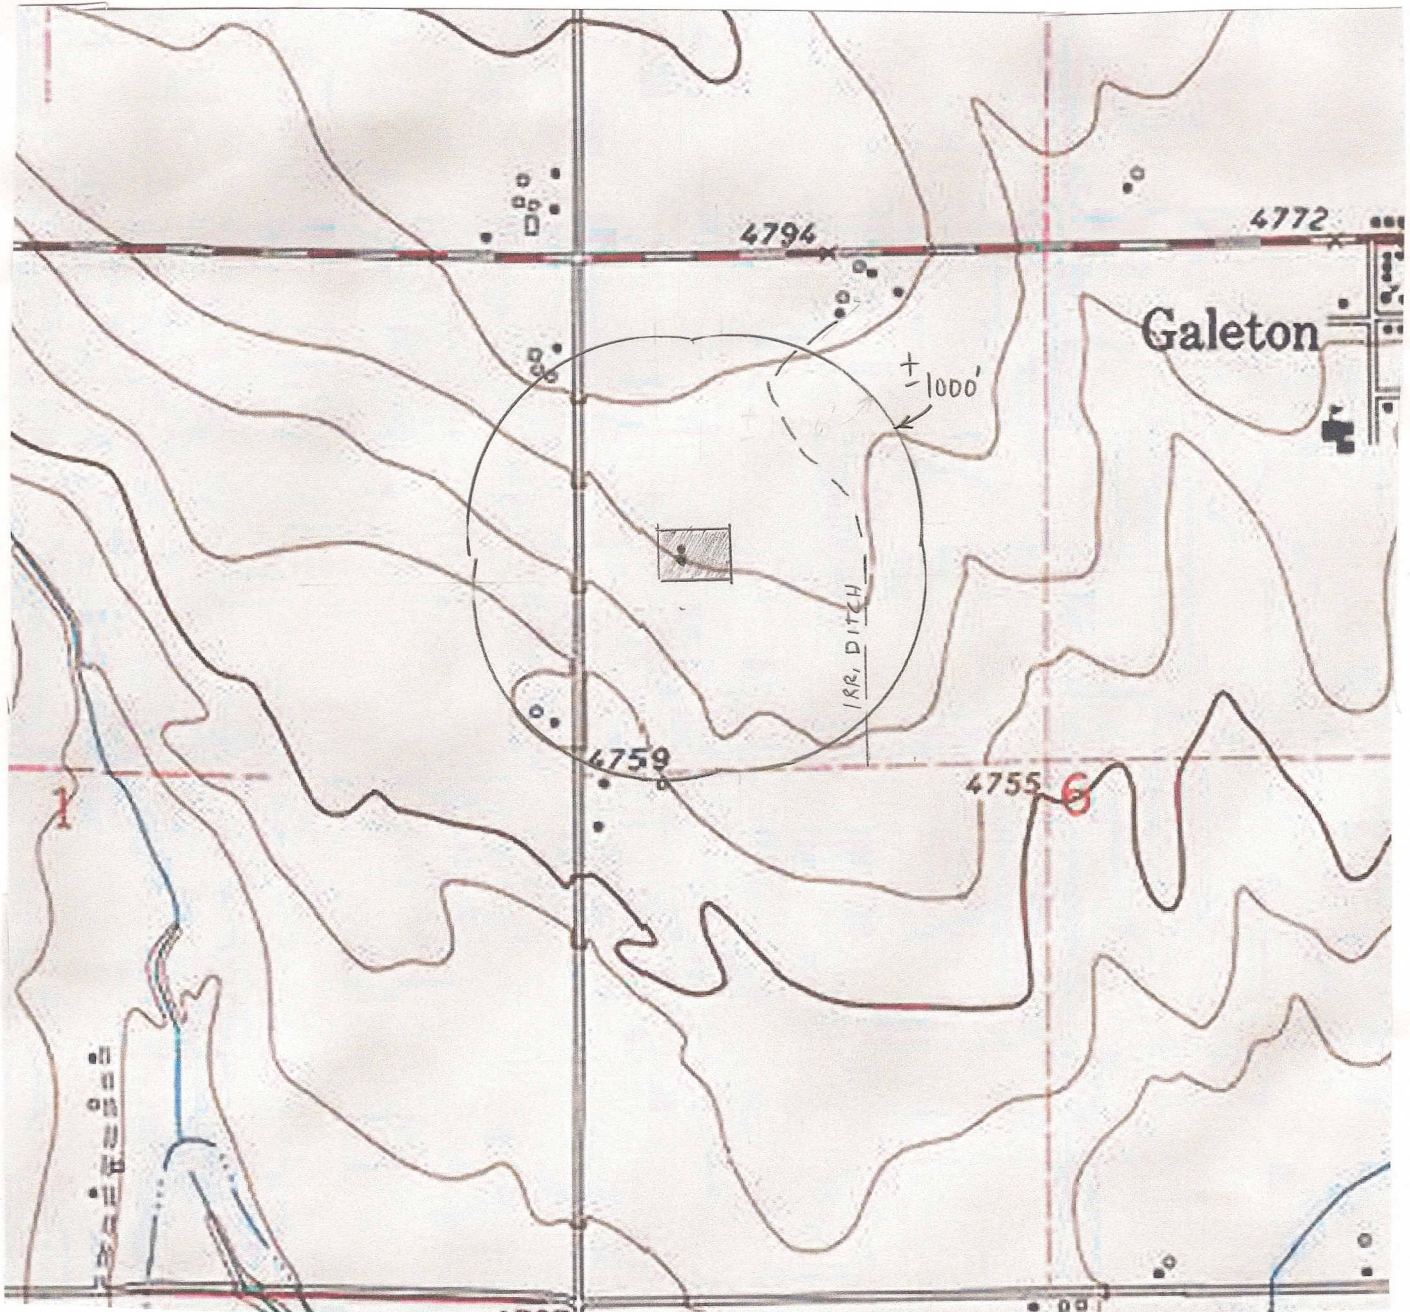

APPROX. SCALE 1" = 1000'

THE PAD IS LOCATED IN A PASTURE.
A N-S IRRIGATION DITCH IS APPROX. 900' NE OF THE 12-6H LOCATION.
NO OTHER VISIBLE WATER FEATURES WITHIN 1000' OF DISTURBANCE.

PREPARED BY:

HORSESHOE SURVEYING, LLC
PO BOX 150458
LAKEWOOD, CO 80215
(720)872-0196

DRAWING DATE:

8-2-11

FIELD DATE:

7-30-11

BY:

TGC

WELL NAME:

STILLE (2-WELL PAD)
12-6H, 11-6D

LOCATION:

WELD COUNTY, CO
NW1/4, SEC. 6, T6N, R64W, 6TH P.M.