Project: Mesa
Site: NWNW Sec 24-T6S-R97W
Well: Puckett 11C-24D
Wellbore: DD
Design: DD

PDC ENERGY

Azimuths to True North
Magnetic North: 10.57°

Magnetic Field
Strength: 52321.3snT
Dip Angle: 65.75°
Date: 06/01/2010
Model: IGRF2010-14

WELL DETAILS: Puckett 11C-24D

Ground Level: 8381.0

+N/-S	+E/-W	Northing	Easting	Latitude	Longitude	Slot
0.0	0.0	1622946.42	2245697.18	39.513290	-108.173975	

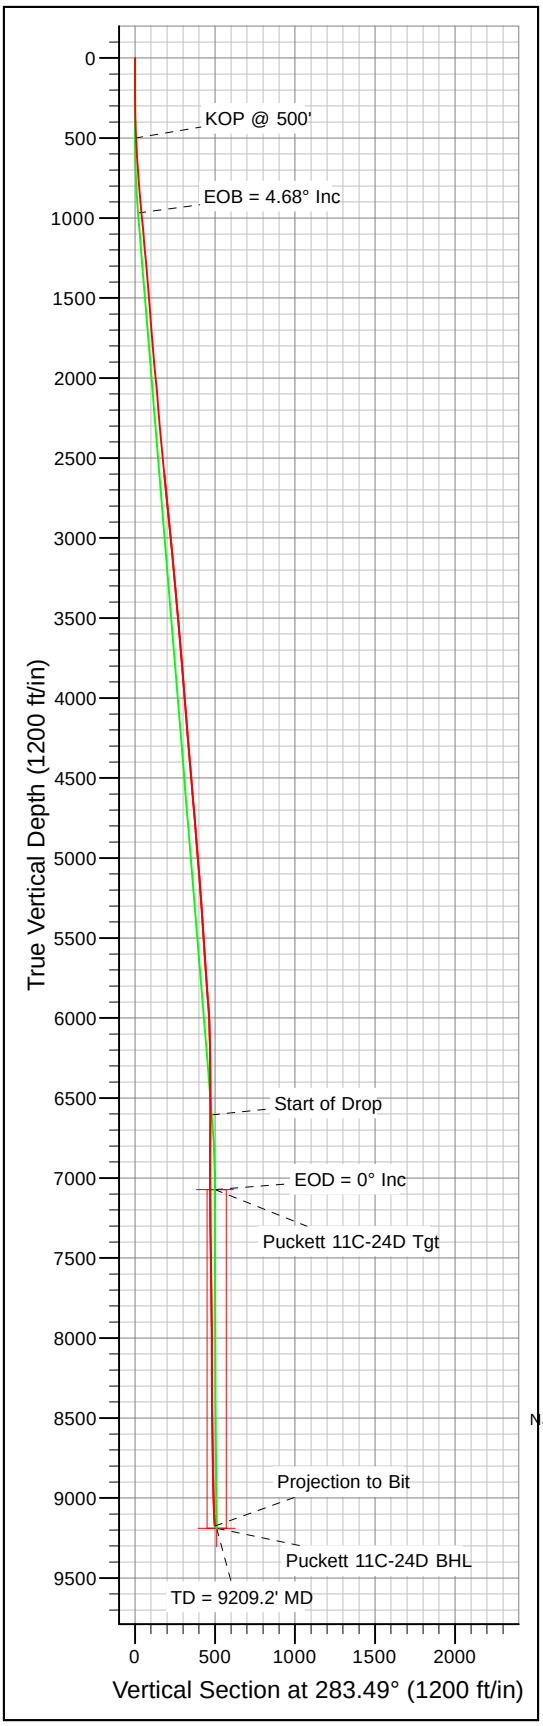

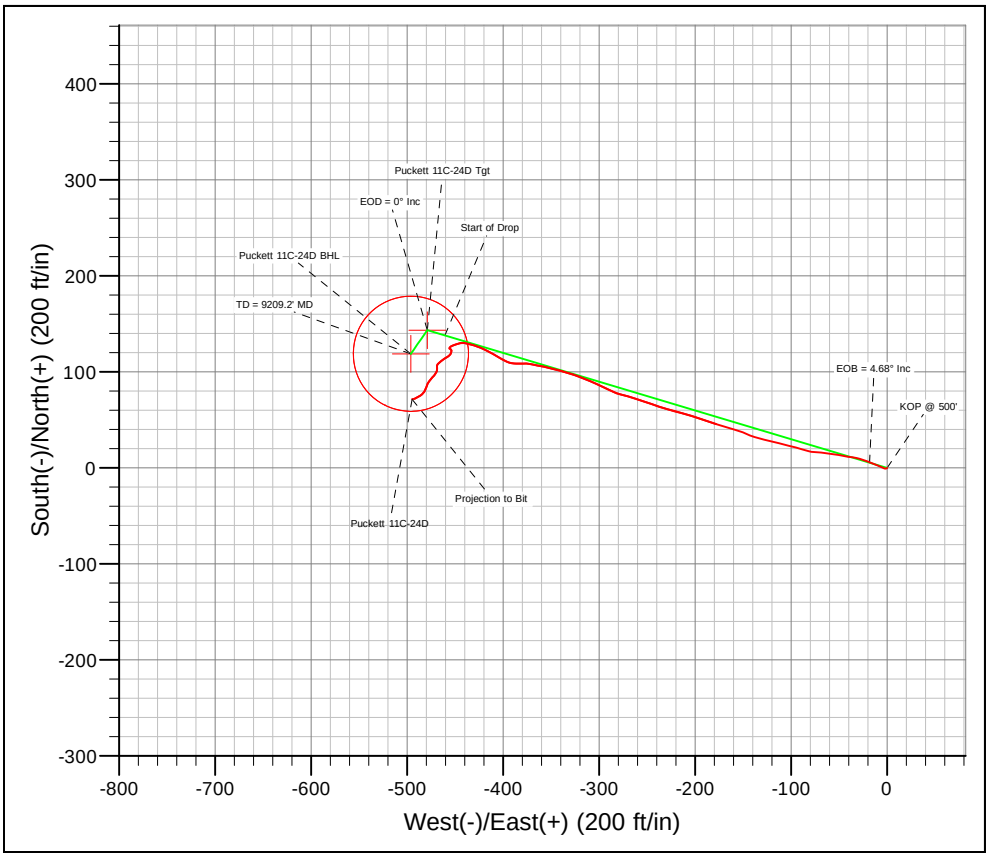

ANNOTATIONS

TVD	MD	Annotation
9174.9	9196.0	Projection to Bit

FORMATION TOP DETAILS

No formation data is available

ON DETAILS

No plan data is available

WELLBORE TARGET DETAILS (LAT/LONG)

Name	TVD	+N/-S	+E/-W	Latitude	Longitude	Shape

No wellbore target data is available.

CASING DETAILS

No casing data is available

PHOENIX TECHNOLOGY SERVICES

Survey: Production (Puckett 11C-24D/DD)

Created By: Jon Schweigert Date: 14:02, April 12 2011
Checked: _____ Date: _____
Reviewed: _____ Date: _____
Approved: _____ Date: _____