


ENCANA.
Encana Oil & Gas (USA) Inc.

EnCana Oil & Gas (USA) Inc.

KB : 6550.0 ft

KB : 6550.0 ft

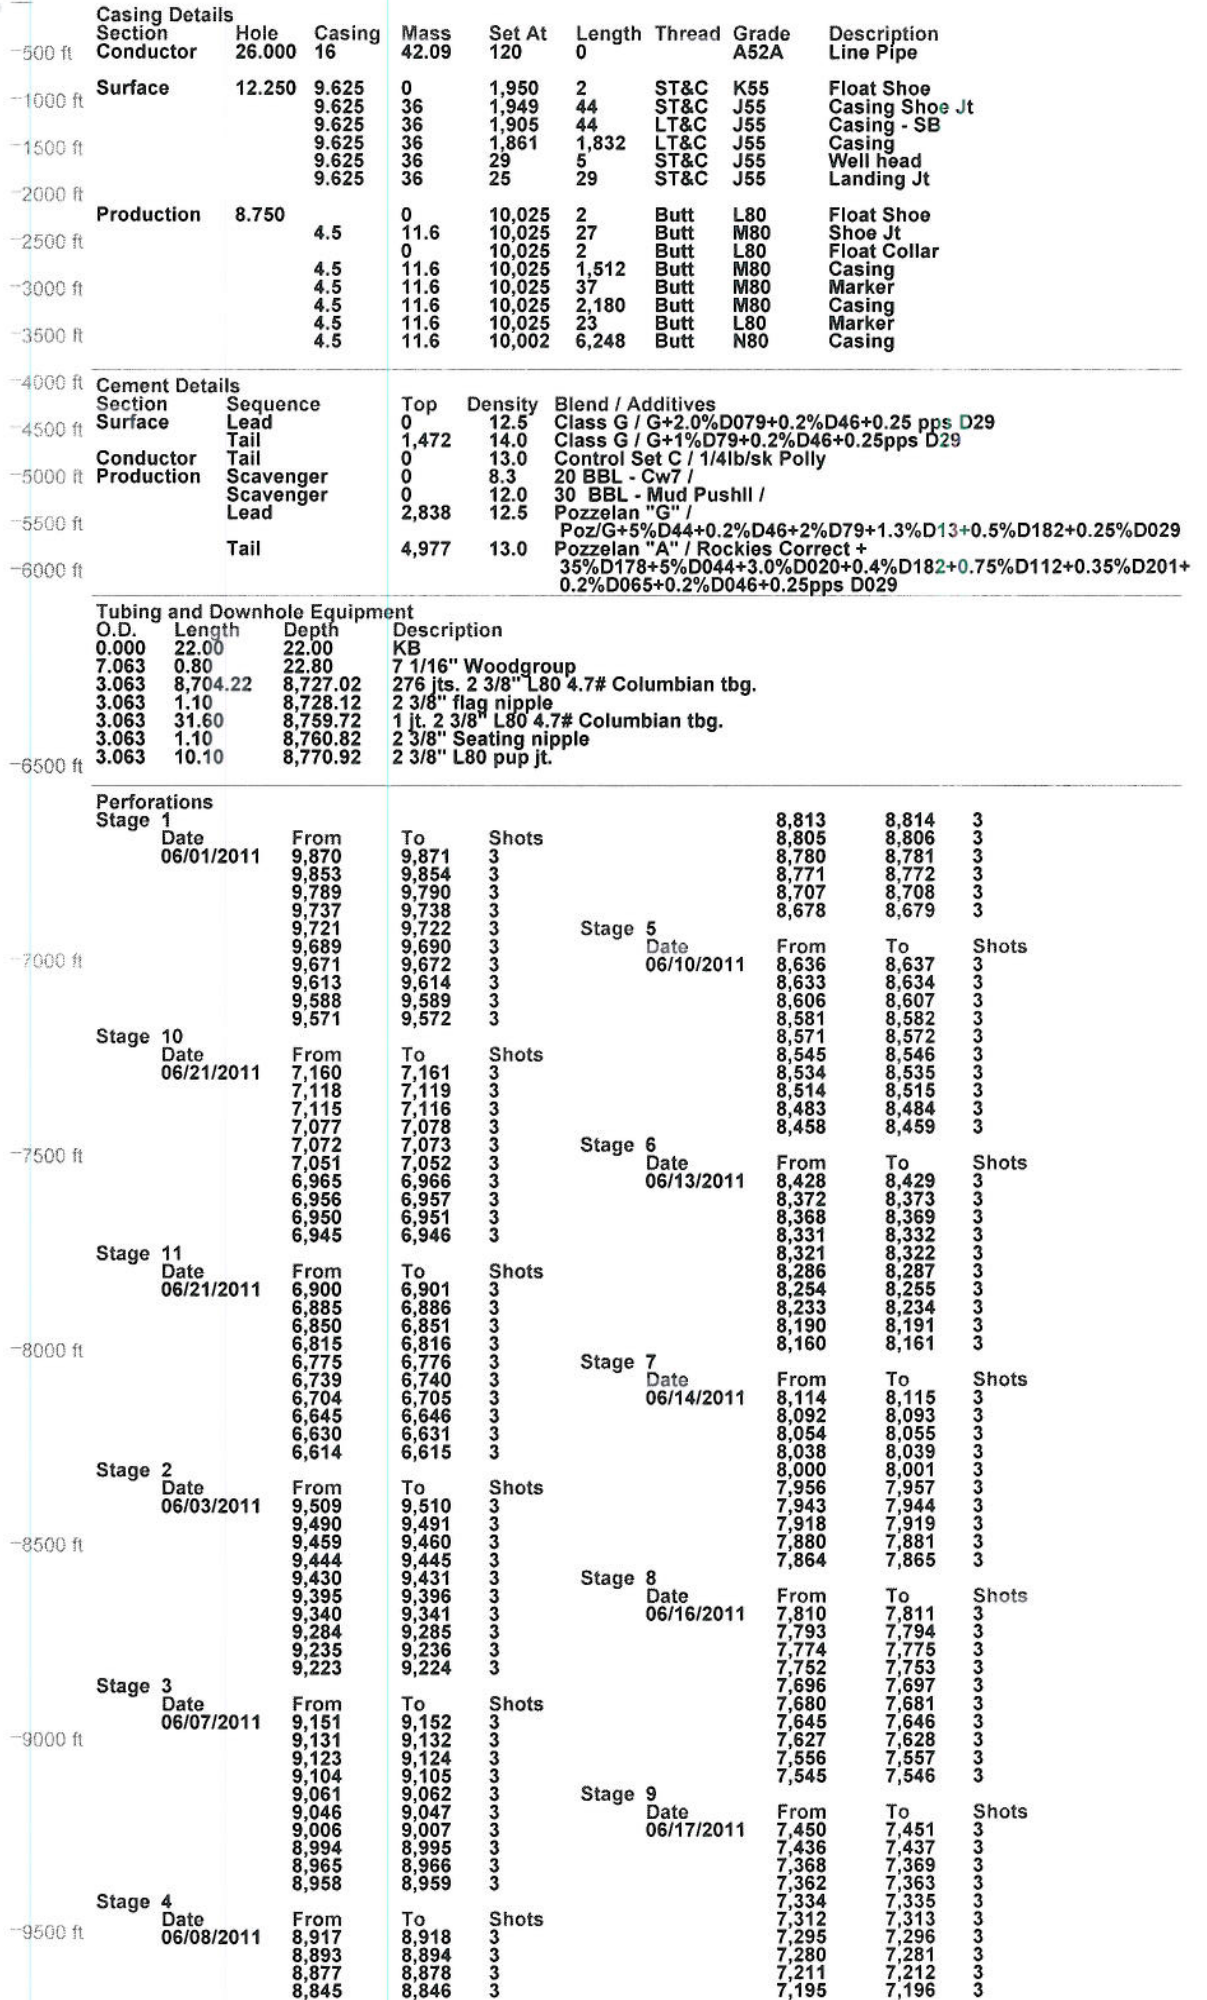

Comments
277 jts. 2 3/8" L80 4.7# Columbian tbq.