


Company: Exxon Mobil
Lease/Well: PCU 296-5A6
Location: Rio Blanco County, CO
Rig Name: N/A
Declination: 12.29°
Grid: Grid North (Grid Conv. -1.74)

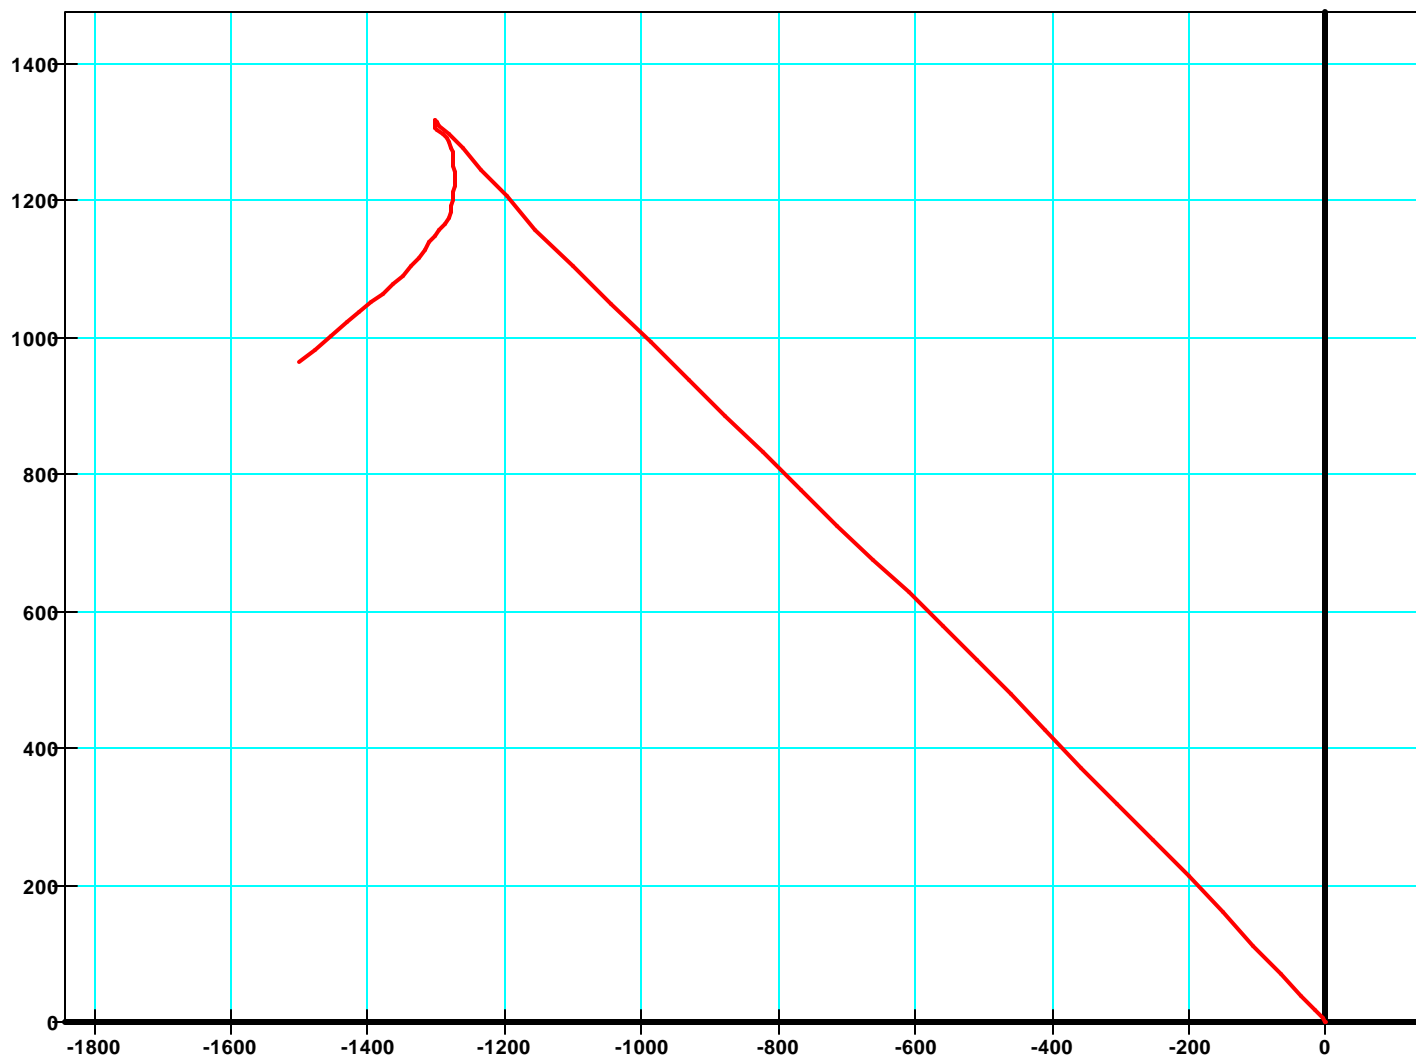

○-- Surface - 13750' M.D. (Rate Gyro)