


NOBLE ENERGY INC WELD COUNTY CO

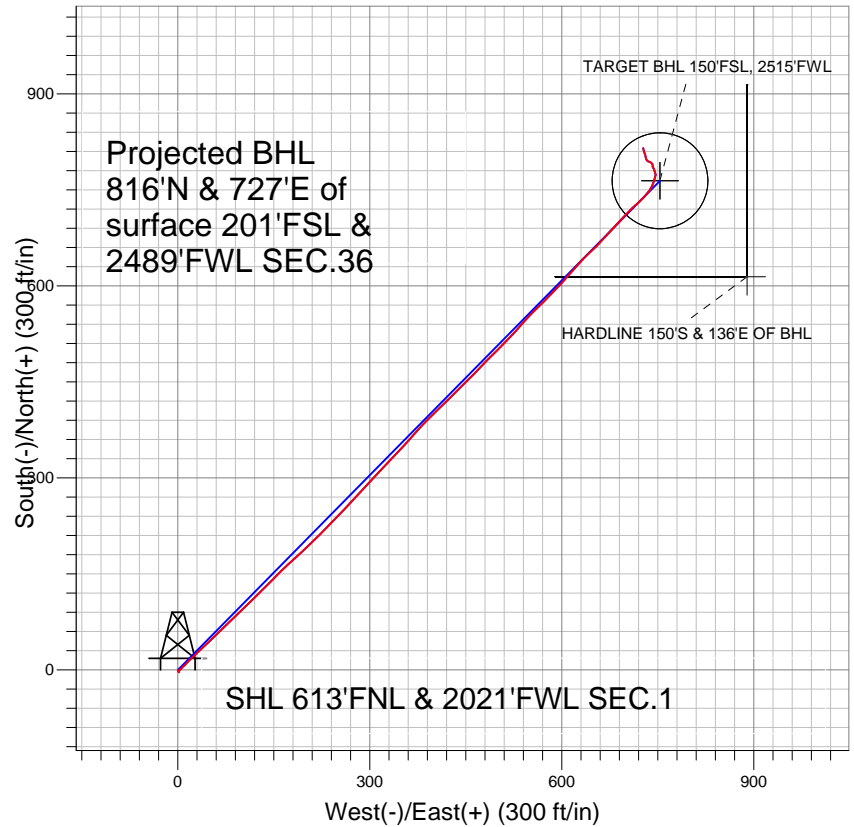


LEGEND

- △ Marley C01-28D, Wellbore #1, Noble Marley C01-28D Plan #2 (02-24-10) V0
- Wellbore #1
- Survey #1

Final Survey Plot

Projected Final Survey -
7038'MD & 6891'TVD @ 1091'VS
2.8 deg Inc 346.4 deg AZ

Project: SEC.1-T4N-R64W
Site: Marley C01-28D Pad Sec.1-T4N-R64W
Well: Marley C01-28D
Plan: Wellbore #1

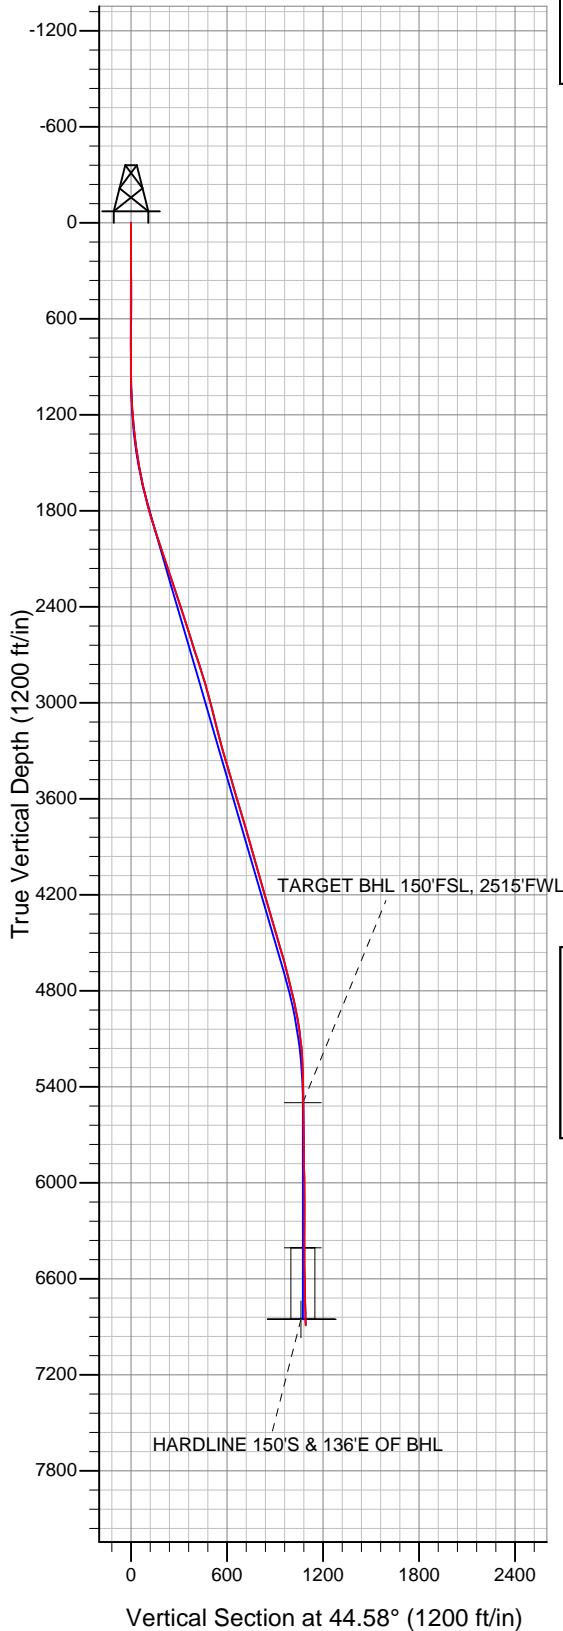



Directional

NOBLE ENERGY INC WELD COUNTY CO

SEC.1-T4N-R64W

Marley C01-28D Pad Sec.1-T4N-R64W

Marley C01-28D

Wellbore #1

Survey: Survey #1

Standard Survey Report

26 April, 2011



Company:	NOBLE ENERGY INC WELD COUNTY CO	Local Co-ordinate Reference:	Well Marley C01-28D
Project:	SEC.1-T4N-R64W	TVD Reference:	WELL @ 4618.0ft (Original Well Elev)
Site:	Marley C01-28D Pad Sec.1-T4N-R64W	MD Reference:	WELL @ 4618.0ft (Original Well Elev)
Well:	Marley C01-28D	North Reference:	True
Wellbore:	Wellbore #1	Survey Calculation Method:	Minimum Curvature
Design:	Wellbore #1	Database:	Landmark

Project	SEC.1-T4N-R64W, Weld County, Colorado		
Map System:	US State Plane 1983	System Datum:	Mean Sea Level
Geo Datum:	North American Datum 1983		Using Well Reference Point
Map Zone:	Colorado Northern Zone		Using geodetic scale factor

Site	Marley C01-28D Pad Sec.1-T4N-R64W				
Site Position:		Northing:	1,370,788.77 ft	Latitude:	40.346910
From:	Lat/Long	Easting:	3,278,471.71 ft	Longitude:	-104.500900
Position Uncertainty:	0.0 ft	Slot Radius:	"	Grid Convergence:	0.65 °

Well	Marley C01-28D					
Well Position	+N/-S	0.0 ft	Northing:	1,370,814.25 ft	Latitude:	40.346980
	+E/-W	0.0 ft	Easting:	3,278,471.43 ft	Longitude:	-104.500900
Position Uncertainty		0.0 ft	Wellhead Elevation:	ft	Ground Level:	4,605.0 ft

Wellbore	Wellbore #1				
Magnetics	Model Name	Sample Date	Declination (°)	Dip Angle (°)	Field Strength (nT)
	IGRF200510	11/13/2009	8.89	67.11	53,320

Design	Wellbore #1				
Audit Notes:					
Version:	1.0	Phase:	ACTUAL	Tie On Depth:	0.0
Vertical Section:	Depth From (TVD) (ft)	+N/-S (ft)	+E/-W (ft)	Direction (°)	
	0.0	0.0	0.0	44.58	

Survey Program	Date	4/26/2011			
From (ft)	To (ft)	Survey (Wellbore)	Tool Name	Description	
663.0	7,038.0	Survey #1 (Wellbore #1)	MWD	MWD - Standard	

Survey										
Measured Depth (ft)	Inclination (°)	Azimuth (°)	Vertical Depth (ft)	+N/-S (ft)	+E/-W (ft)	Vertical Section (ft)	Dogleg Rate (°/100ft)	Build Rate (°/100ft)	Turn Rate (°/100ft)	
0.0	0.00	0.00	0.0	0.0	0.0	0.0	0.00	0.00	0.00	
663.0	0.60	154.70	663.0	-3.1	1.5	-1.2	0.09	0.09	0.00	
757.0	0.10	74.60	757.0	-3.6	1.8	-1.3	0.63	-0.53	-85.21	
851.0	0.60	37.60	851.0	-3.1	2.2	-0.7	0.56	0.53	-39.36	
945.0	0.80	333.50	945.0	-2.2	2.2	0.0	0.81	0.21	-68.19	
1,039.0	1.50	39.60	1,039.0	-0.6	2.7	1.4	1.47	0.74	70.32	
1,133.0	3.10	44.00	1,132.9	2.1	5.2	5.2	1.71	1.70	4.68	
1,227.0	5.30	45.50	1,226.6	7.0	10.1	12.1	2.34	2.34	1.60	
1,321.0	6.40	43.20	1,320.1	13.9	16.7	21.6	1.20	1.17	-2.45	
1,415.0	7.90	47.30	1,413.4	22.1	25.1	33.3	1.68	1.60	4.36	
1,509.0	9.30	47.10	1,506.3	31.6	35.4	47.4	1.49	1.49	-0.21	
1,603.0	11.30	46.20	1,598.8	43.2	47.6	64.2	2.13	2.13	-0.96	
1,697.0	13.80	45.20	1,690.6	57.4	62.2	84.6	2.67	2.66	-1.06	

Company:	NOBLE ENERGY INC WELD COUNTY CO	Local Co-ordinate Reference:	Well Marley C01-28D
Project:	SEC.1-T4N-R64W	TVD Reference:	WELL @ 4618.0ft (Original Well Elev)
Site:	Marley C01-28D Pad Sec.1-T4N-R64W	MD Reference:	WELL @ 4618.0ft (Original Well Elev)
Well:	Marley C01-28D	North Reference:	True
Wellbore:	Wellbore #1	Survey Calculation Method:	Minimum Curvature
Design:	Wellbore #1	Database:	Landmark

Survey										
Measured Depth (ft)	Inclination (°)	Azimuth (°)	Vertical Depth (ft)	+N/-S (ft)	+E/-W (ft)	Vertical Section (ft)	Dogleg Rate (°/100ft)	Build Rate (°/100ft)	Turn Rate (°/100ft)	
1,791.0	15.70	47.10	1,781.5	74.0	79.5	108.5	2.09	2.02	2.02	
1,885.0	16.80	45.70	1,871.7	92.2	98.5	134.8	1.24	1.17	-1.49	
1,979.0	18.70	45.60	1,961.2	112.2	119.0	163.4	2.02	2.02	-0.11	
2,072.0	18.60	45.20	2,049.3	133.1	140.2	193.2	0.17	-0.11	-0.43	
2,166.0	17.70	44.50	2,138.7	153.8	160.8	222.5	0.99	-0.96	-0.74	
2,260.0	18.60	48.90	2,228.0	173.9	182.2	251.7	1.74	0.96	4.68	
2,354.0	18.40	45.70	2,317.1	194.1	204.1	281.5	1.10	-0.21	-3.40	
2,448.0	18.50	44.80	2,406.3	215.0	225.2	311.2	0.32	0.11	-0.96	
2,542.0	17.50	44.20	2,495.7	235.7	245.6	340.3	1.08	-1.06	-0.64	
2,636.0	17.50	43.50	2,585.4	256.1	265.1	368.5	0.22	0.00	-0.74	
2,730.0	18.30	42.10	2,674.8	277.3	284.8	397.4	0.97	0.85	-1.49	
2,824.0	17.80	42.70	2,764.2	298.8	304.4	426.5	0.57	-0.53	0.64	
2,918.0	16.50	43.50	2,854.0	319.1	323.3	454.2	1.41	-1.38	0.85	
3,012.0	15.90	43.90	2,944.3	338.0	341.5	480.4	0.65	-0.64	0.43	
3,106.0	13.70	41.40	3,035.1	355.7	357.7	504.4	2.44	-2.34	-2.66	
3,200.0	14.80	41.90	3,126.3	373.0	373.1	527.5	1.18	1.17	0.53	
3,294.0	14.80	46.10	3,217.1	390.2	389.8	551.5	1.14	0.00	4.47	
3,387.0	15.60	44.80	3,306.9	407.3	407.2	575.9	0.93	0.86	-1.40	
3,481.0	16.60	45.20	3,397.2	425.8	425.6	602.0	1.07	1.06	0.43	
3,575.0	15.80	45.80	3,487.5	444.1	444.3	628.2	0.87	-0.85	0.64	
3,669.0	16.70	43.80	3,577.7	462.8	462.8	654.5	1.13	0.96	-2.13	
3,763.0	17.10	44.70	3,667.6	482.4	481.9	681.8	0.51	0.43	0.96	
3,857.0	16.20	44.80	3,757.7	501.5	500.9	708.8	0.96	-0.96	0.11	
3,951.0	15.80	44.10	3,848.1	520.0	519.0	734.7	0.47	-0.43	-0.74	
4,045.0	16.10	40.50	3,938.4	539.1	536.4	760.5	1.10	0.32	-3.83	
4,139.0	15.90	45.90	4,028.8	558.0	554.1	786.3	1.60	-0.21	5.74	
4,233.0	16.00	44.90	4,119.2	576.1	572.5	812.2	0.31	0.11	-1.06	
4,327.0	15.40	43.30	4,209.7	594.4	590.2	837.6	0.79	-0.64	-1.70	
4,421.0	17.20	41.90	4,299.9	613.8	608.0	864.0	1.96	1.91	-1.49	
4,515.0	16.00	41.20	4,390.0	633.9	625.8	890.8	1.29	-1.28	-0.74	
4,609.0	16.20	47.30	4,480.3	652.5	644.0	916.8	1.81	0.21	6.49	
4,703.0	16.70	42.50	4,570.5	671.4	662.8	943.4	1.54	0.53	-5.11	
4,797.0	14.20	42.50	4,661.1	689.9	679.7	968.4	2.66	-2.66	0.00	
4,891.0	13.30	43.80	4,752.4	706.2	695.0	990.8	1.01	-0.96	1.38	
4,985.0	13.30	45.70	4,843.8	721.5	710.2	1,012.4	0.46	0.00	2.02	
5,079.0	11.60	47.50	4,935.6	735.5	724.9	1,032.6	1.85	-1.81	1.91	
5,173.0	8.70	34.00	5,028.2	747.7	735.8	1,049.1	3.97	-3.09	-14.36	
5,267.0	6.40	21.60	5,121.3	758.5	741.7	1,060.9	2.99	-2.45	-13.19	
5,361.0	3.80	16.60	5,215.0	766.4	744.6	1,068.5	2.80	-2.77	-5.32	
5,454.0	2.50	15.20	5,307.8	771.3	746.0	1,073.0	1.40	-1.40	-1.51	
5,548.0	0.70	11.30	5,401.8	773.8	746.6	1,075.2	1.92	-1.91	-4.15	
5,642.0	1.50	333.10	5,495.8	775.5	746.2	1,076.1	1.11	0.85	-40.64	
5,645.9	1.51	333.78	5,499.6	775.6	746.1	1,076.1	0.49	0.16	17.58	
TARGET BHL 150'FSL, 2515'FWL										
5,736.0	1.70	347.90	5,589.7	777.9	745.3	1,077.3	0.49	0.22	15.67	
5,830.0	2.20	343.80	5,683.7	781.0	744.5	1,078.9	0.55	0.53	-4.36	
5,924.0	1.50	320.90	5,777.6	783.7	743.3	1,079.9	1.07	-0.74	-24.36	
6,018.0	0.90	326.90	5,871.6	785.3	742.1	1,080.2	0.65	-0.64	6.38	
6,112.0	2.00	6.00	5,965.6	787.5	741.8	1,081.6	1.51	1.17	41.60	
6,206.0	2.00	326.60	6,059.5	790.5	741.1	1,083.3	1.43	0.00	-41.91	
6,300.0	1.20	309.30	6,153.5	792.5	739.4	1,083.5	0.98	-0.85	-18.40	
6,393.0	1.20	294.30	6,246.5	793.6	737.8	1,083.1	0.34	0.00	-16.13	
6,487.0	2.00	290.00	6,340.4	794.5	735.4	1,082.1	0.86	0.85	-4.57	
6,552.3	2.32	317.96	6,405.6	795.9	733.4	1,081.7	1.67	0.49	42.84	

Company:	NOBLE ENERGY INC WELD COUNTY CO	Local Co-ordinate Reference:	Well Marley C01-28D
Project:	SEC.1-T4N-R64W	TVD Reference:	WELL @ 4618.0ft (Original Well Elev)
Site:	Marley C01-28D Pad Sec.1-T4N-R64W	MD Reference:	WELL @ 4618.0ft (Original Well Elev)
Well:	Marley C01-28D	North Reference:	True
Wellbore:	Wellbore #1	Survey Calculation Method:	Minimum Curvature
Design:	Wellbore #1	Database:	Landmark

Survey									
Measured Depth (ft)	Inclination (°)	Azimuth (°)	Vertical Depth (ft)	+N/-S (ft)	+E/-W (ft)	Vertical Section (ft)	Dogleg Rate (°/100ft)	Build Rate (°/100ft)	Turn Rate (°/100ft)
TARGET CIRCLE 150'FSL, 2515'FWL									
6,581.0	2.60	327.10	6,434.4	796.9	732.7	1,081.9	1.67	0.97	31.80
6,675.0	2.80	351.10	6,528.3	800.9	731.2	1,083.7	1.21	0.21	25.53
6,769.0	1.70	340.90	6,622.2	804.5	730.3	1,085.7	1.24	-1.17	-10.85
6,863.0	2.40	340.70	6,716.1	807.7	729.2	1,087.1	0.74	0.74	-0.21
6,957.0	2.80	344.30	6,810.0	811.8	728.0	1,089.2	0.46	0.43	3.83
6,988.0	2.80	346.40	6,841.0	813.2	727.6	1,089.9	0.33	0.00	6.77
HARDLINE 150'S & 136'E OF BHL									
7,038.0	2.80	346.40	6,890.9	815.6	727.0	1,091.2	0.00	0.00	0.00

Checked By: _____	Approved By: _____	Date: _____
-------------------	--------------------	-------------