

Well Name: **Cricket C22-30D**

Surface Location: Cricket C22-30D Pad Sec.21-T4N-R64W  
North American Datum 1983 US State Plane 1983 Colorado Northern Zone


Ground Elevation: 4687.0

| +N/-S | +E/-W | Northing   | Easting    | Latitude         | Longitude         |
|-------|-------|------------|------------|------------------|-------------------|
| 0.0   | 0.0   | 1354717.09 | 3265389.88 | 40° 18' 11.484 N | 104° 32' 54.420 W |

Original Well Elev WELL @ 4700.0ft (Original Well Elev)

Slot

## NOBLE ENERGY INC WELD COUNTY CO

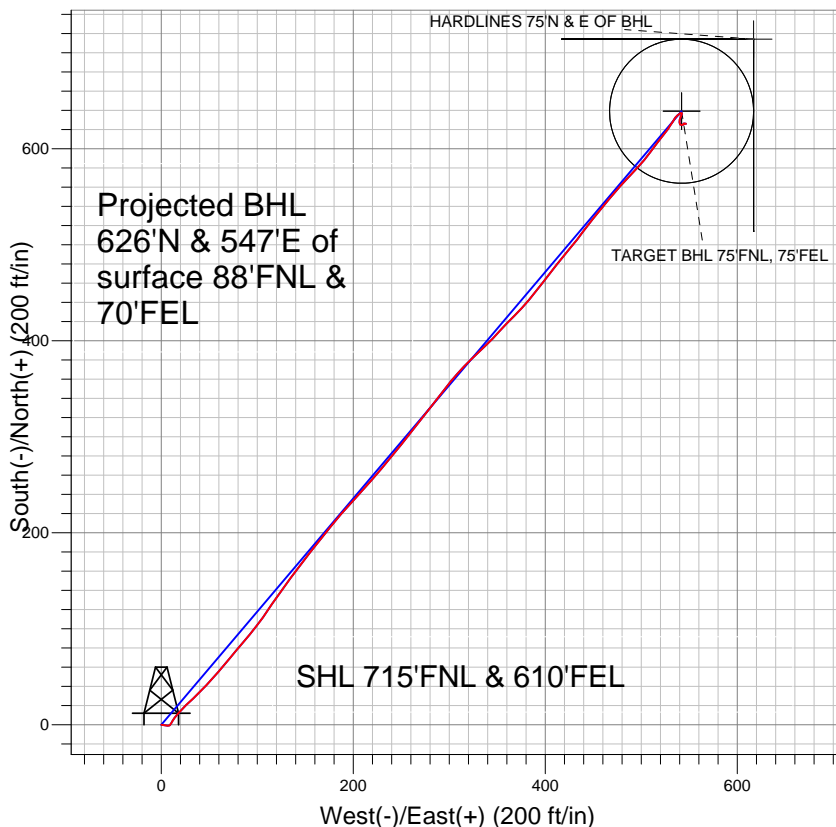


### LEGEND

- + Cricket C22-30D, Wellbore #1, Noble Cricket C22-30D Plan #2 (05-10-10) V0
- + Wellbore #1
- Survey #1

## Final Survey Plot

Projected Final Survey -  
7115'MD & 7021'TVD @ 831'VS  
0.4 deg Inc 109.4 deg AZ

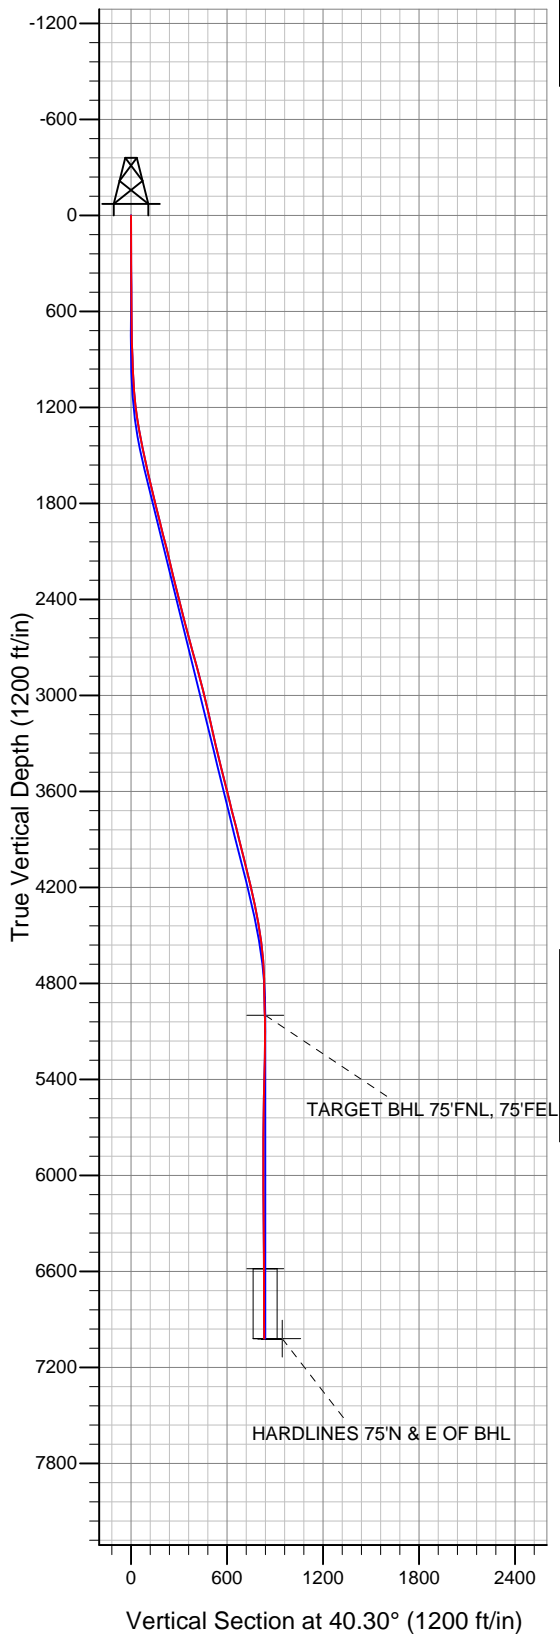

Project: SEC.21-T4N-R64W  
Site: Cricket C22-30D Pad Sec.21-T4N-R64W  
Well: Cricket C22-30D  
Plan: Wellbore #1



## **Directional**

# **NOBLE ENERGY INC WELD COUNTY CO**

**SEC.21-T4N-R64W**

**Cricket C22-30D Pad Sec.21-T4N-R64W**

**Cricket C22-30D**

**Wellbore #1**

**Survey: Survey #1**

## **Standard Survey Report**

**08 April, 2011**



|                  |                                     |                                     |  |
|------------------|-------------------------------------|-------------------------------------|--|
| <b>Company:</b>  | NOBLE ENERGY INC WELD COUNTY CO     | <b>Local Co-ordinate Reference:</b> | Site Cricket C22-30D Pad Sec.21-T4N-R64W |
| <b>Project:</b>  | SEC.21-T4N-R64W                     | <b>TVD Reference:</b>               | WELL @ 4700.0ft (Original Well Elev)     |
| <b>Site:</b>     | Cricket C22-30D Pad Sec.21-T4N-R64W | <b>MD Reference:</b>                | WELL @ 4700.0ft (Original Well Elev)     |
| <b>Well:</b>     | Cricket C22-30D                     | <b>North Reference:</b>             | True                                     |
| <b>Wellbore:</b> | Wellbore #1                         | <b>Survey Calculation Method:</b>   | Minimum Curvature                        |
| <b>Design:</b>   | Wellbore #1                         | <b>Database:</b>                    | Landmark                                 |

|                    |                                       |                      |                             |
|--------------------|---------------------------------------|----------------------|-----------------------------|
| <b>Project</b>     | SEC.21-T4N-R64W, WELD COUNTY COLORADO |                      |                             |
| <b>Map System:</b> | US State Plane 1983                   | <b>System Datum:</b> | Mean Sea Level              |
| <b>Geo Datum:</b>  | North American Datum 1983             |                      | Using Well Reference Point  |
| <b>Map Zone:</b>   | Colorado Northern Zone                |                      | Using geodetic scale factor |

|                              |                                     |                          |                   |
|------------------------------|-------------------------------------|--------------------------|-------------------|
| <b>Site</b>                  | Cricket C22-30D Pad Sec.21-T4N-R64W |                          |                   |
| <b>Site Position:</b>        |                                     | <b>Northing:</b>         | 1,354,717.10ft    |
| <b>From:</b>                 | Lat/Long                            | <b>Easting:</b>          | 3,265,389.88ft    |
| <b>Position Uncertainty:</b> | 0.0 ft                              | <b>Slot Radius:</b>      | "                 |
|                              |                                     | <b>Latitude:</b>         | 40° 18' 11.484 N  |
|                              |                                     | <b>Longitude:</b>        | 104° 32' 54.420 W |
|                              |                                     | <b>Grid Convergence:</b> | 0.61 °            |

|                             |                 |                            |                                  |
|-----------------------------|-----------------|----------------------------|----------------------------------|
| <b>Well</b>                 | Cricket C22-30D |                            |                                  |
| <b>Well Position</b>        | <b>+N/-S</b>    | 0.0 ft                     | <b>Northing:</b> 1,354,717.09 ft |
|                             | <b>+E/-W</b>    | 0.0 ft                     | <b>Easting:</b> 3,265,389.88 ft  |
| <b>Position Uncertainty</b> | 0.0 ft          | <b>Wellhead Elevation:</b> | ft                               |
|                             |                 | <b>Latitude:</b>           | 40° 18' 11.484 N                 |
|                             |                 | <b>Longitude:</b>          | 104° 32' 54.420 W                |
|                             |                 | <b>Ground Level:</b>       | 4,687.0 ft                       |

|                  |                   |                    |                        |                      |                            |
|------------------|-------------------|--------------------|------------------------|----------------------|----------------------------|
| <b>Wellbore</b>  | Wellbore #1       |                    |                        |                      |                            |
| <b>Magnetics</b> | <b>Model Name</b> | <b>Sample Date</b> | <b>Declination (°)</b> | <b>Dip Angle (°)</b> | <b>Field Strength (nT)</b> |
|                  | IGRF2010          | 4/21/2010          | 8.89                   | 67.05                | 53,227                     |

|                          |                              |                   |                   |                          |
|--------------------------|------------------------------|-------------------|-------------------|--------------------------|
| <b>Design</b>            | Wellbore #1                  |                   |                   |                          |
| <b>Audit Notes:</b>      |                              |                   |                   |                          |
| <b>Version:</b>          | 1.0                          | <b>Phase:</b>     | ACTUAL            | <b>Tie On Depth:</b> 0.0 |
| <b>Vertical Section:</b> | <b>Depth From (TVD) (ft)</b> | <b>+N/-S (ft)</b> | <b>+E/-W (ft)</b> | <b>Direction (°)</b>     |
|                          | 0.0                          | 0.0               | 0.0               | 40.30                    |

|                       |                |                          |                  |                    |
|-----------------------|----------------|--------------------------|------------------|--------------------|
| <b>Survey Program</b> | <b>Date</b>    | 4/8/2011                 |                  |                    |
| <b>From (ft)</b>      | <b>To (ft)</b> | <b>Survey (Wellbore)</b> | <b>Tool Name</b> | <b>Description</b> |
| 698.0                 | 7,115.0        | Survey #1 (Wellbore #1)  | MWD              | MWD - Standard     |

|                            |                        |                    |                            |                   |                   |                              |                              |                             |                            |
|----------------------------|------------------------|--------------------|----------------------------|-------------------|-------------------|------------------------------|------------------------------|-----------------------------|----------------------------|
| <b>Survey</b>              |                        |                    |                            |                   |                   |                              |                              |                             |                            |
| <b>Measured Depth (ft)</b> | <b>Inclination (°)</b> | <b>Azimuth (°)</b> | <b>Vertical Depth (ft)</b> | <b>+N/-S (ft)</b> | <b>+E/-W (ft)</b> | <b>Vertical Section (ft)</b> | <b>Dogleg Rate (°/100ft)</b> | <b>Build Rate (°/100ft)</b> | <b>Turn Rate (°/100ft)</b> |
| 0.0                        | 0.00                   | 0.00               | 0.0                        | 0.0               | 0.0               | 0.0                          | 0.00                         | 0.00                        | 0.00                       |
| 698.0                      | 1.10                   | 98.30              | 698.0                      | -1.0              | 6.6               | 3.6                          | 0.16                         | 0.16                        | 0.00                       |
| 792.0                      | 1.40                   | 61.00              | 791.9                      | -0.5              | 8.5               | 5.1                          | 0.90                         | 0.32                        | -39.68                     |
| 886.0                      | 2.10                   | 29.00              | 885.9                      | 1.5               | 10.4              | 7.9                          | 1.25                         | 0.74                        | -34.04                     |
| 979.0                      | 2.80                   | 30.40              | 978.8                      | 5.0               | 12.3              | 11.8                         | 0.76                         | 0.75                        | 1.51                       |
| 1,073.0                    | 3.80                   | 39.80              | 1,072.7                    | 9.3               | 15.5              | 17.2                         | 1.21                         | 1.06                        | 10.00                      |
| 1,167.0                    | 5.90                   | 42.70              | 1,166.3                    | 15.3              | 20.8              | 25.1                         | 2.25                         | 2.23                        | 3.09                       |
| 1,261.0                    | 8.40                   | 46.20              | 1,259.6                    | 23.6              | 29.0              | 36.8                         | 2.70                         | 2.66                        | 3.72                       |
| 1,355.0                    | 10.40                  | 45.90              | 1,352.3                    | 34.2              | 40.1              | 52.0                         | 2.13                         | 2.13                        | -0.32                      |
| 1,449.0                    | 11.70                  | 42.30              | 1,444.6                    | 47.2              | 52.6              | 70.0                         | 1.57                         | 1.38                        | -3.83                      |
| 1,543.0                    | 12.20                  | 38.80              | 1,536.5                    | 62.0              | 65.2              | 89.5                         | 0.94                         | 0.53                        | -3.72                      |
| 1,637.0                    | 12.70                  | 40.80              | 1,628.3                    | 77.6              | 78.2              | 109.7                        | 0.70                         | 0.53                        | 2.13                       |
| 1,731.0                    | 13.80                  | 39.80              | 1,719.8                    | 94.0              | 92.1              | 131.3                        | 1.20                         | 1.17                        | -1.06                      |

|                  |                                     |                                     |  |
|------------------|-------------------------------------|-------------------------------------|--|
| <b>Company:</b>  | NOBLE ENERGY INC WELD COUNTY CO     | <b>Local Co-ordinate Reference:</b> | Site Cricket C22-30D Pad Sec.21-T4N-R64W |
| <b>Project:</b>  | SEC.21-T4N-R64W                     | <b>TVD Reference:</b>               | WELL @ 4700.0ft (Original Well Elev)     |
| <b>Site:</b>     | Cricket C22-30D Pad Sec.21-T4N-R64W | <b>MD Reference:</b>                | WELL @ 4700.0ft (Original Well Elev)     |
| <b>Well:</b>     | Cricket C22-30D                     | <b>North Reference:</b>             | True                                     |
| <b>Wellbore:</b> | Wellbore #1                         | <b>Survey Calculation Method:</b>   | Minimum Curvature                        |
| <b>Design:</b>   | Wellbore #1                         | <b>Database:</b>                    | Landmark                                 |

## Survey

| Measured Depth (ft)              | Inclination (°) | Azimuth (°) | Vertical Depth (ft) | +N/-S (ft) | +E/-W (ft) | Vertical Section (ft) | Dogleg Rate (°/100ft) | Build Rate (°/100ft) | Turn Rate (°/100ft) |
|----------------------------------|-----------------|-------------|---------------------|------------|------------|-----------------------|-----------------------|----------------------|---------------------|
| 1,825.0                          | 13.80           | 35.00       | 1,811.1             | 111.8      | 105.7      | 153.6                 | 1.22                  | 0.00                 | -5.11               |
| 1,919.0                          | 14.30           | 34.10       | 1,902.3             | 130.6      | 118.6      | 176.3                 | 0.58                  | 0.53                 | -0.96               |
| 2,013.0                          | 14.40           | 37.10       | 1,993.4             | 149.5      | 132.2      | 199.5                 | 0.80                  | 0.11                 | 3.19                |
| 2,107.0                          | 13.80           | 37.50       | 2,084.5             | 167.7      | 146.1      | 222.4                 | 0.65                  | -0.64                | 0.43                |
| 2,201.0                          | 13.60           | 37.10       | 2,175.9             | 185.4      | 159.6      | 244.6                 | 0.24                  | -0.21                | -0.43               |
| 2,295.0                          | 13.10           | 39.40       | 2,267.3             | 202.5      | 173.0      | 266.3                 | 0.78                  | -0.53                | 2.45                |
| 2,389.0                          | 14.00           | 40.20       | 2,358.7             | 219.4      | 187.1      | 288.4                 | 0.98                  | 0.96                 | 0.85                |
| 2,483.0                          | 14.40           | 43.70       | 2,449.8             | 236.5      | 202.5      | 311.4                 | 1.01                  | 0.43                 | 3.72                |
| 2,577.0                          | 14.70           | 41.00       | 2,540.8             | 254.0      | 218.4      | 335.0                 | 0.79                  | 0.32                 | -2.87               |
| 2,671.0                          | 15.00           | 39.90       | 2,631.7             | 272.3      | 234.0      | 359.1                 | 0.44                  | 0.32                 | -1.17               |
| 2,765.0                          | 15.60           | 38.10       | 2,722.3             | 291.6      | 249.6      | 383.9                 | 0.81                  | 0.64                 | -1.91               |
| 2,859.0                          | 15.60           | 38.70       | 2,812.9             | 311.4      | 265.3      | 409.1                 | 0.17                  | 0.00                 | 0.64                |
| 2,953.0                          | 14.20           | 37.70       | 2,903.7             | 330.4      | 280.3      | 433.3                 | 1.51                  | -1.49                | -1.06               |
| 3,047.0                          | 14.20           | 38.00       | 2,994.8             | 348.6      | 294.5      | 456.3                 | 0.08                  | 0.00                 | 0.32                |
| 3,141.0                          | 12.60           | 41.10       | 3,086.3             | 365.4      | 308.3      | 478.1                 | 1.87                  | -1.70                | 3.30                |
| 3,235.0                          | 12.20           | 46.10       | 3,178.1             | 380.0      | 322.2      | 498.2                 | 1.22                  | -0.43                | 5.32                |
| 3,329.0                          | 13.70           | 46.40       | 3,269.7             | 394.6      | 337.4      | 519.2                 | 1.60                  | 1.60                 | 0.32                |
| 3,422.0                          | 13.10           | 42.30       | 3,360.2             | 410.0      | 352.5      | 540.7                 | 1.21                  | -0.65                | -4.41               |
| 3,516.0                          | 14.10           | 45.00       | 3,451.5             | 426.0      | 367.7      | 562.7                 | 1.26                  | 1.06                 | 2.87                |
| 3,610.0                          | 13.80           | 39.60       | 3,542.8             | 442.7      | 383.0      | 585.4                 | 1.42                  | -0.32                | -5.74               |
| 3,704.0                          | 14.50           | 37.90       | 3,633.9             | 460.6      | 397.4      | 608.3                 | 0.87                  | 0.74                 | -1.81               |
| 3,798.0                          | 14.20           | 37.70       | 3,725.0             | 479.0      | 411.6      | 631.6                 | 0.32                  | -0.32                | -0.21               |
| 3,892.0                          | 14.00           | 40.40       | 3,816.1             | 496.8      | 426.1      | 654.5                 | 0.73                  | -0.21                | 2.87                |
| 3,986.0                          | 13.10           | 36.30       | 3,907.5             | 514.1      | 439.7      | 676.5                 | 1.40                  | -0.96                | -4.36               |
| 4,080.0                          | 14.20           | 38.80       | 3,998.9             | 531.6      | 453.3      | 698.6                 | 1.33                  | 1.17                 | 2.66                |
| 4,174.0                          | 14.70           | 40.70       | 4,089.9             | 549.7      | 468.3      | 722.1                 | 0.73                  | 0.53                 | 2.02                |
| 4,268.0                          | 12.00           | 41.80       | 4,181.4             | 566.0      | 482.6      | 743.8                 | 2.88                  | -2.87                | 1.17                |
| 4,362.0                          | 12.60           | 44.10       | 4,273.2             | 580.6      | 496.2      | 763.8                 | 0.82                  | 0.64                 | 2.45                |
| 4,456.0                          | 12.40           | 35.50       | 4,365.0             | 596.2      | 509.2      | 784.1                 | 1.99                  | -0.21                | -9.15               |
| 4,550.0                          | 9.20            | 38.90       | 4,457.3             | 610.3      | 519.8      | 801.6                 | 3.47                  | -3.40                | 3.62                |
| 4,644.0                          | 6.50            | 35.50       | 4,550.4             | 620.5      | 527.6      | 814.5                 | 2.91                  | -2.87                | -3.62               |
| 4,738.0                          | 4.60            | 31.00       | 4,644.0             | 628.0      | 532.6      | 823.5                 | 2.07                  | -2.02                | -4.79               |
| 4,832.0                          | 2.20            | 34.80       | 4,737.8             | 632.7      | 535.6      | 829.0                 | 2.56                  | -2.55                | 4.04                |
| 4,926.0                          | 1.50            | 61.10       | 4,831.7             | 634.8      | 537.7      | 831.9                 | 1.15                  | -0.74                | 27.98               |
| 5,020.0                          | 1.40            | 44.70       | 4,925.7             | 636.2      | 539.6      | 834.2                 | 0.45                  | -0.11                | -17.45              |
| 5,094.3                          | 0.52            | 52.93       | 5,000.0             | 637.1      | 540.5      | 835.5                 | 1.19                  | -1.18                | 11.07               |
| <b>TARGET BHL 75'FNL, 75'FEL</b> |                 |             |                     |            |            |                       |                       |                      |                     |
| 5,114.0                          | 0.30            | 63.10       | 5,019.7             | 637.2      | 540.6      | 835.6                 | 1.19                  | -1.14                | 51.73               |
| 5,208.0                          | 0.80            | 93.80       | 5,113.7             | 637.2      | 541.5      | 836.2                 | 0.60                  | 0.53                 | 32.66               |
| 5,302.0                          | 0.30            | 114.20      | 5,207.7             | 637.1      | 542.4      | 836.7                 | 0.56                  | -0.53                | 21.70               |
| 5,396.0                          | 1.60            | 199.10      | 5,301.7             | 635.7      | 542.2      | 835.5                 | 1.70                  | 1.38                 | 90.32               |
| 5,490.0                          | 1.80            | 208.50      | 5,395.6             | 633.2      | 541.0      | 832.9                 | 0.36                  | 0.21                 | 10.00               |
| 5,584.0                          | 1.50            | 190.00      | 5,489.6             | 630.7      | 540.1      | 830.4                 | 0.65                  | -0.32                | -19.68              |
| 5,677.0                          | 1.20            | 182.10      | 5,582.6             | 628.5      | 539.9      | 828.5                 | 0.38                  | -0.32                | -8.49               |
| 5,771.0                          | 0.70            | 163.90      | 5,676.6             | 627.0      | 540.0      | 827.5                 | 0.61                  | -0.53                | -19.36              |
| 5,865.0                          | 0.40            | 176.70      | 5,770.6             | 626.1      | 540.2      | 826.9                 | 0.34                  | -0.32                | 13.62               |
| 5,959.0                          | 0.50            | 131.90      | 5,864.6             | 625.5      | 540.5      | 826.6                 | 0.38                  | 0.11                 | -47.66              |
| 6,053.0                          | 0.60            | 130.40      | 5,958.6             | 624.9      | 541.2      | 826.6                 | 0.11                  | 0.11                 | -1.60               |
| 6,147.0                          | 0.50            | 70.60       | 6,052.5             | 624.7      | 541.9      | 827.0                 | 0.59                  | -0.11                | -63.62              |
| 6,241.0                          | 0.70            | 84.90       | 6,146.5             | 624.9      | 542.9      | 827.8                 | 0.26                  | 0.21                 | 15.21               |
| 6,334.0                          | 0.30            | 81.50       | 6,239.5             | 625.0      | 543.7      | 828.3                 | 0.43                  | -0.43                | -3.66               |
| 6,428.0                          | 0.30            | 348.90      | 6,333.5             | 625.3      | 543.9      | 828.7                 | 0.46                  | 0.00                 | -98.51              |
| 6,522.0                          | 0.60            | 24.10       | 6,427.5             | 626.0      | 544.1      | 829.3                 | 0.42                  | 0.32                 | 37.45               |
| 6,616.0                          | 0.30            | 101.60      | 6,521.5             | 626.4      | 544.5      | 829.9                 | 0.65                  | -0.32                | 82.45               |

|                  |                                     |                                     |  |
|------------------|-------------------------------------|-------------------------------------|--|
| <b>Company:</b>  | NOBLE ENERGY INC WELD COUNTY CO     | <b>Local Co-ordinate Reference:</b> | Site Cricket C22-30D Pad Sec.21-T4N-R64W |
| <b>Project:</b>  | SEC.21-T4N-R64W                     | <b>TVD Reference:</b>               | WELL @ 4700.0ft (Original Well Elev)     |
| <b>Site:</b>     | Cricket C22-30D Pad Sec.21-T4N-R64W | <b>MD Reference:</b>                | WELL @ 4700.0ft (Original Well Elev)     |
| <b>Well:</b>     | Cricket C22-30D                     | <b>North Reference:</b>             | True                                     |
| <b>Wellbore:</b> | Wellbore #1                         | <b>Survey Calculation Method:</b>   | Minimum Curvature                        |
| <b>Design:</b>   | Wellbore #1                         | <b>Database:</b>                    | Landmark                                 |

| Survey                               |                 |             |                     |            |            |                       |                       |                      |                     |
|--------------------------------------|-----------------|-------------|---------------------|------------|------------|-----------------------|-----------------------|----------------------|---------------------|
| Measured Depth (ft)                  | Inclination (°) | Azimuth (°) | Vertical Depth (ft) | +N/-S (ft) | +E/-W (ft) | Vertical Section (ft) | Dogleg Rate (°/100ft) | Build Rate (°/100ft) | Turn Rate (°/100ft) |
| 6,677.5                              | 0.16            | 89.26       | 6,583.0             | 626.3      | 544.7      | 830.0                 | 0.24                  | -0.22                | -20.09              |
| <b>TARGET CIRCLE 75'FNL, 75'FEL</b>  |                 |             |                     |            |            |                       |                       |                      |                     |
| 6,710.0                              | 0.10            | 69.40       | 6,615.5             | 626.4      | 544.8      | 830.1                 | 0.24                  | -0.19                | -61.01              |
| 6,804.0                              | 0.50            | 132.50      | 6,709.5             | 626.1      | 545.2      | 830.1                 | 0.49                  | 0.43                 | 67.13               |
| 6,898.0                              | 0.40            | 47.60       | 6,803.5             | 626.0      | 545.7      | 830.5                 | 0.65                  | -0.11                | -90.32              |
| 6,992.0                              | 0.00            | 108.10      | 6,897.5             | 626.3      | 546.0      | 830.8                 | 0.43                  | -0.43                | 0.00                |
| 7,065.0                              | 0.40            | 109.40      | 6,970.5             | 626.2      | 546.2      | 830.9                 | 0.55                  | 0.55                 | 0.00                |
| 7,114.7                              | 0.40            | 109.40      | 7,020.3             | 626.1      | 546.5      | 831.0                 | 0.00                  | 0.00                 | 0.00                |
| <b>HARDLINES 75'N &amp; E OF BHL</b> |                 |             |                     |            |            |                       |                       |                      |                     |
| 7,115.0                              | 0.40            | 109.40      | 7,020.5             | 626.1      | 546.5      | 831.0                 | 0.00                  | 0.00                 | 0.00                |

Checked By: \_\_\_\_\_ Approved By: \_\_\_\_\_ Date: \_\_\_\_\_