


# WELL LOCATION CERTIFICATE: NORTHGLENN STATE 19-36

SECTION 36, TOWNSHIP 1 NORTH, RANGE 68 WEST, 6TH P.M.

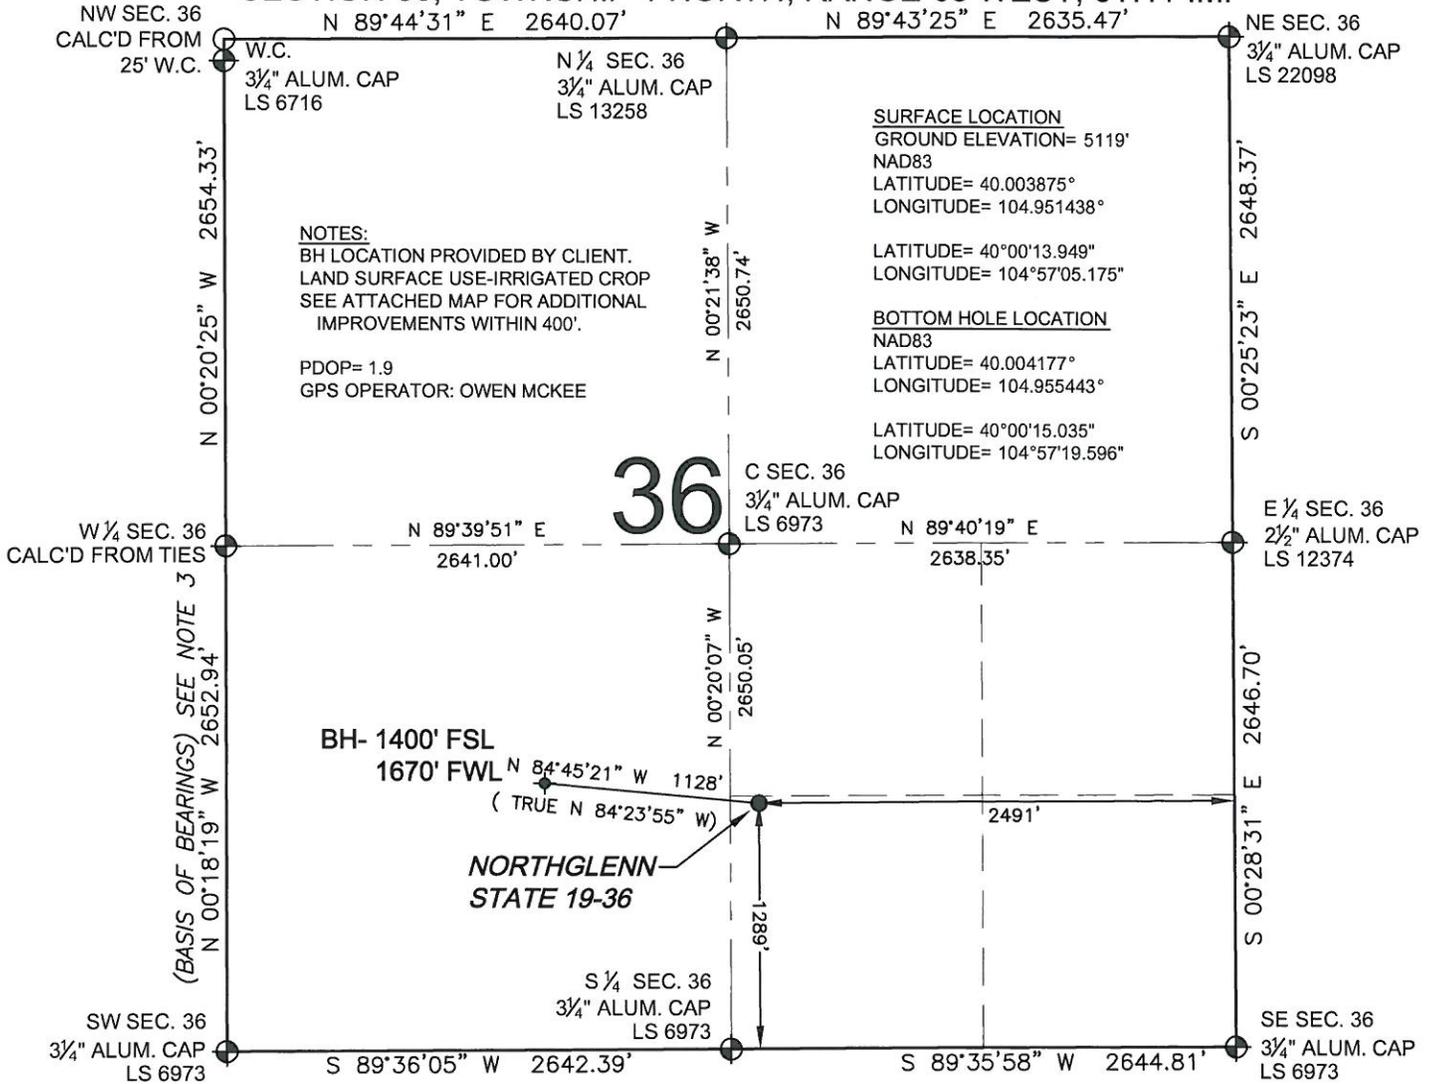

0 500 1000

SCALE: 1"=1000'



PREPARED BY:  Petroleum Field Services, LLC 1801 W. 13th Ave. Denver, CO 80224	FIELD DATE: 04-14-11	SURFACE LOCATION:
	DRAWING DATE: 05-02-11	SW 1/4 SE 1/4, SEC. 36, T1N, R68W
	BY: SMF	WELD COUNTY, COLORADO