
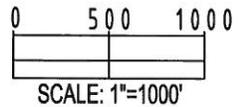


# WELL LOCATION CERTIFICATE: STATE OF CO 5-24XHZ

SECTION 24, TOWNSHIP 5 SOUTH, RANGE 65 WEST, 6TH P.M.

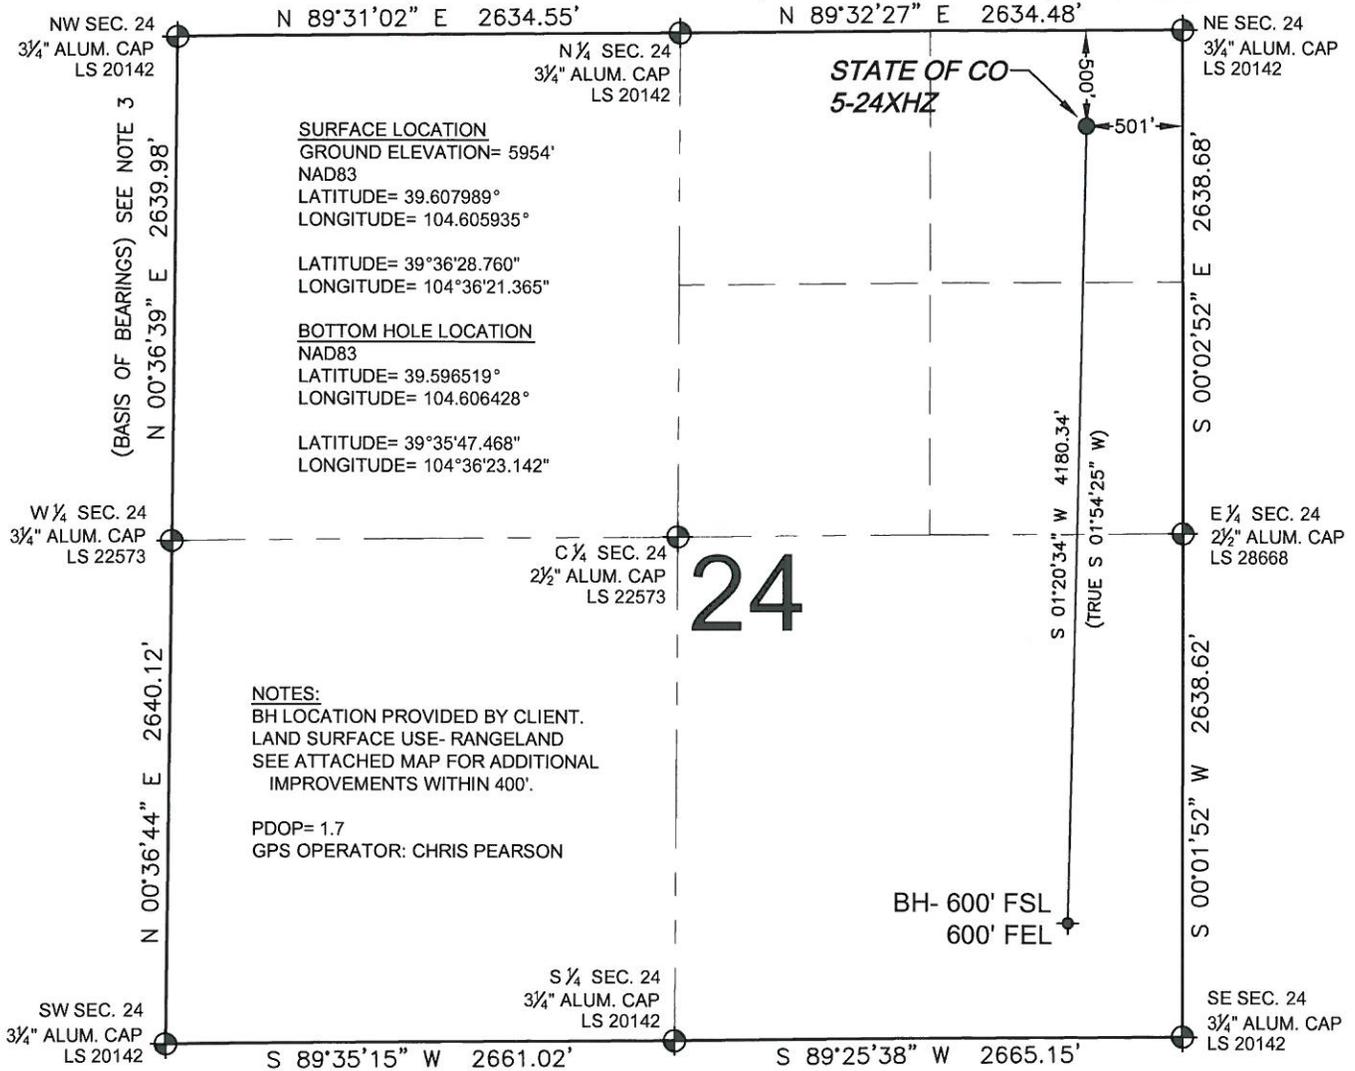

PREPARED BY:  PFS Petroleum Field Services, LLC 1801 W. 13th Ave. Denver, CO 80204	FIELD DATE: 04-28-11	SURFACE LOCATION: NE 1/4 NE 1/4, SEC. 24, T5S, R65W
	DRAWING DATE: 09-12-11	ARAPAHOE COUNTY, COLORADO
	BY: SMF	