



Krabacher, Jay

From: Krabacher, Jay
Sent: Wednesday, September 21, 2011 4:44 PM
To: 'Barber, Matt'; King, Kevin
Cc: Andrews, David; Woodworth, Ty; Neifert-Kraiser, Angela; Salazar, Sandi; Beougher, Justin
Subject: RE: CBL deferment on the Jolley KP 542-17 well
Attachments: Jay Krabacher.vcf

Matt:

Williams is authorized to delay running the CBL on this well.

Regards,

Jay Krabacher

Jay Krabacher

COGCC
Petroleum Engineer, EIT - II

(970) 625-2497 Work
(970) 589-6180 Mobile
Jay.Krabacher@state.co.us
Oil & Gas Conservation Commission
707 Wapiti Ct., # 204
Rifle, CO 81650

From: Barber, Matt [<mailto:Matt.Barber@williams.com>]

Sent: Monday, September 19, 2011 2:35 PM

To: King, Kevin

Cc: Andrews, David; Krabacher, Jay; Woodworth, Ty; Neifert-Kraiser, Angela; Salazar, Sandi; Beougher, Justin

Subject: CBL deferment on the Jolley KP 542-17 well

Kevin:

Williams Production RMT Co. LLC is requesting a CBL deferment on the Jolley KP 542-17 located in the SWNE of Section 17, T6S-R91W. Attached is a temperature survey that was performed after cementing the 4 ½" production casing on the subject well. Also, attached is a bradenhead pressure summary.

Information pertaining to the request is as follows:

Well: Jolley KP 542-17
API: 05-045-17894-00
Location: SWNE, Section 17, T6S-R91W
Surface Csg: 9 5/8" set and cemented at 850'
Production Csg Cement Date: 4 ½" @ 7,140' – cemented 9/15/2011
Cement: 1465 sks
Cement top from survey: 1600' (Estimated)
Estimated top of gas: 4,496'
Temp Survey: Attached
Volume to fill annular: Hole remained full following cementing operations

Please let me know if you need additional information to approve this deferment. After deferment is received, Williams will continue to monitor the bradenhead pressure until CBL is run and notify if pressure exceeds 150 psig.

BAKER HUGHES

DIFFERENTIAL TEMPERATURE LOG GAMMA RAY LOG

FILE NO:		COMPANY	
APN NO: 05046172840000		WILLIAMS PRODUCTION RMT COMPANY	
Ver. 3.87		WELL JOLLEY KP 342-17	
S:17 T:05 R:91W PAD: KP 32-17 RIG: CYCLONE 17		FIELD KOKOPPELL	
LOCATION: SHL: 1857' P.N. & 1780' FEL. BHL: 2434' P.N. & 880' FEL.		COUNTY GARFIELD	
SEC 17 TWP 25S RGE 21W		STATE COLORADO	
PERMANENT DATUM LOG MEASURED FROM DRILL MEAS. FROM		OTHER SERVICES NONE	
G.L. _____ ELEVATION 8171 FT K.B. _____ 23 FT ABOVE P.D. KELLY BUSHING _____		ELEVATIONS: KB 8194 FT DF 8183 FT QL 8171 FT	
DATE	15-Sep-2011		
RUN	1	TRIP	
SERVICE ORDER	9/22/05	1	
DEPTH DRILLER	7116 FT		
DEPTH LOGGER	7116 FT		
BOTTOM LOGGED INTERVAL	7116 FT		
TOP LOGGED INTERVAL	0 FT		
TIME STARTED	19:00		
TIME FINISHED	21:00		
OPERATOR RIG TIME	2 HOURS		
TYPE OF FLUID IN HOLE	WATER		
FLUID DENSITY	8.3 LB/G		
FLUID SALINITY	N/A		
FLUID LEVEL	0 FT		
LOGGED CEMENT TOP	N/A		
WELLHEAD PRESSURE	0 PSI		
MAXIMUM HOLE DEVIATION	N/A		
NOMINAL LOGGING SPEED	100 F/IN		
MAX. RECORDED TEMP.	183 DEGF		
REFERENCE LOG	N/A		
REFERENCE LOG DATE	N/A		
EQUIP. NO.	14-6741	GRAND JCT	
RECORDED BY	DONALDSON		
WITNESSED BY	MILNERIN		

IN MAKING INTERPRETATIONS OF LOGS OUR EMPLOYEES WILL GIVE CUSTOMER THE BENEFIT OF THEIR BEST JUDGEMENT. BUT SINCE ALL INTERPRETATIONS ARE OPINIONS BASED ON INFERENCES FROM ELECTRICAL OR OTHER MEASUREMENTS, WE CANNOT, AND WE DO NOT GUARANTEE THE ACCURACY OR CORRECTNESS OF ANY INTERPRETATION. WE SHALL NOT BE LIABLE OR RESPONSIBLE FOR ANY LOSS, COST, DAMAGES, OR EXPENSES WHATSOEVER INCURRED OR SUSTAINED BY THE CUSTOMER RESULTING FROM ANY INTERPRETATION MADE BY ANY OF OUR EMPLOYEES.

REMARKS

- RUN 1 TRIP 1:
- * PAD: KP 32-17
 - * RIG: CYCLONE 17
 - * CREW: COATE/ROBERTSON
 - * THANK YOU FOR CHOOSING BAKER HUGHES WIRELINE SYSTEMS

RECEIVED


SEP 20 2011

COGCC/Rifle Office

EQUIPMENT DATA

RUN	TRIP	TOOL	SERIES NO.	SERIAL NO.	POSITION
1	1	GR	35185A	10110804	FRT
1	1	TEMP	20785D	10128274	FRT

Bradenhead Pressure Summary

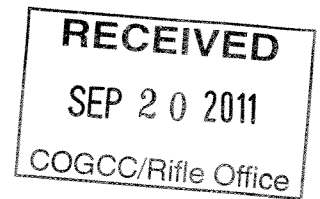

WELL: Jolley KP 542-17

LOCATION: SWNE SEC. 17 T6S-R91W 6TH PM

API#: 05-045-17894-00

TEMP. LOG RUN DATE: 09/15/2011

TOP OF CEMENT: 1600' (Estimated)


TOP OF GAS: 4496'

BRADENHEAD PRESSURES (psig)

MONITOR PRESSURE ON KP 542-17

DATE	HRS.	PSI	FLUID TO FILL
9/15/2011 19:00	6	0	0 GALS
9/16/2011 01:00	12	0	25 GALS
9/16/2011 13:00	24	0	10 GALS
9/17/2011 13:00	48	0	0 GALS
9/18/2011 13:00	72	0	0 GALS

JOLLEY KP 542-17

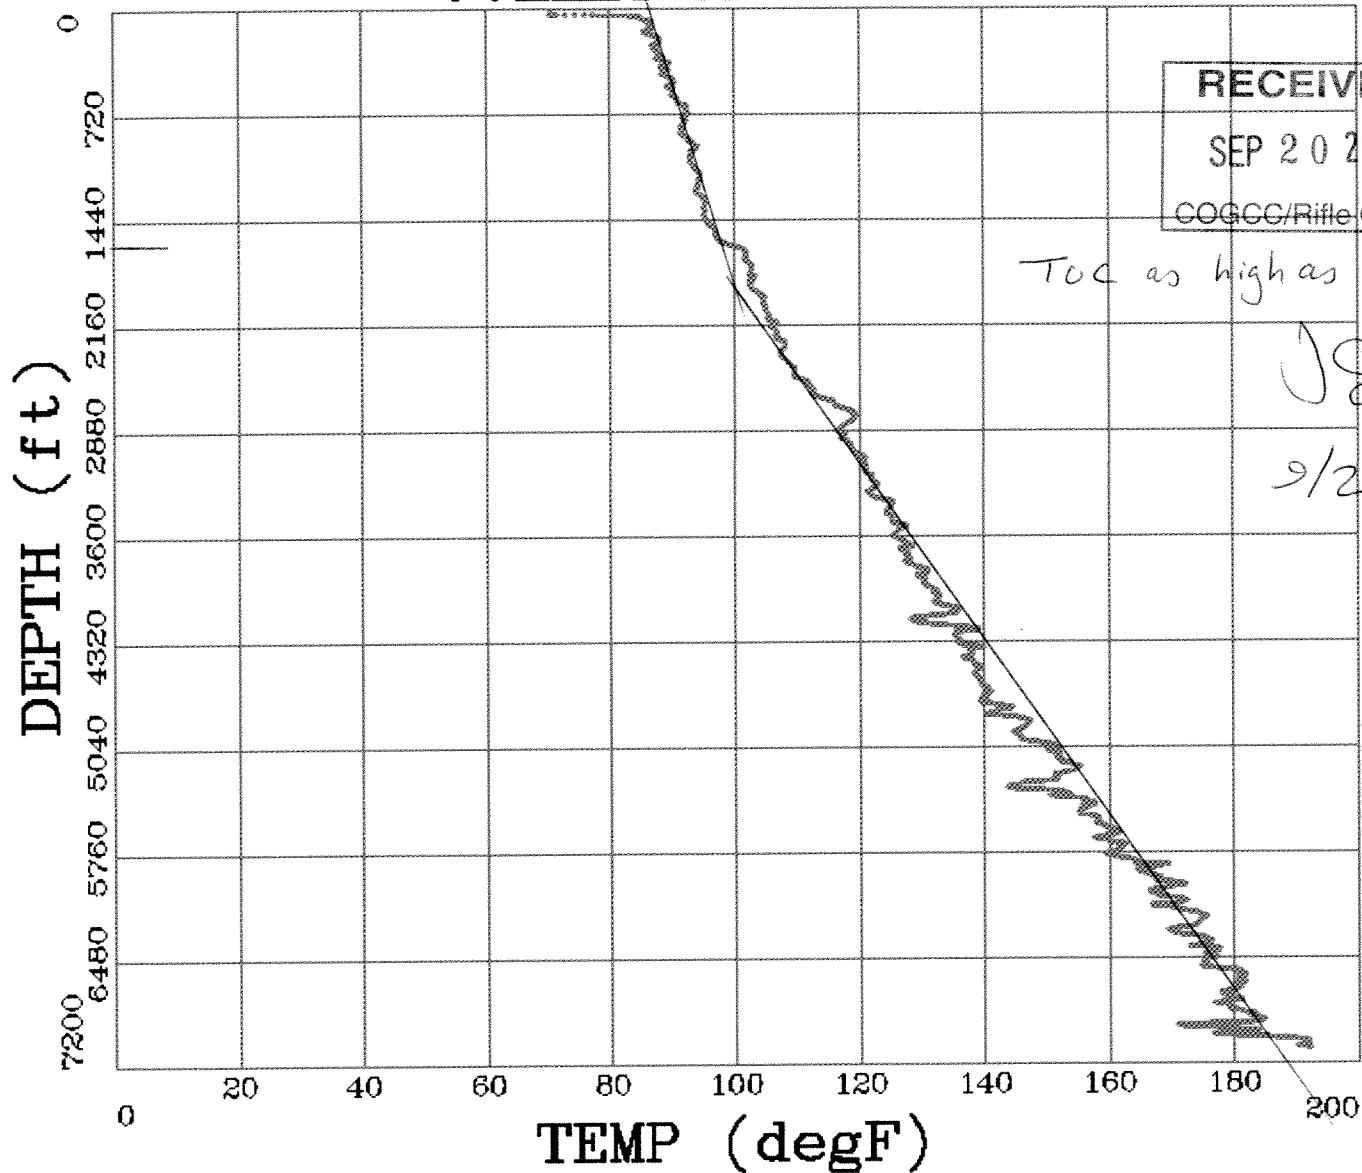

ZONE A

FILE NAME : /data/575285/m970a~~~01.aiff

INTERVAL : 23.25 - 7104.75 feet

X AXIS: 0. 200 TEMP (degF)

Y AXIS: 7200. 0 DEPTH (ft)

MAIN LOG 2"/100FT SCALE

ECLIPS 6.11 Aug 06, 2010
Updates: 1,33 Patches: 1

Thu Sep 15 19:21:54 2011

Perplf /main/62

Cplot

Pdf_Cpp /main/16

Fileview 5.51

PARAMETER AND FILTER SUMMARY REPORT