


**CURRENT WELLBORE DIAGRAM**

Operator: Encana Oil & Gas (USA) Inc.  
 Well Name: CATHEDRAL FEDERAL 20-1  
 Lease Number: COC1633  
 Unit Number: COC047603C  
 Location: NWNW Sec.20 -T3S -R101W  
 Field: Cathedral  
 County, State: Rio Blanco, CO  
 API Number: 05-103-07813-0000  
 Diagram Date: As of 09/21/2011

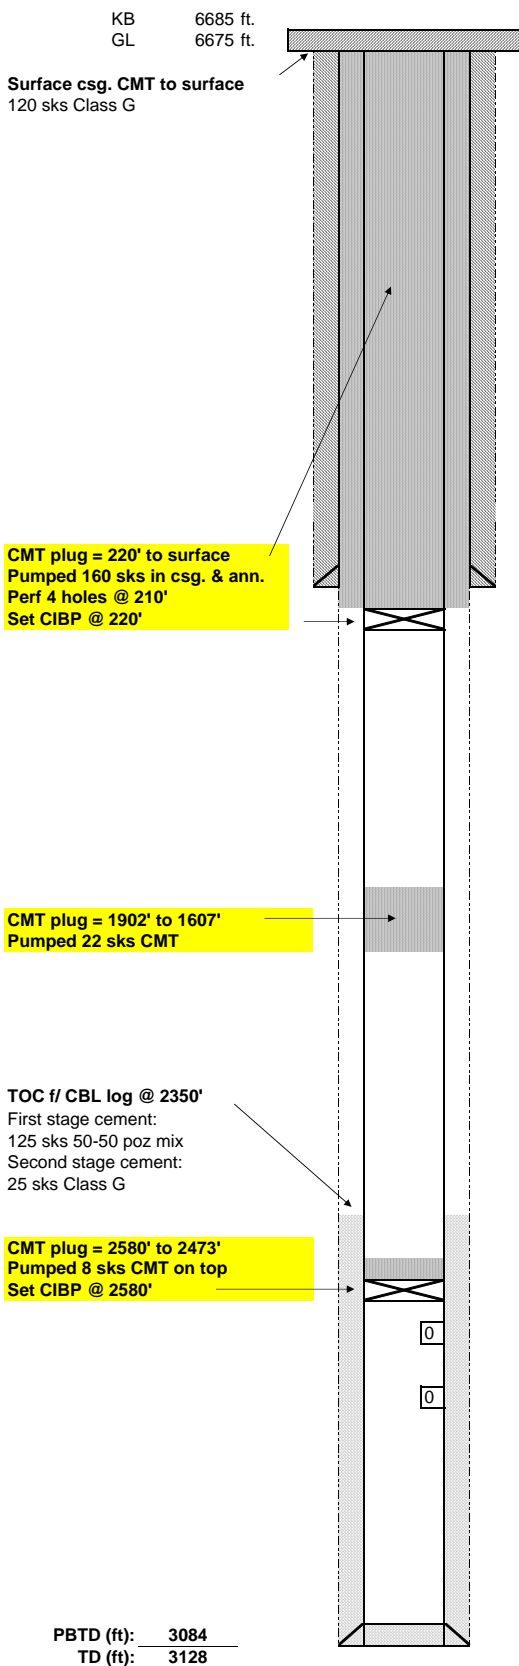

**CASING RECORD**

SIZE (in)	WT (lb/ft)	GRADE	Hole D(in)	TOP (ft)	BTM (ft)	Date Run
8 5/8	24	assumed J-55	12 1/4	0	158	
4 1/2	10.5	assumed J-55	7 7/8	0	3,128	

**TUBING RECORD**

SIZE (in)	WT (lb/ft)	GRADE	TOP (ft)	BTM (ft)	Date Run

**JEWELRY RECORD**

ITEM	MAKER	SIZE (in)	Max ID	TOP (ft)	Date Run

**PERFORATION RECORD**

ZONE	TOP (ft)	BTM (ft)	SPF	Holes	Date Shot
Emery	2668	2930		30	05/10/1976

**COMMENTS/HISTORY:**

05/04/1976	Re-run Bond Log. 1st Bond Log shows poor bonding characteristics
05/05/1976	Perfed 4 holes at 2944'. Attempted to squeeze, FAILED.
05/06/1976	Perfed 4 holes at 2804'. Squeezed 20 sks Class G CMT.
05/07/1976	Tagged cement at 2602'. Drilled out to PBTd @ 3084'.

**P&A DATE = 07/28/2011**