




Lease Name: RBF #14-15D

Legals: SESW – Sec. 15, T6N, R67W

County: Weld County, Colorado

API#: 05-123-32061

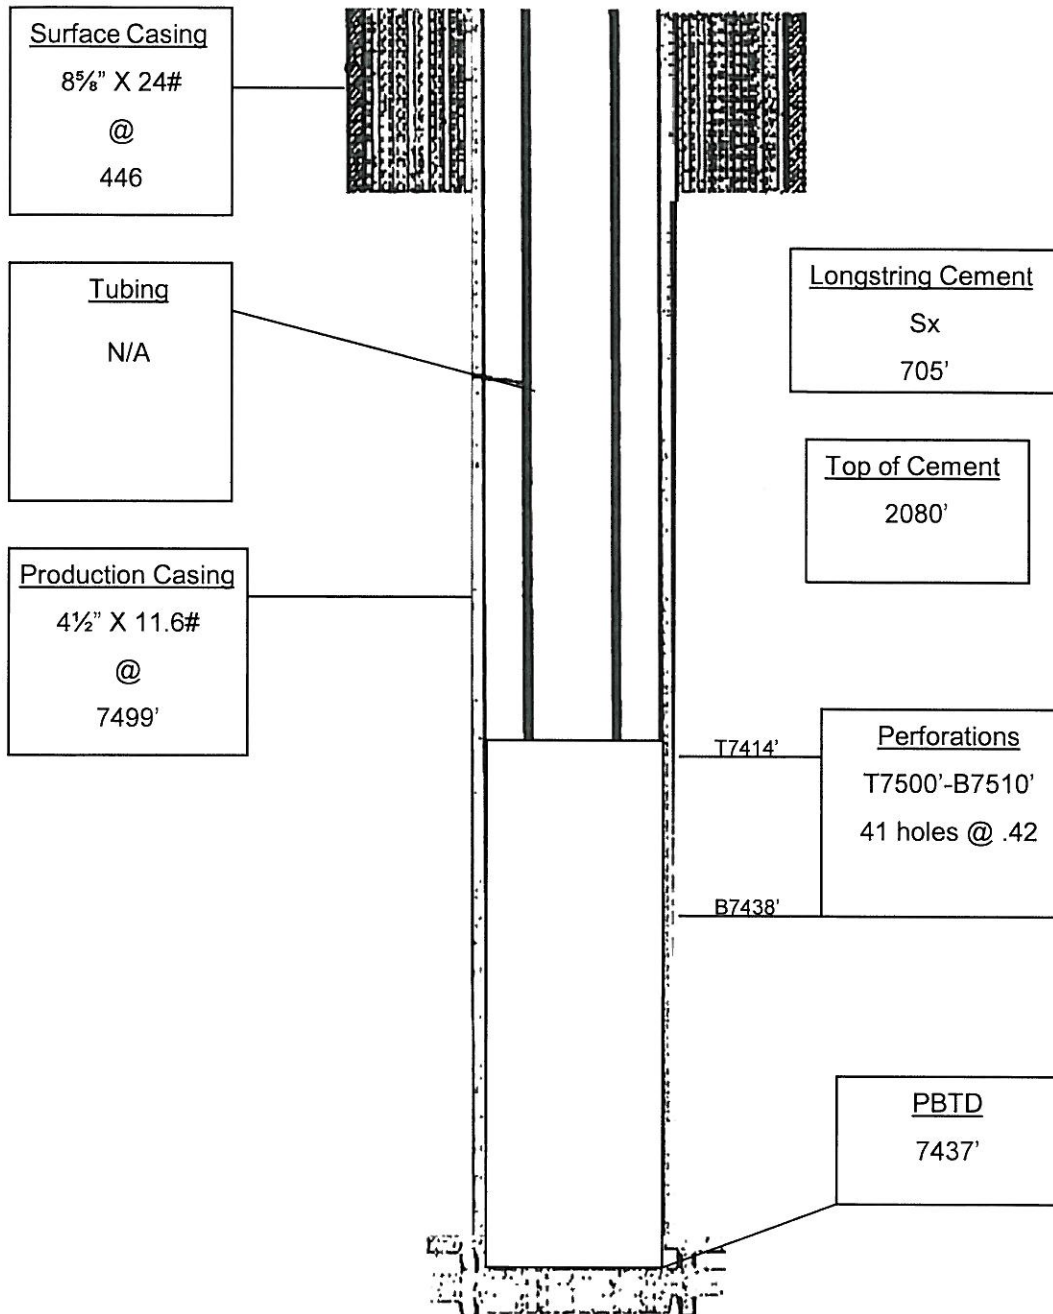

Wellbore Diagram