


F:\PLS C-40\2011\11162\cay\p\lbo_14-17_MTC-arq_9/9/2011 8:46:44 AM

THIS MAP DOES NOT REPRESENT A BOUNDARY SURVEY

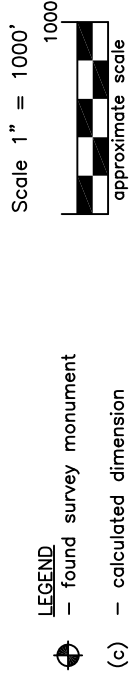

John Robert McGehee LS#38219
Well: Melbon Ranch 14-17 WLC