



State of Colorado Oil and Gas Conservation Commission

1120 Lincoln Street, Suite 801, Denver, Colorado 80203 Phone: (303)894-2100 Fax: (303)894-2109

RECEIVED SEP 1 2011 COGCC/Rifle Office

Submit original plus one copy. This form is to be used for general, technical and environmental sundry information. For proposed or completed operations, describe in full on Technical Information Page (Page 2 of this form.) Identify well or other facility by API Number or by OGCC Facility ID. Operator shall send an informational copy of all sundry notices for wells located in High Density Areas to the Local Government Designee (Rule 603b.)

1. OGCC Operator Number: 10071 2. Name of Operator: Bill Barrett Corp 3. Address: 1099 18th Street Suite 2300 City: Denver State: CO Zip 80202 4. Contact Name: Mary Pobuda Phone: 303-312-8511 Fax: 303-291-0420 5. API Number 05-045-19648 6. Well/Facility Name: Kaufman 7. Well/Facility Number 23D-24-692 8. Location (Qtr/Qtr, Sec, Twp, Rng, Meridian): NWSE, Sec. 24, T6S-R92W 6th PM 9. County: Garfield 10. Field Name: Mamm Creek 11. Federal, Indian or State Lease Number: Survey Plat Directional Survey Surface Eqpmt Diagram Technical Info Page Other

General Notice

CHANGE OF LOCATION: Attach New Survey Plat (a change of surface qtr/qtr is substantive and requires a new permit) Change of Surface Footage from Exterior Section Lines: Change of Surface Footage to Exterior Section Lines: Change of Bottomhole Footage from Exterior Section Lines: Change of Bottomhole Footage to Exterior Section Lines: Bottomhole location Qtr/Qtr, Sec, Twp, Rng, Mer: Latitude Longitude Ground Elevation GPS DATA: Date of Measurement PDOP Reading Instrument Operator's Name CHANGE SPACING UNIT Formation Formation Code Spacing order number Unit Acreage Unit configuration REMOVE FROM SURFACE BOND Signed surface use agreement attached CHANGE OF OPERATOR (prior to drilling): Effective Date: Plugging Bond: Blanket Individual CHANGE WELL NAME NUMBER From: To: Effective Date: ABANDONED LOCATION: Was location ever built? Yes No Is site ready for inspection? Yes No Date Ready for Inspection: NOTICE OF CONTINUED SHUT IN STATUS Date well shut in or temporarily abandoned: Has Production Equipment been removed from site? Yes No MIT required if shut in longer than two years. Date of last MIT SPUD DATE: REQUEST FOR CONFIDENTIAL STATUS (6 mos from date casing set) SUBSEQUENT REPORT OF STAGE, SQUEEZE OR REMEDIAL CEMENT WORK Method used Cementing tool setting/perf depth Cement volume Cement top Cement bottom Date RECLAMATION: Attach technical page describing final reclamation procedures per Rule 1004. Final reclamation will commence on approximately Final reclamation is completed and site is ready for inspection.

Technical Engineering/Environmental Notice

X Notice of Intent Approximate Start Date: 10/1/11 Report of Work Done Date Work Completed: Details of work must be described in full on Technical Information Page (Page 2 must be submitted.) Intent to Recomplete (submit form 2) Change Drilling Plans Gross Interval Changed? Casing/Cementing Program Change Request to Vent or Flare Repair Well Rule 502 variance requested Other: Proposed Re-Cement Sqz for Spills and Releases E&P Waste Disposal Beneficial Reuse of E&P Waste Status Update/Change of Remediation Plans

I hereby certify that the statements made in this form are, to the best of my knowledge, true, correct and complete.

Signed: Mary Pobuda Date: 9/16/11 Email: mpobuda@billbarrettcorp.com Print Name: Mary Pobuda Title: Permit Analyst

COGCC Approved: [Signature] Title: EIT III Date: SEP 28 2011

CONDITIONS OF APPROVAL, IF ANY:

**TECHNICAL INFORMATION PAGE**



FOR OGCC USE ONLY

**RECEIVED**  
SEP 16 2011  
OGCC/Rifle Office

1. OGCC Operator Number: 10071 API Number: 05-045-19648  
 2. Name of Operator: Bill Barrett Corporation OGCC Facility ID # \_\_\_\_\_  
 3. Well/Facility Name: Kaufman Well/Facility Number: 23D-24-692  
 4. Location (QtrQtr, Sec, Twp, Rng, Meridian): NWSE, Sec. 24, T6S-R92W 6th PM

This form is to be completed whenever a Sundry Notice is submitted requiring detailed report of work to be performed or completed. This form shall be transmitted within 30 days of work completed as a "subsequent" report and must accompany Form 4, page 1.

**5. DESCRIBE PROPOSED OR COMPLETED OPERATIONS**

On the Kaufman 23D-24-692 the cement company had mechanical issues during the job and failed to meet the COGCC requirements for top of cement. BBC would now like to propose a re-cement squeeze job to increase the top of cement in order to complete the permitted formations. The procedures below outline this proposed re-cement squeeze job.

Approval is needed by 10/1/11  
 Please contact Justin Pivik at 303-312-8583 with questions.

**General Procedure:**

1. Set FasDrill composite bridge plug at ± 5880 ft (below re-cement perms).
2. Perforate 3 spf 5830-5831.
3. Establish circulation with rig pump.
4. Set Fas Drill composite cement retainer at ± 5780 ft (above re-cement perms).
5. Sting into FasDrill with tubing and stinger.
6. Open the surface casing valve at the wellhead.
7. Pump through the tubing and FasDrill and attempt to establish circulation between the 4 ½" Production casing and 7 7/8" open hole.
8. Re-Cement the 4 ½" casing from 5880 ft to 4300 ft using below pump schedule:

**Detailed Pumping Schedule**

| Fluid # | Fluid Type | Fluid Name               | Surface Density lbm/gal | Estimated Avg Rate bbl/min | Downhole Volume |
|---------|------------|--------------------------|-------------------------|----------------------------|-----------------|
| 1       | Spacer     | FRESH WATER              | 8.3                     | 5.0                        | 20 bbl          |
| 2       | Spacer     | MUD FLUSH III            | 8.4                     | 5.0                        | 20 bbl          |
| 3       | Cement     | SQUEEZECEM               | 13.0                    | 5.0                        | 325 sks         |
| 4       | Cement     | PREMIUM CLASS G          | 15.8                    | 5.0                        | 50 sks          |
| 5       | Spacer     | CLAYFIX III DISPLACEMENT | 8.4                     | 5.0                        | 90.63 bbl       |

9. Sting out of the FasDrill composite cement retainer leaving about ½ bbl of cement on top of the Fas Drill.
10. WOC overnight.
11. Drill out cement, Fas Drill cement retainer and Fas Drill bridge plug.
12. Run Bond log 7 day later to insure cement quality



# Bill Barrett Corporation

## Downhole Well Profile

RECEIVED

SEP 16 2011


COGCC/Rifle Office

Well Name: Kaufman 23D-24-692

|  |  |                                   |                                    |  |                             |
|--|--|-----------------------------------|------------------------------------|--|-----------------------------|
| Well Name<br>Kaufman 23D-24-692              | API/UWI<br>05-045-19648                | License #                         | Extra Well ID B<br>15940D          | Operator<br>BBC                                  | Govt Authority              |
| Well Configuration Type                      | Original KB Elevation (ft)<br>5,865.00 | Ground Elevation (ft)<br>5,843.00 | KB-Ground Distance (ft)<br>22.00   | Regulatory Drilling Spud Date<br>6/12/2011 21:00 | Regulatory Rig Release Date |
| Surface Legal Location<br>NWSE-24-6S-92W-W6M | North/South Distance (ft)<br>1,770.0   | North/South Reference<br>FSL      | East/West Distance (ft)<br>2,448.0 | East/West Reference<br>FEL                       | Lat/Long Datum              |
| Latitude (°)                                 | Longitude (°)                          | Basin<br>Piceance                 | Field Name<br>Gibson Gulch         | County<br>GARFIELD                               | State/Province<br>CO        |

### Wellheads

| Type<br>"IC-2-BP"API3000 SOW |      |       |          |         |              |                               |
|------------------------------|------|-------|----------|---------|--------------|-------------------------------|
| Des                          | Make | Model | WP (psi) | Service | WP Top (psi) | Top Ring Gasket Bore Min (in) |
|                              |      |       |          |         |              |                               |

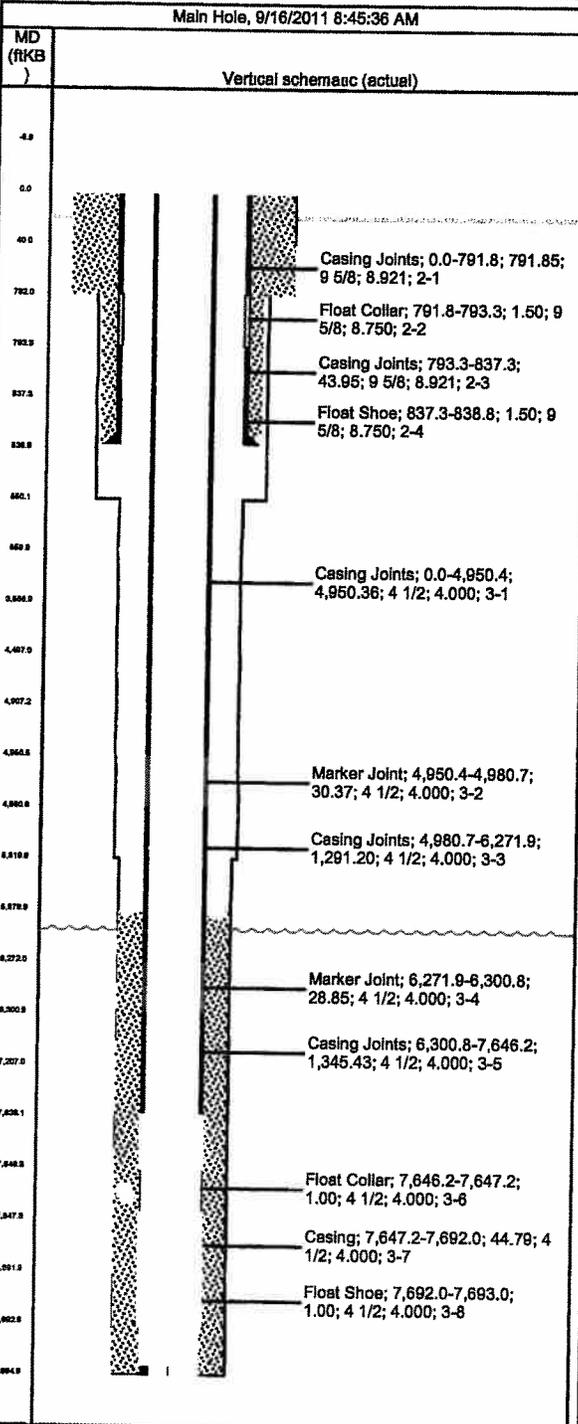

### Casing Strings

| Csg Des    | OD (in) | Wt/Len (lb/ft) | Grade | Top Thread | Set Depth (ftKB) |
|------------|---------|----------------|-------|------------|------------------|
| Conductor  |         |                |       |            | 40.0             |
| Surface    | 9 5/8   | 36.00          | J-55  |            | 838.8            |
| Production | 4 1/2   | 11.60          | E-80  | LT&C       | 7,693.0          |

### Perforation Summary

| Date | Top (ftKB) | Btm (ftKB) | Zone |
|------|------------|------------|------|
|      |            |            |      |

<des> set at <depthbtm>ftKB on <dtmrun>

| Tubing Description | Run Date | String Length (ft) | Set Depth (ftKB) |
|--------------------|----------|--------------------|------------------|
|                    |          |                    |                  |

| Item Des | Jts | Make | Model | OD (in) | Wt (lb/ft) | Grade | Len (ft) |
|----------|-----|------|-------|---------|------------|-------|----------|
|          |     |      |       |         |            |       |          |

<des> on <dtmrun>

| Rod Description | Run Date | String Length (ft) | Set Depth (ftKB) |
|-----------------|----------|--------------------|------------------|
|                 |          |                    |                  |

| Item Des | Jts | Make | Model | OD (in) | Wt (lb/ft) | Grade | Len (ft) |
|----------|-----|------|-------|---------|------------|-------|----------|
|          |     |      |       |         |            |       |          |