

WELL LOCATION CERTIFICATE

SECTION 24, TOWNSHIP 7 NORTH, RANGE 65 WEST, 6TH P.M.


NW CRN SEC. 24
2.5⁺AC LS 12374

NE CRN SEC. 24
2.5⁺AC LS 10855

W1/4 CRN SEC. 24
3.25⁺AC LS 32826

SW CRN SEC. 24
2.5⁺AC LS 12374

SE CRN SEC. 24
2.5⁺AC LS 12374

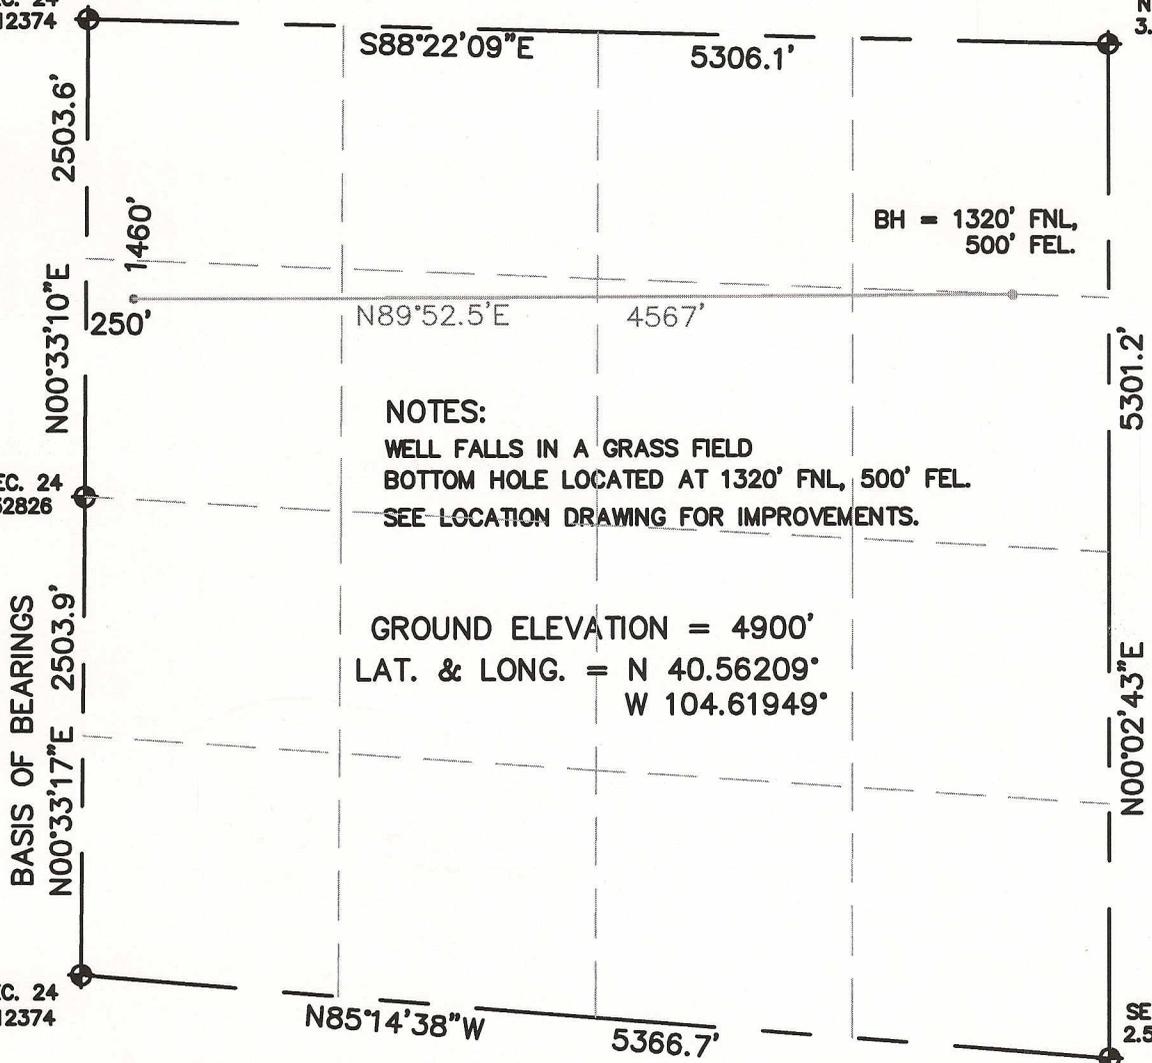

NOTES:


WELL FALLS IN A GRASS FIELD
BOTTOM HOLE LOCATED AT 1320' FNL, 500' FEL.
SEE LOCATION DRAWING FOR IMPROVEMENTS.

GROUND ELEVATION = 4900'
LAT. & LONG. = N 40.56209°
W 104.61949°

I HEREBY STATE TO PETROLEUM DEVELOPMENT CORP. THAT THE SURFACE LOCATION OF THE WELL GREEN 12-24H IS LOCATED AT 1460' FNL & 250' FWL, SEC. 24, T7N, R65W, 6PM.

LEGEND

- = FOUND MONUMENT
- = PROPOSED WELL
- = BOTTOM HOLE

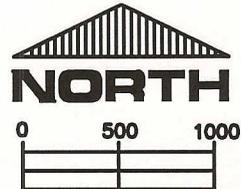


SCALE 1" = 1000'

ELEVATION SOURCE = USGS 7.5' QUAD.MAP CONTOURS NGVD 1929 DATUM.

LAT. & LONG. ARE DIFFERENTIALLY CORRECTED (NAD'83) USING (DGPS) WITH A (PDOP) VALUE OF 2.1.

SHOWN DISTANCES ARE FIELD MEASURED - EXTERIOR SECTION LINES ARE DRAWN TO SCALE (BEST APPROX. OR FOUND MONUMENT).

DISTANCES TO WELL SHOWN PERPENDICULAR TO SECTION LINES.

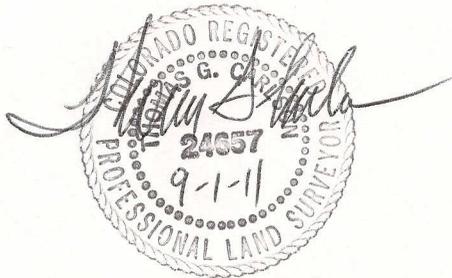

THOMAS G. CARLSON, PLS 24657
HORSESHOE SURVEYING, LLC

THIS IS NOT A MONUMENTED BOUNDARY SURVEY, IT IS ONLY A DRAWING INTENDED TO DEPICT THE WELL LOCATION TO SECTION LINES.

PREPARED BY: HORSESHOE SURVEYING, LLC PO BOX 150458 LAKEWOOD, CO 80215 (720)872-0196		WELL NAME: GREEN 12-24H	
DRAWING DATE: 9-1-11		LOCATION: WELD COUNTY, CO NW1/4, SEC. 24, T7N, R65W, 6TH P.M.	
FIELD DATE: 8-31-11	BY: TGC	CHKD:	JOB NO. SHEET NO. 1 OF 1