


# WELL LOCATION CERTIFICATE

THIS MAP DOES NOT REPRESENT A BOUNDARY SURVEY

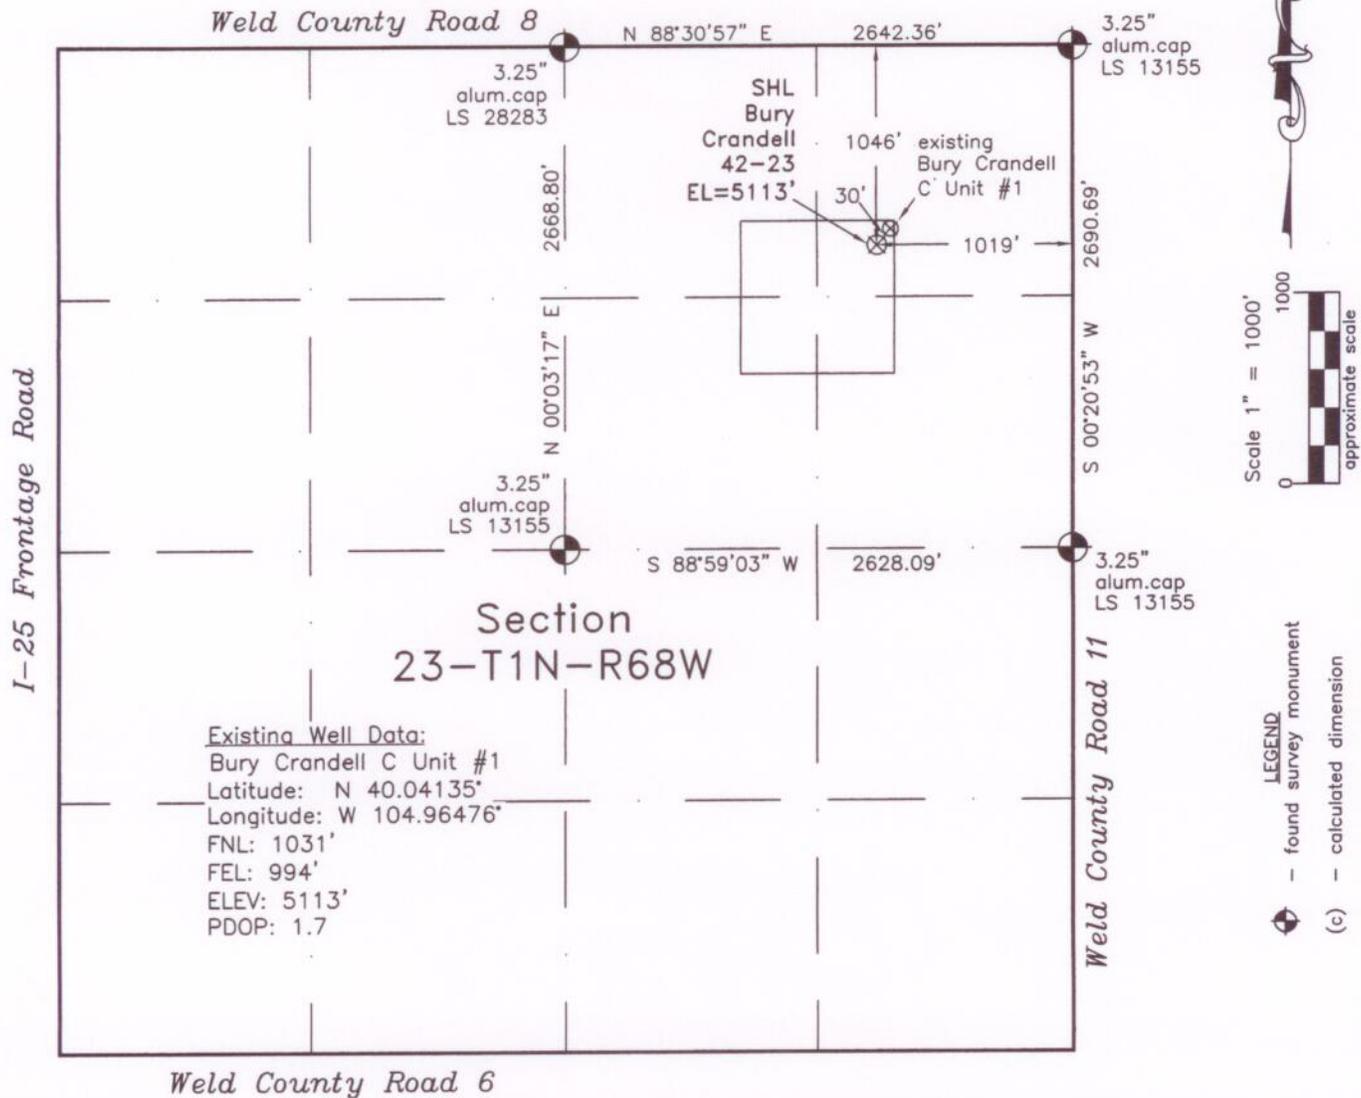

In accordance with a request from Doug Pearlman of EnCana Oil & Gas (USA) Inc., Frederick Land Surveying, Inc. has determined the location of the **Bury Crandell 42-23** well site to be SHL: 1046' FNL and 1019' FEL, as measured at ninety (90) degrees from the section lines of Section 23, Township 1 North, Range 68 West, 6th Principal Meridian, City and County of Broomfield, CO.

- Notes:**
- 1) Bearings and distances based on NAD 83 Colorado North State Plane Coordinates using RTK GPS observations taken 9/28/10 by operator Craig Burke.
  - 2) Conversion factor to ground (1.000280465).
  - 3) Elevations based on NAVD 88 GPS heights and Geoid 2003 corrections.
  - 4) See improvement map for visible improvements within 400 feet of pad site.
  - 5) The location falls on natural ground.

I hereby certify that this Well Location Certificate was prepared by me or under my direct supervision on 9/28/10 for and on behalf of EnCana Oil & Gas (USA) and that it is a Land Survey Plat and that it is not to be relied upon for establishment of fences, buildings, or other future improvement lines.

Alex Ronald Berkins LS#34176  
 Job #: 08088.076 10-6-2010

**NOTICE:** According to Colorado law you must commence any legal action based upon any defect in this W.L.C. within three years after you first discover such defect. In no event may any action based upon any defect in this W.L.C. be commenced more than ten years from this said date of the certification shown hereon.