

T111N, R64W, 6th. P.M.

EOG RESOURCES, INC.

1921 Brass Cap,
0.7' Below Ground
Lat: 40.915006°
Long: 104.485339°

1991 Private Alum.
Cap, LS #16154
0.5' Below Gravel Road
Lat: 40.913381°
Long: 104.502933°

N83°11'17"E - 2454.21' (Meas.)

N83°04'41"E - 2446.13' (Meas.)

2010 UELS Alum.
Cap, RLS #17492,
0.5' Below Road
Lat: 40.914186°
Long: 104.494119°

N00°52'25"E - 5345.93' (Meas.)

S00°01'50"W - 5299.19' (Meas.)

NOTE:
SEE ADDENDUM TO LEGAL PLAT FOR
EXISTING IMPROVEMENTS WITHIN 400'
OF THE PROPOSED WELL DISTURBANCE.

24

(AS-BUILT) LION CREEK #07-24H
Elev. Graded Ground = 5297'

1270'

Brass Cap
Lat: 40.900464°
Long: 104.485322°

Brass Cap
Lat: 40.899653°
Long: 104.494267°

Brass Cap
Lat: 40.898222°
Long: 104.503200°

S83°15'33"W - 2490.38' (Meas.)

S82°10'17"W - 2493.96' (Meas.)

64 63
W W

PDOP = 2.1

NAD 83 (SURFACE LOCATION)

LATITUDE = 40°54'05.15" (40.901431)

LONGITUDE = 104°29'23.70" (104.489917)

NAD 27 (SURFACE LOCATION)

LATITUDE = 40°54'05.21" (40.901447)

LONGITUDE = 104°29'21.85" (104.489403)

STATE PLANE NAD 83 COLORADO NORTH

N: 1572832.71 E: 3279231.72

STATE PLANE NAD 27 COLORADO NORTH

N: 572830.90 E: 2279381.21

LEGEND:

— = 90° SYMBOL

● = PROPOSED WELL HEAD.

▲ = SECTION CORNERS LOCATED.


Well location, (AS-BUILT) LION CREEK #07-24H,
located as shown in the SW 1/4 SE 1/4 of
Section 24, T11N, R64W, 6th. P.M., Weld County,
Colorado.

BASIS OF ELEVATION

SPOT ELEVATION AT THE NORTHEAST CORNER OF SECTION
1, T11N, R63W, 6th. P.M. TAKEN FROM THE HEREFORD,
QUADRANGLE, COLORADO, WELD COUNTY, 7.5 MINUTE QUAD
(TOPOGRAPHIC MAP) PUBLISHED BY THE UNITED STATES
DEPARTMENT OF THE INTERIOR, GEOLOGICAL SURVEY. SAID
ELEVATION IS MARKED AS BEING 5352 FEET.

BASIS OF BEARINGS

BASIS OF BEARINGS IS A G.P.S. OBSERVATION.

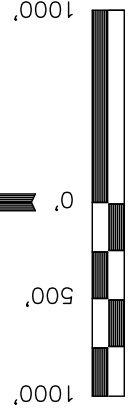

S C A L E

CERTIFICATE

THIS IS TO CERTIFY THAT THE ABOVE PLAT WAS PREPARED FROM
FIELD NOTES OF ACTUAL SURVEYS MADE BY ME OR UNDER MY
SUPERVISION AND THAT THE SAME ARE TRUE AND CORRECT TO THE
BEST OF MY KNOWLEDGE AND BELIEF.

REGISTERED LAND SURVEYOR
REGISTRATION NO. 17492
STATE OF COLORADO 09-01-11

REV: 08-31-11 J.J.

UINTAH ENGINEERING & LAND SURVEYING

85 SOUTH 200 EAST - VERNAL, UTAH 84078

(435) 789-1017

SCALE 1" = 1000' DATE SURVEYED: 11-3-10 DATE DRAWN: 11-4-10

PARTY G.M. J.R. J.I. REFERENCES G.L.O. PLAT

WEATHER WARM FILE

EOG RESOURCES, INC.